Gerred Submittals Cinity Map

The following items are required and will be provided as a deferred submittal:

1. Automatic Fire Sprinkler System. 2. Fire Alarm System.

Automatic Fire Sprinkler System & Fire Alarm System submittal documents for deferred submittal shall be submitted to the local fire district, who shall review them and forward them to the building official, with a notation indicating that the deferred submittal documents have been reviewed and that they have been found to be in general conformance with the design of the building. The deferred submittal items shall "NOT" be installed until their design and submittal documents have been approved by the fire marshal having jurisdiction.

Project Description

JSC CONTRACTING INTENDS TO BUILD A 12,000 S.F. METAL BUILDING ON THEIR EXISTING PROPERTY. EIGHT SUITES WILL BE PROVIDED TO BE LEASED OUT FOR LIGHT INDUSTRIAL USE. TWO EXTERIOR ENTRANCE SINGLE USER RESTROOMS WILL BE PROVIDED AS WELL AS A JANITOR CLOSET. A 12,000 S.F. BUILDING EXISTS ON THE PROPERTY THAT WAS COMPLETED IN 2023.





PARKING CALCULATIONS

LIGHT MANUFACTURING 12,000 SF / 500 = 24 PARKING

Caphic Standards

EXISTING

PROPOSED

DOOR

DOOR

TOTAL PARKING SPACES REQUIRED =24 TOTAL PARKING SPACES PROVIDED = 26

Roject Information Seet Index

6601 Inter Cal Way

Prepared by: W. Alan Kenson & Associates, P.C. P.O. Box 11593 Prescott, AZ 86304

Prescott, AZ 86301

Contractor: JSC Contracting LLC 6601 Inter Cal Way Prescott, AZ 86301

Jobsite Address: 6601 Inter Cal Way Prescott, AZ 8630² Parcel Number: 103-50-054D

Lot Area: 3.33 Acres Zoning:

Current Code: 2018 International Building Code

Proposed Building 12,000 S.F.

Occupancy: F1 / S1 Factory Industrial Moderate Hazard / Storage

Construction Type: Type II-B

Code Analysis

OCCUPANCY

BUILDING AREA

PROPOSED HEIGHT

ALLOWABLE STORIES

PROPOSED STORIES

OCCUPANT LOAD

CONSTRUCTION TYPE

FIRE PROTECTION SYSTEMS

EGRESS EXITS REQUIRED

EGRESS EXITS PROVIDED

OCCUPANCY SEPARATION

PARKING REQUIRED

PARKING PROVIDED

ALLOWABLE BUILDING AREA

ALLOWABLE BUILDING HEIGHT

ARCHITECTURAL

Contact: Jim Simpson

Contact: Alan Kenson

waka@cableone.net

Contact: Jim Simpson

jim@jsccontracting.com

iim@isccontracting.com

(928) 713-5999

928-443-5812

(928) 713-5999

Cover Sheet / Project Information Occupancy / Egress and Code Summary Civil Cover Sheet

Standard Details Existing Site Survey Map Project Summary Map C5 Site Cross Sections Grading, Drainage and Utility Plan GSN and Retaining Wall Details

General Notes

Architectural Site Plan Site Details Reference / Wall Types Floor Plan

A1.1 Dimension Floor Plan Reflected Ceiling Plan / Ceiling Framing Plan A2.0 A3.0 Roof Plan

A4.0 **Building Sections** Exterior Elevations **Enlarged Plans and Interior Elevations**

Door and Window Schedule & Types Room Finish Plan, Materials Schedule A9.0

STRUCTURAL

General Structural Notes Typical Details T-Series S1.2 More Typical Details T-Series Foundation Plan S3

Roof Framing Plan Structural Framing Elevations Foundation Details 100 Series Framing Details 200 Series

Mechanical Floor Plan Mechanical Schedules and Details

PLUMBING

Plumbing Floor Plan Plumbing Schedules Plumbing Schematics Plumbing Schematics

ELECTRICAL

Electrical Symbols, Specifications, One-Line Diagram & Notes Electrical Site Plan

Lighting and Power Floor Plan Permit #: **SHELL BUILDING - NO METERS**

NO OCCUPANCY WITH THIS PERMIT CERTIFICATE OF COMPLETION ONLY, EACH TENANT OR OWNER MUST HAVE A PRE-APPLICATION MEETING AND PULL A SEPARATE PERMIT FOR OCCUPANCY

ENGINEERING ATTACHED AS PART OF THESE PLANS

VABOR BARRIER REQUIRED 6 MIL VAPOR BARRIER REQUIRED UNDER HABITABLE SLABS.

Architect:

Factory Industrial / Storage

ALARM AND SPRINKLERS

PER FEDERAL AVIATION REGULATIONS

62,000 SPRINKLED

W. Alan Kenson & Associates, P.C.

P 928-443-5812 F 928-443-5815

23

24

P.O. Box 11593 Prescott, AZ 86304

email: waka@cableone.net www.kenson-associates.com

ARCHITECTURE & PLANNING

COMMERCIAL FIRE SPRINKLER AND FIRE ALARM PLANS ARE REQUIRED They can be a deferred submittal. Sprinkler and Alarm plans must be submitted at the same time and approved prior to the Building Footer

CITY OF PRESCOTT PERMIT Accepted date:

This set of plans has been reviewed for Code Compliance, accepted, and released for construction. A 'City of Prescott' stamped, paper copy of all plans, corresponding permit, supplemental documents, russes, and reports must be kept at the construction site, during working hours and made available for nspection(s). Field revisions and/or revisions to plans may require additional plan review. Plan acceptance and release for construction shall not prevent correction of errors in the plans where such errors are subsequently found to be in violation of any law or of any ordinance.

This acceptance and release for construction, does not relieve applicant from code compliance to obtain applicable Extension Agreements, Warranties, Certificate of Occupancy, Certificate of Completion, or Final on permitted project. Final Release is contingent upon favorable field inspections under current City of Prescott's adopted City Code, LDC, GES, IBC, IRC, IFC, IFGC, IPC, IMC, ADA, NEC, and other applicable codes of

PLANS REVIEWED FOR CODE COMPLIANCE, ACCEPTED AND RELEASED FOR CONSTRUCTION



REVISIONS City of Prescott Comments

These drawings are the property of W. Alan Kenson & Associates P.0 and may not be reproduced in any way without the written consent of

DRAWN B' L.O. CHECKED BY W.A.K. July 31st, 2024

GRID LINE DESIGNATOR **REVISION DESIGNATOR ELEVATION DESIGNATOR**

DESCRIPTIVE NOTE DESIGNATOR ROOM NUMBER / FINISH DESIGNATOR DOOR NUMBER DESIGNATOR

DETAIL DESIGNATOR

BUILDING SECTION DESIGNATOR

DOOR TYPE DESIGNATOR

WINDOW TYPE DESIGNATOR

WALL TYPE DESIGNATOR

Pumbing Calculations

OCCUPANCY CLASSIFICATION	OCCUPANCY COUNT	WATER CLOSETS	LAVATORIES	DRINKING FOUNTAINS	SERVICE SINK
BUSINESS/LIGHT INDUSTRIAL	23	.92	.57		
TOTAL REQUIRED		1	1	1	1
TOTAL PROVIDED		2	2	1	1

EXIT SIGNS: -

• PROVIDE A 6"x9" BLUE TACTILE, BRAILLE, 'EXIT' SIGN AS MANUFACTURED BY 'SIMPLY EXIT SIGNS (#SE-1980)' OR EQUAL COMPLYING WITH ICC/ANSI A117.1 SECTION 703.1 AND IBC 1013 & SECTION 1111, ADJACENT TO EACH DOOR TO AN EXIT PASSAGEWAY AND THE EXIT DISCHARGE.

FIRE DEPARTMENT NOTES:

- FIRE EXTINGUISHERS SHALL BE PROVIDED IN ACCORDANCE WITH THE INTERNATIONAL FIRE CODE (IFC) AND NFPA 10.
- HAZARDOUS MATERIAL INVENTORY STATEMENTS (HMIS) MUST BE COMPLETED AND SUBMITTED ALONG WITH THE MATERIAL SAFETY DATA SHEETS (MSDS) PROVIDED BY THE MANUFACTURER OF THE PRODUCTS AND MATERIALS FOR ALL HAZARDOUS MATERIALS ONCE THE OCCUPANTS OF THE SUITES ARE IDENTIFIED. THE HMIS FORM MAY BE FOUND ON THE CITY WEB SITE AT WWW.PRESCOTT-AZ.GOV/DOCUMENTS.
- DOOR HARDWARE TO MEET 2018 IFC AND IBC REQUIREMENTS FOR
- PROVIDE ADDRESS NUMBERS IN A POSITION THAT IS PLAINLY LEGIBLE AND VISIBLE FROM THE STREET FRONTING THE PROPERTY. THESES NUMBERS SHALL BE A MINIMUM OF 6 INCHES WITH CONTRASTING BACKGROUND.

Accessibility Notes

- 1. ACCESS TO THESE FACILITIES SHALL BE AT PRIMARY ENTRANCES.
- 2. THE SLOPE OF PUBLIC WALKS SHALL NOT EXCEED A MAXIMUM CROSS SLOPE OF 2%.
- 3. WALKING SURFACES GREATER THAN 2% SHALL BE SLIP
- 4. PROVIDE A 44"x60" MINIMUM LANDING ON THE STRIKE SIDE OF THE ENTRANCE DOOR WITH 44" MINIMUM WIDTH IN THE DIRECTION OF TRAVEL.
- 5. WALLS SHALL EXTEND 18" TO THE SIDE OF THE STRIKE EDGE OF A DOOR OR GATE THAT SWINGS TOWARDS THE OCCUPANT.
- 6. RAMPS SHALL HAVE A NON-SLIP SURFACE.
- 7. RAMPS SHALL BE A MINIMUM OF 36" WIDE.
- 8. EVERY REQUIRED EXIT DOORWAY SHALL BE SIZED FOR A DOOR NOT LESS THAN 36" WIDE BY NOT LESS THAN 6'-8" HIGH CAPABLE OF OPENING 90 DEGREES AND MOUNTED SO THE CLEAR WIDTH OF THE EXIT WAY IS 32" MINIMUM.
- 9. THRESHOLDS TO BE A MAXIMUM OF 1/4" ABOVE ADJACENT FLOOR FINISH. ONE-HALF INCH THRESHOLD MAY BE USED IF BEVELED PER A.D.A. STANDARDS.
- 10. MAXIMUM EFFORT TO OPERATE A DOOR SHALL NOT EXCEED 5 POUNDS.
- 11. THE BOTTOM 10 INCHES OF ALL DOORS EXCEPT AUTOMATIC AND SLIDING DOORS SHALL HAVE A SMOOTH UNINTERRUPTED SURFACE.
- 12. PROVIDE LEVER TYPE HARDWARE, PANIC BARS, PUSH AND PULL ACTIVATING BARS, OR OTHER HARDWARE DESIGNED TO PROVIDE PASSAGE WITHOUT REQUIRING THE ABILITY TO GRASP THE OPENING HARDWARE. (30" TO 44" A.F.F.)

Deress Legend:

..... EXIT ACCESS

ACCESSORY USE (NO OCCUPANCY)

XX ROOM OCCUPANCY LOAD

SUBTOTAL OCCUPANCY LOAD

XX XX

XX

OCCUPANCY TOTAL REQUIRED EXIT WIDTH (FACTOR = 0.15) PROVIDED EXIT WIDTH

WORST CASE TRAVEL DISTANCE

OCCUPANT LOAD FACTOR

WAREHOUSE

500 GROSS


Ocupant load

FUNCTION OF SPACE

GROSS SQUARE FOOTAGE LISTED BELOW DOES NOT INCLUDE ACCESSORY AREAS.

WAREHOUSE AREA

11,491 SQ. FT. 23 OCCUPANTS

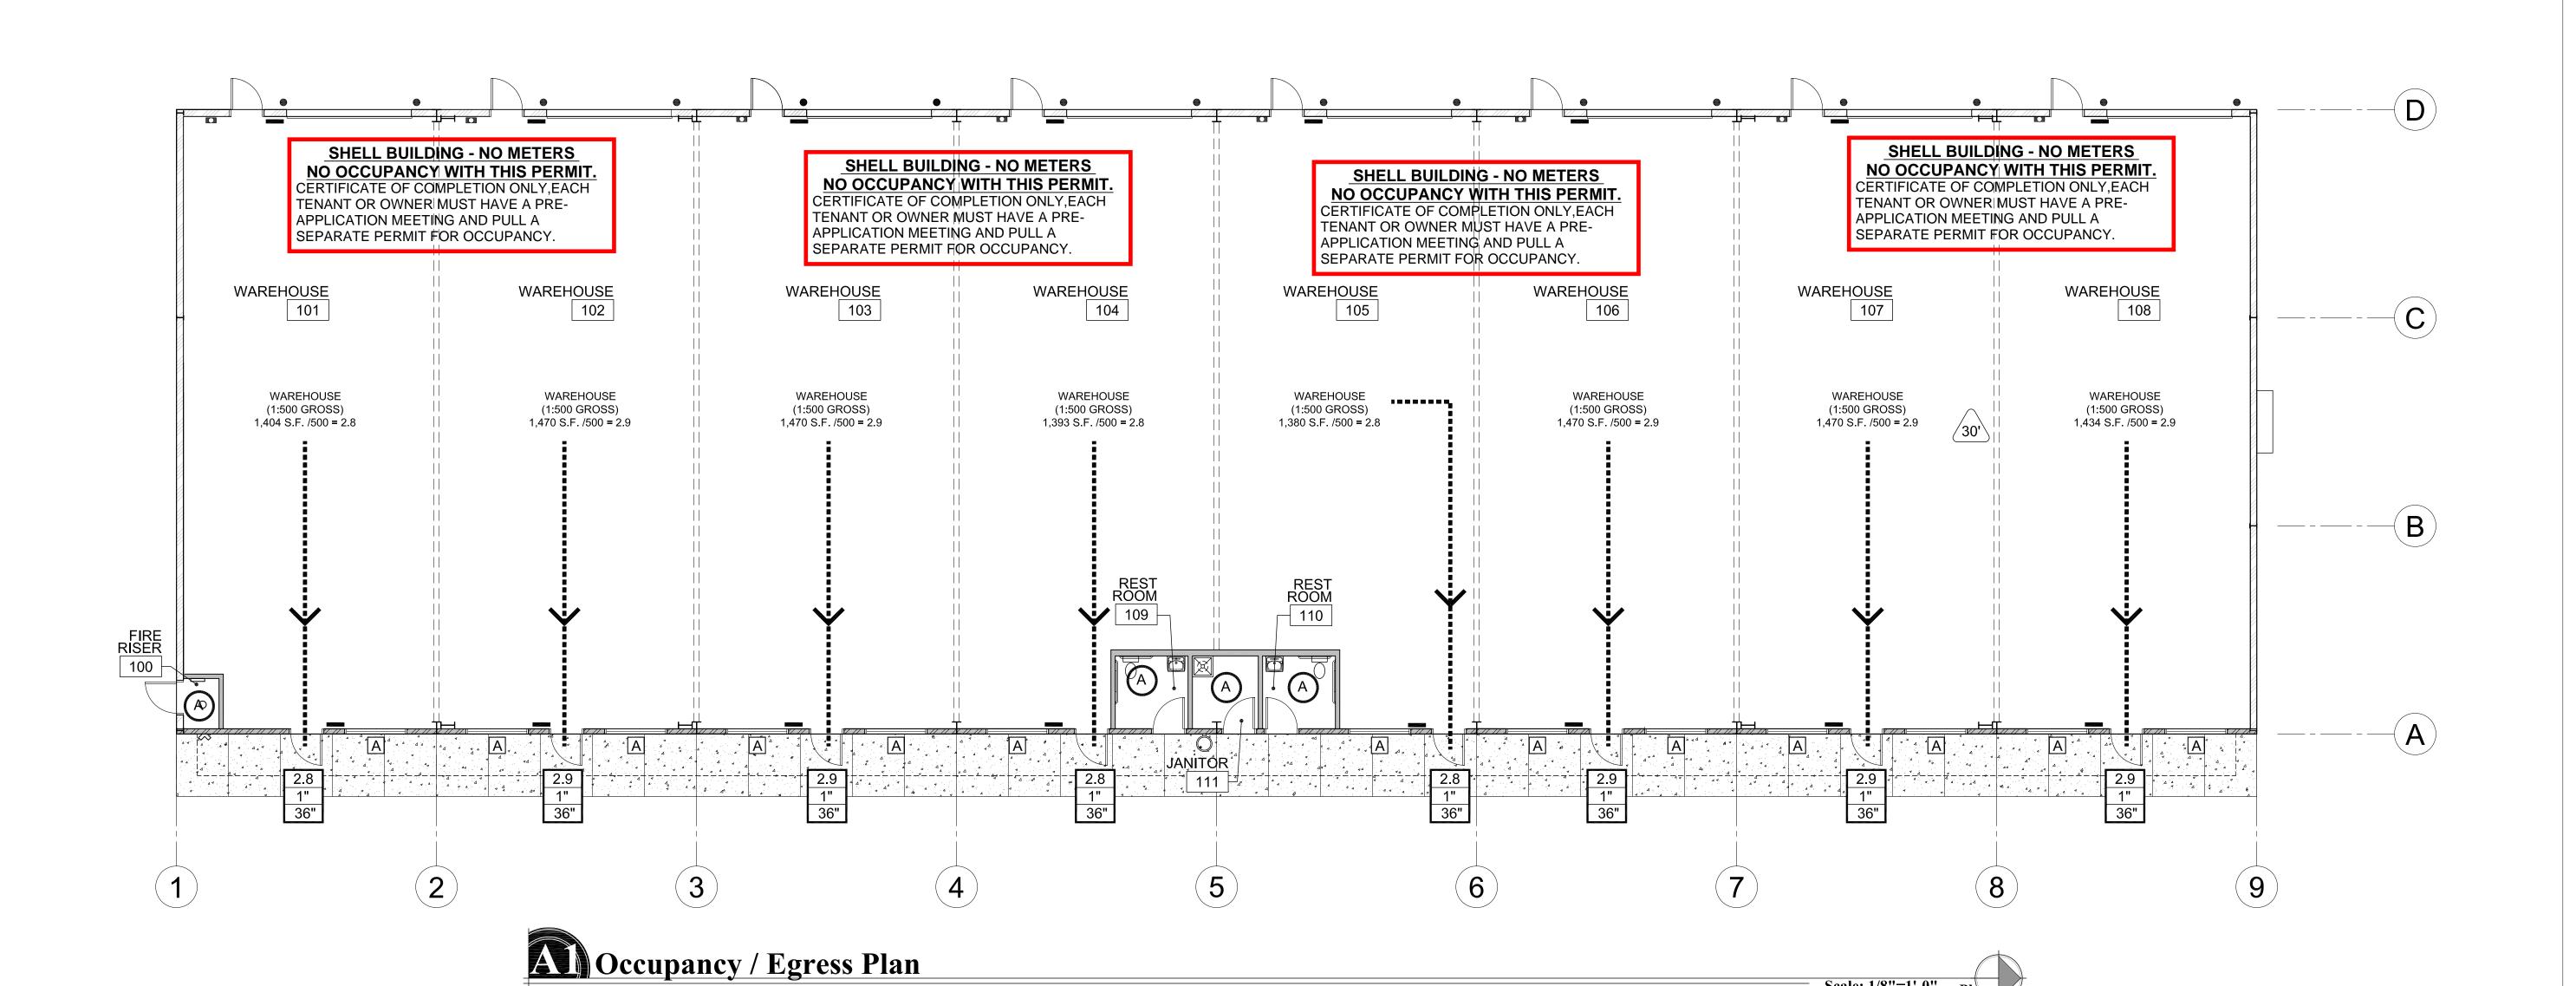

ates

REVISIONS

These drawings are the property of W. Alan Kenson & Associates P.C.,

and may not be reproduced in any


way without the written consent of

W. Alan Kenson & Associates, P.C.

DRAWN BY L.O. CHECKED BY W.A.K. July 31st, 2024

JOB NO. **799** SHEET

APN: 103-50-054D, PRESCOTT AIRPARK UNIT 9 REPLAT 1 LOTS 67-68 SITUATED IN A PORTION OF SECTION 30, TOWNSHIP 15 NORTH, RANGE 1 WEST GILA AND SALT RIVER MERIDIAN CITY OF PRESCOTT, YAVAPAI COUNTY, ARIZONA

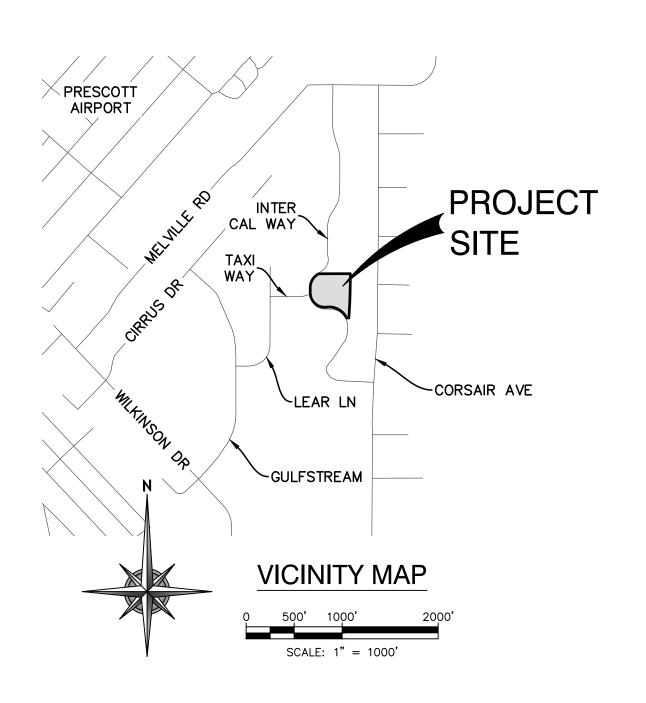


UTILITY CONTACT INFORMATION						
UTILITY	COMPANY	CONTACT	PHONE			
ELECTRIC/POWER	ARIZONA PUBLIC SERVICE 6672 CORSAIR AVENUE PRESCOTT, AZ 86301	MONIQUE HOLLIDAY	(928) 443-6612			
PHONE/COMMUNICATION	CENTURYLINK 1445 MASONRY WAY PRESCOTT, AZ 86301	DELL HOWARD	(928) 649-9318			
NATURAL GAS	UNISOURCE 6405 WILKINSON DRIVE PRESCOTT, AZ 86301	MALI ROSS	(928) 771-7227			
CABLE TELEVISION	SPARKLIGHT 3801 TOWER ROAD PRESCOTT, AZ 86305	DOUG HAMILTON	(928) 443-3305			
WATER & SEWER	CITY OF PRESCOTT 433 N VIRGINIA STREET PRESCOTT, AZ 86301	GWEN ROWITSCH	(928) 777-1130			



FLOODPLAIN NOTE

THIS PROJECT IS LOCATED ON FEMA FLOOD INSURANCE RATE MAP (FIRM) 04025C1693H, EFFECTIVE MARCH 6, 2018 AND IS NOT IMPACTED BY THE FEMA DELINEATED 100-YR FLOODPLAIN.

PROJECT BASIS OF BEARING								
THE BASIS OF BEARING FOR THIS PROJECT IS N32°06'48"E A DISTANCE OF 157.51 FEET ALONG THE CHORD FOR THE NORTHWESTERLY RIGHT OF WAY CURVE FOR THE FORMER LOT 68 BETWEEN TWO 1/2" REBARS WITH CAP RLS 22752								
REFERENCE MARK	NORTHING	EASTING	ELEVATION (88)					
RM 1	627719.156	620712.897	5025.189					
RM 2	627852.685	620796.701	5026.217					
THE COORDINATES AS DEPICTED HEREON REFLECT THE CITY OF PRESCOTT COORDINATE SYSTEM AS PUBLISHED BY THE CITY OF PRESCOTT AND AVAILABLE ON THEIR WEBSITE.								

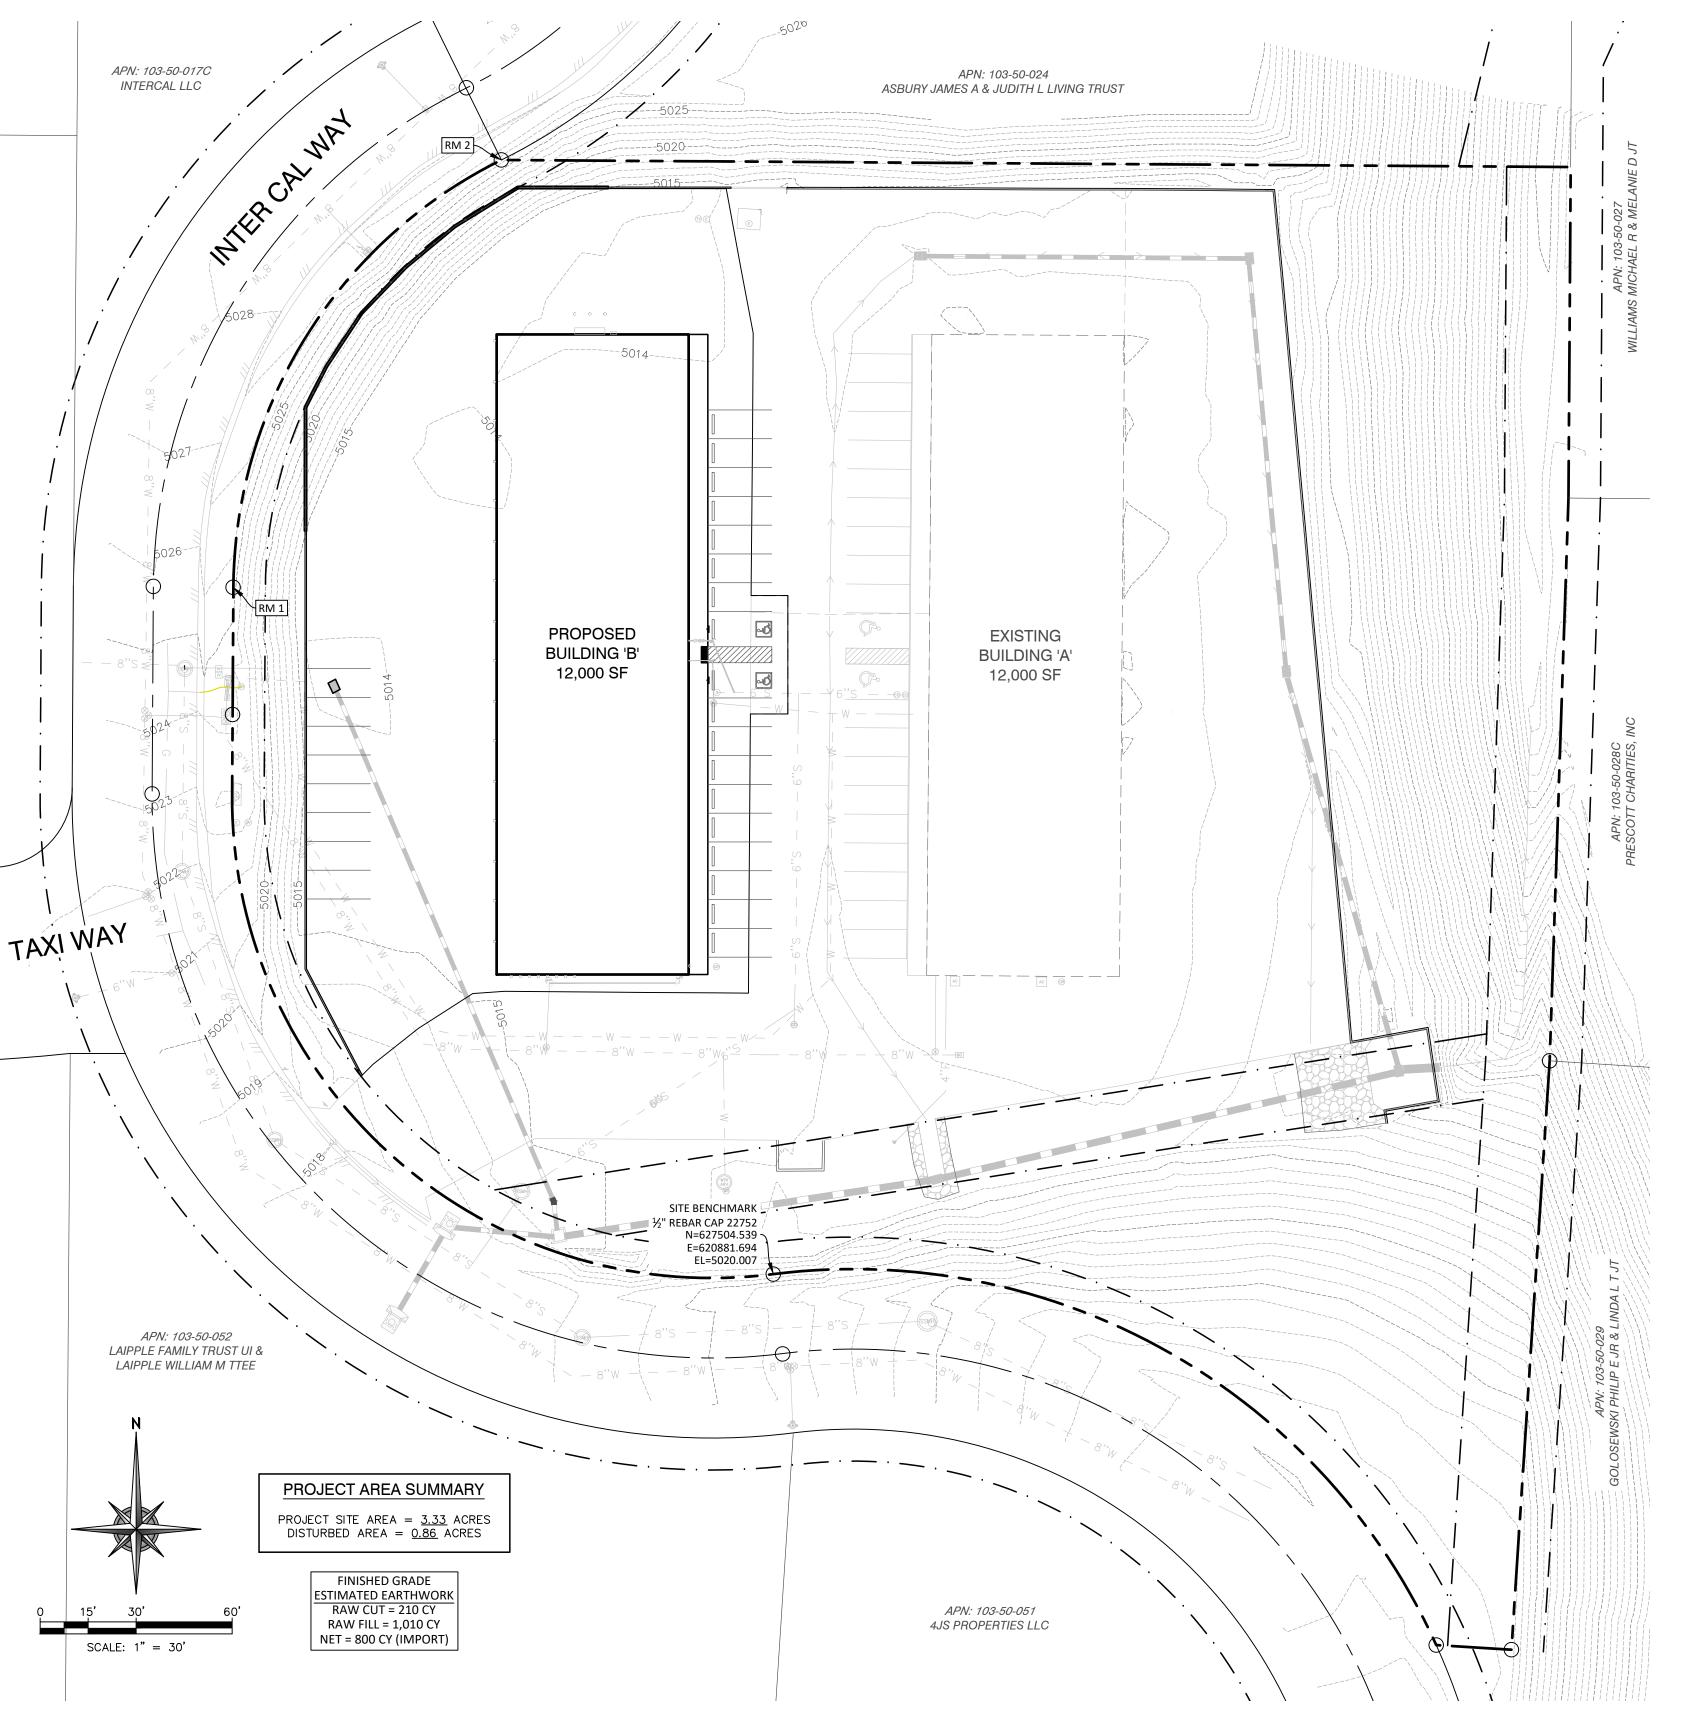

LOCATION MAP

PROJECT OWNER

JSC CONTRACTING, INC 230 N. McCORMICK STREET PRESCOTT, ARIZONA 86301

ARCHITECT

W. ALAN KENSON & ASSOCIATES, P.C. P.O. BOX 11593 PRESCOTT, ARIZONA 86304 (928) 443-5812



1981 COMMERCE CENTER CIRCLE, SUITE B PRESCOTT, ARIZONA 86301 (928) 717-0171 CONTACT: BEN B. HUZA, P.E. GBE PROJECT #20113

STRUCTURAL ENGINEER

SIMPLY STRUCTURAL, INC. 730 N. 52nd STREET, SUITE 105 PHOENIX, ARIZONA 85008 (602) 443-0303

SHEET INDEX					
NUMBER	SHEET	SHEET TITLE			
1	C1	COVER			
2	C2	GENERAL NOTES			
3	СЗ	STANDARD DETAILS			
4	C4	EXISTING SITE SURVEY MAP			
5	C5	PROJECT SUMMARY MAP			
6	C6	SITE CROSS SECTIONS			
7	C7	GRADING, DRAINAGE, & UTILITY PLAN			
8	C8	GSN AND RETAINING WALL DETAILS			

APPROVED BY

CITY ENGINEER	DATE
UTILITIES MANAGER	 DATE



AS-BUILT CERTIFICATION I HEREBY CERTIFY, TO THE BEST OF MY KNOWLEDGE, INFORMATION AND BELIEF, THAT THIS PROJECT HAS BEEN COMPLETED IN SUBSTANTIAL CONFORMANCE WITH THE APPROVED PLANS, SPECIFICATIONS AND REFERENCED STANDARDS, EXCEPT AS SHOWN HEREON; THAT THESE AS-BUILT PLANS REFLECT THE POSITION OF CONSTRUCTED IMPROVEMENTS BASED ON FIELD MEASUREMENTS; AND THAT THE MATERIALS USED IN CONSTRUCTION ARE AS SHOWN BASED ON FIELD OBSERVATION AND TEST RESULTS.

2 COMMENTS

REVISIONS

COP ROUND 1 COMMENTS

These drawings are the property of W. Alan Kenson & Associates P.C., and may not be reproduced in any way without the written consent



CHECKED BY TS/BH DATE December 4, 2024

JOB NO. **799** SHEET

REVISED: DETAIL No. 101P 07/16

1. ALL WORK SHALL CONFORM TO MARICOPA ASSOCIATION OF GOVERNMENTS (MAG), & CITY OF PRESCOTT (COP) CONSTRUCTION STANDARDS & SPECIFICATIONS, WHICH ARE ON FILE IN THE OFFICE OF THE CITY ENGINEER.

2. ALL EXISTING FRAMES, COVERS, VALVE BOXES, & MANHOLES SHALL BE EITHER REPLACED OR ADJUSTED TO FINISH GRADE DEPENDING ON PLAIN CALL OUT UPON COMPLETION OF PAYING, UTILITY, OR RELATED CONSTRUCTION.

3. ANY OLDANTITIES SHOWN ON PLANS ARE NOT VERIFIED BY THE PUBLIC WORKS UTILITIES DISTORY OF THE COMPLETED WORK WILL NOT BE GIVEN UNTIL 3 MIL MYLAR & COOFDINATES HAVE BEEN SUBMITTED & SEALED BY A REGISTERED PROFESSIONAL ENGINEER AND APPROVED BY THE PUBLIC WORKS DEPARTMENT.

5. CITY OF PRESCOTT PUBLIC WORKS UTILITIES SHALL BE NOTIFIED A MINIMUM OF 24 HOURS PRIOR TO THE STANT OF ANY WORK.

6. ALL WORK & MATERIALS WHICH DO NOT CONFORM TO THE SPECIFICATIONS ARE SUBJECT TO REMOVAL & REPLACEMENT AT THE CONTRACTOR'S EXPENSE.

7. AMISTORY OF THE STANDARD WHICH THE WORK OF THE SPECIFICATIONS ARE SUBJECT TO REMOVAL & REPLACEMENT AT THE CONTRACTOR'S EXPENSE.

8. THE CONTRACTOR'S SHALL PROVIDE SUFFICIENT MEN. EQUIPMENT, & MATERIAL ON THE JOB AT ALL TIMES DURING CONSTRUCTION TO COMPLY WITH SPECIFICATIONS & TO COMPLETE THE WORK.

9. CIP INSPECTION TO BE DONE BY THE CITY OF PRESCOTT PUBLIC WORKS DEPARTMENT OR THEIR REPRESENTATIVE. PRIVATE DEVELOPMENTS SHALL PROVIDE FOR INSPECTION TO BE DONE BY THE CITY OF PRESCOTT PUBLIC WORKS DEPARTMENT OR THEIR REPRESENTATIVE. PRIVATE DEVELOPMENTS SHALL PROVIDE FOR INSPECTION TO BE DONE BY THE CITY OF PRESCOTT PUBLIC WORKS DEPARTMENT OR THEIR REPRESENTATIVE. PRIVATE DEVELOPMENTS SHALL PROVIDE FOR INSPECTION TO BE DONE BY THE CITY OF PRESCOTT PUBLIC WORKS DEPARTMENT OR THEIR REPRESENTATIVE. PRIVATE DEVELOPMENTS SHALL PROVIDE FOR INSPECTION TO BE DONE BY THE CITY OF PRESCOTT PUBLIC WORKS DEPARTMENT OR THEIR REPRESENTATIVE. PRIVATE DEVELOPMENTS SHALL BY NO ADVANCE OF CONSTRUCTION AND ADVANCE OF CONSTRUCTION AND ADVANCE OF CONSTRUCTION ON THE SHALL BE SHALL BY ONE SHALL BE CONTRUCTION ON THE SHALL BY ONE SHALL 25. ALL MATERIALS & PRODUCTS THAT COME INTO CONTACT WITH DRINKING WATER OR DRINKING WATER TREATMENT CHEMICALS MUST COMPLY WITH NSF STANDARD 61. ANY 'OR EQUAL' SUBSTITUTION SHALL ALSO MEET NSF STANDARD 61.

26. ALL TRENCHES & BEDDING SHALL BE PER COP DETAIL 200P & TECHNICAL SPECIFICATIONS.

27. ALL MATERIALS USED IN THE INSTALLATION OF WATER MAINS SHALL BE PURSUANT TO AAC R—18—4 & SHALL BE NSF APPROVED FOR POTABLE WATER.

28. ALL REVISIONS TO ORIGINAL PLANS MUST BE APPROVED BY THE PUBLIC WORKS DIRECTOR PRIOR TO CONSTRUCTION.

29. ALL DUCTILE IRON, COPPER, & BRASS FITTINGS SHALL BE ENCASED IN POLYETHYLENE PROTECTIVE WRAPPING IN ACCORDANCE WITH MAG SECTION 610.5 UNLESS COUNTERINDICATED BY GEOTECHNICAL CORROSIVITY TESTING OF BEDDING AND SHADING MATERIALS & APPROVED BY THE PUBLIC WORKS DIRECTOR.

30. WATER LINES SHALL BE INSTALLED WITH MECHANICAL RESTRAINTS WHERE JOINT RESTRAINTS IS REQUIRED.

31. WATER SERVICE INTERRUPTION NOTICES SHALL BE GIVEN TO AFFECTED RESIDENTS BY THE CONTRACTOR AT HIS EXPENSE. ADVANCE NOTIFICATION REQUIREMENTS MUST BE APPROVED BY THE PUBLIC WORKS DIRECTOR TO SCHEDULING A SHUTDOWN. 32. WATER MAIN TAPS, SERVICE TAPS, SHUTDOWN REQUESTS, AND METER REQUESTS MUST BE INITIATED WITH THE CITY INSPECTOR A MINIMUM OF 5 WORKING DAYS IN ADVANCE. I REVISED: IDETAIL No. COP STANDARD DETAIL WATER PLAN GENERAL NOTES 07/16

ALL WORK SHALL CONFORM TO MARICOPA ASSOCIATION OF GOVERNMENTS (MAG), & CITY OF PRESCOTT (COP) CONSTRUCTION STANDARDS & SPECIFICATIONS, WHICH ARE ON FILE IN THE OFFICE OF THE CITY ENGINEER. ALL EXISTING FRAMES, COVERS, VALVE BOXES, & MANHOLES SHALL BE EITHER REPLACED OR ADJUSTED TO FINISH GRADE DEPENDING ON PLAN CALL OUT UPON COMPLETION OF PAVING, UTILITY, OR RELATED CONSTRUCTION. ANY QUANTITIES SHOWN ON PLANS ARE NOT VERIFIED BY THE PUBLIC WORKS UTILITIES DIRECTOR. . SEWER MANHOLES EXFILTRATION TESTS SHALL BE DONE ON 100% OF ALL MANHOLES. VACUUM TESTING IN ACCORDANCE WITH CITY STANDARDS MAY BE USED IN LIEU OF EXFILTRATION TEST. THE CONTRACTOR SHALL TEST EACH MANHOLE USING ONE OF THE FOLLOWING TEST PROTOCOLS:

24A. WATERTIGHTNESS TESTING BY FILLING THE MANHOLE WITH WATER. THE CONTRACTOR SHALL ENSURE THAT THE DROP IN WATER LEVEL FOLLOWING PRESOAKING DOES NOT EXCEED 0.00034 OF THE TOTAL MANHOLE VOLUME PER HOUR. CONTRACTOR SHALL ENSURE THAT THE DROP IN WATER LEVEL FOLLOWING PRESOAKING DOES NOT EXCEED 0.00034 OF THE TOTAL MANHOLE VOLUME PER HOUR.

24B. NEGATIVE AIR PRESSURE TESTING USING THE "STANDARD TEST METHOD FOR CONCRETE SEWER MANHOLES BY NEGATIVE AIR PRESSURE" (VACUUM) TEST, C1244—02e1(2002), PUBLISHED BY THE AMERICAN SOCIETY FOR TESTING AND MATERIALS. THIS MATERIAL IS INCORPORATED BY REFERENCE & DOES NOT INCLUDE ANY LATER AMENDMENTS OR EDITIONS OF THE INCORPORATED MATERIAL, & MAY BE VIEWED AT THE ARIZONA DEPARTMENT OF ENVIRONMENTAL QUALITY, 1110 W. WASHINKTON, PHOENIX, AZ. 85007, OR OBTAINED FROM THE AMERICAN SOCIETY FOR TESTING & MATERIALS INTERNATIONAL, 100 BAR HARBOR DRIVE, WEST CONSHOHOCKEN, PA. 19428—2959.

25. SEWER LINE DEFLECTION TESTS WITH AN APPROPRIATELY SIZED MANDREL SHALL BE DONE ON 100% OF ALL NON-RIGID PIPE LINES.

26. THE CONTRACTOR SHALL PERFORM A VISUAL INSPECTION OF ALL SEWER MAINS AND LATERALS INSTALLED WITHIN THE CITY'S COLLECTION SYSTEM AFTER COMPLETE BACKFILL AND COMPACTION BUT BEFORE INSTALLING ANY PORTION OF THE PAVEMENT STRUCTURAL SECTION. THE INSPECTION SHALL COMPLY WITH THE CITY'S VIDEO ACCEPTANCE PROCEDURE. THE CONTRACTOR SHALL PROVIDE 72 HOURS ADVANCE NOTICE FOR CITY STAFF TO BE PRESENT DURING THE VIDEO OPERATION AND SHALL PROVIDE THE CITY A VIDEO DVD AND HARD COPY OF THE INSPECTION AND SHALL PROVIDE THE CITY A VIDEO DVD AND HARD COPY OF THE INSPECTION REPORT UPON COMPLETION.

27. COVER EACH SEWER LINE WITH AT LEAST 3 FEET OF EARTH COVER MEETING THE REQUIREMENTS "TRENCH EXCAVATION, BACKFILLING, & COMPACTION" (SECTION 601) REVISED 2004, PUBLISHED BY THE MARICOPA ASSOCIATION OF GOVERNMENTS; & "RIGID PIPE BEDDING FOR SANITARY SEWERS" (WMM 104) REVISED JULY 2002, PUBLISHED BY PIPM ACOUNTY WASTEWATER MANAGEMENT.

28. PRESSURE & LEAKAGE TEST IN ACCORDANCE WITH AWWA—C—600 STANDARD. TEST PRESSURE & LEAKAGE TEST IN ACCORDANCE WITH AWWA—C—600 STANDARD. TEST PRESSURE & LEAKAGE TEST IN ACCORDANCE WITH AWWA—C—600 STANDARD. TEST PRESSURE & LEAKAGE TEST IN ACCORDANCE WITH AWWA—C—600 STANDARD. TEST ANY QUANTITIES SHOWN ON PLANS ARE NOT VERIFIED BY THE PUBLIC WORKS UTILITIES DIRECTOR.

ACCEPTANCE OF THE COMPLETED WORK WILL NOT BE GIVEN UNTIL 3 MIL MYLAR & CAD FORMAT DIGITAL 'AS—BUILT' PLANS ON CITY OF PRESCOTT SURVEY DATUM & COORDINATES HAVE BEEN SUBMITTED & SEALED BY A REGISTERED PROFESSIONAL ENGINEER AND APPROVED BY THE PUBLIC WORKS DEPARTMENT.

CITY OF PRESCOTT PUBLIC WORKS UTILITIES SHALL BE NOTIFIED A MINIMUM OF 24 HOURS PRIOR TO THE START OF ANY WORK.

ALL WORK & MATERIALS WHICH DO NOT CONFORM TO THE SPECIFICATIONS ARE SUBJECT TO REMOVAL & REPLACEMENT AT THE CONTRACTOR'S EXPENSE.

ANY WORK PERFORMED WITHOUT THE KNOWLEDGE OF THE CITY INSPECTOR OR HIS REPRESENTATIVE IS SUBJECT TO REMOVAL & REPLACEMENT AT THE CONTRACTOR'S EXPENSE. REPRESENTATIVE IS SUBJECT TO REMOVAL & REPLACEMENT AT THE CONTRACTOR'S EXPENSE.

THE CONTRACTOR SHALL PROVIDE SUFFICIENT MEN, EQUIPMENT, & MATERIAL ON THE JOB AT ALL TIMES DURING CONSTRUCTION TO COMPLY WITH SPECIFICATIONS & TO COMPLETE THE WORK.

CIP INSPECTION TO BE DONE BY THE CITY OF PRESCOTT PUBLIC WORKS DEPARTMENT OR THEIR REPRESENTATIVE. PRIVATE DEVELOPMENTS SHALL PROVIDE FOR INDEPENDENT 3RD PARTY INSPECTIONS.

CONTRACTOR TO NOTIFY PROJECT ENGINEER 72 HOURS (3 WORKING DAYS) IN ADVANCE OF CONSTRUCTION TO SCHEDULE CONSTRUCTION CONTROL STAKING.

THE CONTRACTOR IS TO UNCOVER ALL EXISTING LINES BEING THED INTO AND VERIFY GRADES, MATERIAL, SIZE & ELEVATIONS BEFORE COMMENCING CONSTRUCTION & ORDERING MATERIALS.

IT IS THE CONTRACTOR'S RESPONSIBILITY TO LOCATE ALL UNDERGROUND PIPELINES, TELEPHONE & ELECTRICAL CONDUITS & STRUCTURES IN ADVANCE OF ANY CONSTRUCTION & OBSERVE ALL POSSIBLE PRECAUTIONS TO AVOID ANY DAMAGE TO SUCH. THE ENGINEER &/OR OWNER WILL NOT GUARANTEE ANY LOCATIONS AS SHOWN ON THESE PLANS, OR THOSE OMITTED FROM SAME.

CONTRACTOR SHALL NOTIFY 'BLUE STAKE' AT 1—800—STAKEIT (1—800—782—5348) AT LEAST 48 HOURS PRIOR TO CONSTRUCTION.

CONTRACTOR SHALL VERIFY ALL QUANTITIES SHOWN & MAKE HIS BID BASED UPON THOSE VERIFICATIONS. IF ANY DISCREPANCY IN QUANTITIES IS FOUND, THE CONTRACTOR SHALL VERIFY ALL QUANTITIES SHOWN & MAKE HIS BID BASED UPON THOSE VERIFICATIONS. IF ANY DISCREPANCY IN QUANTITIES IS FOUND, THE CONTRACTOR SHALL VERIFY ALL QUANTITIES SHOWN & MAKE HIS BID BASED UPON THOSE VERIFICATIONS. IF ANY DISCREPANCY IN QUANTITIES IS FOUND, THE CONTRACTOR SHALL NOTIFY THE ENGINEER AS SUCH.

ARIZONA DEPARTMENT OF ENVIRONMENTAL QUALITY REQUIREMENTS SHALL APPLY WHEN MORE STRINGENT THAN THE MAG OR CITY OF PRESCOTT STANDARD SPECIFICATIONS FOR PUBLIC WORKS CONSTRUCTION; MORE SPECIFICALLY WHERE THEY PERTAIN TO MAXIMUM ALLOWABLE SEWER LINE/PRESSURE SEWER LINE EXFILTRATION—INFILTRATION TO MAXIMUM ALLOWABLE SEWER LINE/PRESSURE SEWER LINE EXFILTRATION—INFILTRATION TO PROGRESSING. PROGRESSING.
PROJECT CONTRACTOR SHALL BE RESPONSIBLE FOR SUBMITTING TRAFFIC CONTROL
PLANS WHICH SHALL BE MADE A PART OF THE PLAN REVIEW REQUEST TO THE CITY
ENGINEER FOR APPROVAL.
WATER-SEWER SEPARATION SHALL BE PURSUANT TO AAC R-18-5-502C.
ALL TRENCHES & BEDDING SHALL BE PER COP DETAIL 200P & TECHNICAL
SPECIFICATIONS. J. ALL IREVISIONS.

1. ALL REVISIONS TO ORIGINAL PLANS MUST BE APPROVED BY THE PUBLIC WORKS DIRECTOR PRIOR TO CONSTRUCTION. ANY UNAPPROVED REVISIONS ARE SUBJECT TO REMOVAL & REPLACEMENT AT CONTRACTOR'S EXPENSE.

2. SEWER FORCE MAIN LINES SHALL BE DESIGNED AND CONSTRUCTED OF A MATERIAL SUITABLE FOR SANITARY SEWER PRESSURE PIPE AS APPROVED BY THE CITY ENGINEER. SEWER LINES SHALL BE PRESSURE TESTED TO A MINIMUM OF 50 PSI ABOVE DESIGN WORKING PRESSURE AT THE LOWEST POINT IN THE SYSTEM FOR A MINIMUM OF 4 HOURS IN ACCORDANCE WITH AAC R18—9.

3. SEWER LINE LOW PRESSURE AIR TESTS SHALL BE DONE ON 100% OF ALL LINES AFTER PLACEMENT OF BACKFILL TO PAVEMENT SUBGRADE. TEST EACH SEGMENT OF THE SEWER LINE FOR LEAKAGE USING THE APPLICABLE METHOD BELOW AND RECORD THE RESULTS:

23A. "STANDARD TEST METHOD FOR INSTALLATION OF ACCEPTANCE OF PLASTIC S:

"STANDARD TEST METHOD FOR INSTALLATION OF ACCEPTANCE OF PLASTIC GRAVITY SEWER LINES USING LOW-PRESSURE AIR, F1417-92(1998)"
PUBLISHED BY THE AMERICAN SOCIETY FOR TESTING AND MATERIALS. WASTEWATER PLAN REVISED: IDETAIL No **COP STANDARD DETAIL**

BUILDING CODE, AND CITY OF PRESCOTT LAND DEVELOPMENT CODE (REFERENCE CITY OF PRESCOTT STANDARD SECTIONS).

SHALL BE COMPLIED WITH DURING OPERATIONS. THIS PLAN IS FOR GRADING PURPOSES ONLY. APPROVAL OF THIS PLAN DOES NOT CONSTITUTE APPROVAL OF DRIVEWAY LOCATIONS OR SIZES, PARKING LOT LAYOUT, SEWER AND WATER FACILITIES, BUILDING LOCATIONS, OFF-SITE DRAINAGE FACILITIES OR OTHER ITEMS NOT RELATED DIRECTLY TO THE BASIC GRADING OPERATION.

CERTIFICATION FROM THE REGISTERED CIVIL ENGINEER AND SOILS/GEOLOGICAL ENGINEER STATING THAT THE ROUGH GRADING HAS BEEN COMPLETED PER THE APPROVED PLAN, AND A COMPACTION REPORT FROM THE SOILS ENGINEER ON ANY FILL AREAS THAT ARE REQUIRED SHALL BE PROVIDED PRIOR TO BUILDING PERMITS BEING ISSUED. PARTIES NAMED ON ADEQ'S NOTICE OF INTENT (N.O.I.) ARE RESPONSIBLE FOR EROSION, DUST, MUD, SILT, DEBRIS, AND TEMPORARY DRAINAGE CONTROL DURING GRADING OPERATIONS AND MAY BE REQUIRED TO PROVIDE A SWPPP. ANY ON-SITE RETAINING WALLS WILL REQUIRE APPROVAL AS PART OF THESE PLANS. ANY NECESSARY RETAINING WALLS ON THE PERIMETER OF THIS SITE MAY BE REQUIRED TO BE IN PLACE AND APPROVED BY THE CITY BUILDING DEPARTMENT PRIOR TO THE START OF GRADING. AS EPARATE PLAN WITH REQUIRED STRUCTURAL CALCULATIONS MAY BE REQUESTED FOR

BE PROTECTED IN PLACE. IF GRADING OPERATIONS DAMAGE OR ADVERSELY AFFECT SAID ITEMS IN ANY WAY, THE CONTRACTOR AND/OR DEVELOPER IS RESPONSIBLE FOR WORKING OUT AN

THE ENTIRE GRADING SITE IN ACCORDANCE WITH THE GENERAL ENGINEERING PLAN, INCLUDING FILL AREAS OUTSIDE THE BUILDING PADS AND ON ALL FILL SLOPES, AND SHALL BE CERTIFIED BY THE SOIL'S ENGINEER. CITY APPROVAL OF PLANS DOES NOT RELIEVE THE DEVELOPER FROM THE RESPONSIBILITY FOR CORRECTION OR ERROR OR OMISSION DISCOVERED DURING CONSTRUCTION. UPON REQUEST, THE REQUIRED PLAN REVISIONS SHALL BE PROMPTLY SUBMITTED TO THE CITY ENGINEER FOR ARRENDING.

777-1140 FOR ANY REQUIRED CIVIL INSPECTION 24 HOURS PRIOR TO PERFORMING ANY WORK. WORK PERFORMED WITHOUT CALLING FOR INSPECTION MAY BE REJECTED AND, IF REJECTED,

NO GRADING SHALL COMMENCE WITHOUT OBTAINING A GRADING PERMIT AND NOTIFYING THE CITY OF PRESCOTT OR DEVELOPER'S GRADING INSPECTOR TO SCHEDULE A PREGRADING MEETING TWO WORKING DAYS PRIOR TO THE START OF WORK.

PRIOR TO THE START OF GRADING ALL SWPPP MEASURES SHALL BE IN PLACE, ALL DEBRIS FROM THE SITE TO THE SATISFACTION OF THE SOILS ENGINEER.

THE EXPOSED SOILS SHALL THEN BE INSPECTED BY THE SOILS ENGINEER, AND ANY ADDITIONAL OVER-EXCAVATION SHALL THEN BE MADE IN ACCORDANCE WITH THE SOILS ENGINEER'S RECOMMENDATIONS AND AS CONTAINED IN THE SOIL'S REPORT.

THE EXPOSED SOILS SHALL THEN BE SCARIFIED TO PROVIDE A BOND WITH NEW FILL, BROUGHT TO PROPER MOISTURE CONTENT AND COMPACTED TO AT LEAST 90% OF THE MAXIMUM DENSITY, AS DETERMINED BY ASTM D1557-78 OR EQUIVALENT COMPACTION SHALL BE OBTAINED BY METHODS SPECIFIED BY THE SOILS ENGINEER. ROAD PRISM SUBGRADE SHALL BE COMPACTED TO AT LEAST 95% STANDARD OR MODIFIED PER SOILS ENGINEER'S RECOMMENDATIONS.

THE SOILS AND DESIGN ENGINEER OF RECORD SHALL ALSO BE RESPONSIBLE TO INSPECT, VERIFY AND REPORT THAT PROPER COMPACTION HAS BEEN OBTAINED BY EARTHWORK CONTRACTOR OF SUBCONTRACTOR AND PRIVATE UTILITY FRANCHISES CONCERNING UTILITY LINE BACKFILL, TO INCLUDE ELECTRICAL, GAS, CABLE, FIBEROPTIC AND LANDSCAPE IRRIGATION LINES. ADDITIONALLY, WATER AND SEWER LINES TO BE BACKFILLED AND COMPACTED IN ACCORDANCE WITH GENERAL ENGINEERING REQUIREMENTS SECTION AND DETAIL.

GRADING PLAN WITH THE PROPER STAMPS AND SIGNATURES ARE TO BE SUBMITTED TO THE CITY ENGINEER PRIOR TO RELEASE OF GRADING BOND AND PRIOR TO FINAL GRADING INSPECTION. BUILDING PAD CERTIFICATION SHALL BE SUBMITTED TO THE BUILDING DEPARTMENT WHEN DEPOLICE TO.

NO FILL SHALL BE PLACED UNTIL STRIPPING OF VEGETATION, REMOVAL OF UNSUITABLE SOILS, AND INSTALLATION OF SUBDRAINS (IF ANY) HAVE BEEN INSPECTED AND APPROVED BY THE SOILS

ENGINEER MUST SET GRADE STAKES FOR ALL DRAINAGE DEVICES AND OBTAIN INSPECTION GRADING SHALL NOT BE STARTED WITHOUT FIRST NOTIFYING CITY PUBLIC WORKS INSPECTION DEPARTMENT. A PRE-GRADING MEETING ON THE SITE IS REQUIRED BEFORE BEGINNING GRADING ACTIVITIES BY THE FOLLOWING PEOPLE PRESENT: OWNER, GRADING CONTRACTOR, DESIGN CIVIL ENGINEER, SOIL ENGINEER/GEOLOGIST, PUBLIC WORKS INSPECTOR, AND WHEN REQUIRED, THE ARCHAEOLOGIST AND PALEONTOLOGIST. THE REQUIRED INSPECTIONS FOR GRADING WILL BE

EXPLAINED AT THE PRE-CONSTRUCTION MEETING.

CONTRACTOR SHALL PERMANENTLY STABILIZE ALL DISTURBED SLOPES AS STATED ON APPROVED CONSTRUCTION PLANS. ALL EROSION CONTROL STRUCTURES SHALL REMAIN IN PLACE UNTIL EXPOSED SLOPES HAVE BEEN PERMANENTLY STABILIZED. CONTRACTOR SHALL TAKE MEASURES TO PREVENT OR MINIMIZE THE GENERATION,

23. ALL EXISTING FILLS SHALL BE APPROVED AND CERTIFIED BY THE SOILS ENGINEER OR REMOVED PRIOR TO PLACING ADDITIONAL FILLS. THE CONTRACTOR/DEVELOPER IS RESPONSIBLE FOR ENSURING THAT RETAINING WALLS DO NOT INTERFERE WITH PROVISION OF UTILITIES. WALLS MUST BE CONSTRUCTED ON SITE AND OUTSIDE OF THE RIGHT OF WAY. THIS SHALL INCLUDE THE FOOTINGS.

25. THE COMPACTION REPORT AND APPROVALE FROM THE SQUEEN CHARLES SHALL INDICATE.

25. THE COMPACTION REPORT AND APPROVAL FROM THE SOIL ENGINEER SHALL INDICATE THE TYPE OF FIELD TESTING PERFORMED. EACH TEST SHALL BE IDENTIFIED WITH THE METHOD OF OBTAINING THE IN-PLACE DENSITY, WHETHER SAND CONE OR NUCLEAR GAUGE, AND SHALL BE SO NOTED FOR EACH TEST.

26. EXPORT SOIL MUST BE TRANSPORTED TO A LEGAL DUMP OR TO A PERMITTED SITE SHOWN CLEARLY ON APPROVED PLANS.

PERMITTEE SHALL BE HELD LIABLE FOR ANY DAMAGE DUE TO OBSTRUCTING NATURAL DRAINAGE

REVISED: DETAIL No GRADING AND DRAINAGE COP STANDARD DETAIL 105P-1 **NOTES** 07/16 CITY ENGINEER

THE CONTRACTOR SHALL SPOT LAYOUT THE ENTIRE PROJECT AND CONTACT THE CITY INSPECTOR TO MAKE ARRANGEMENTS FOR INSPECTION PRIOR TO INSTALLING TRAFFIC SIGNS OR PAVEMENT MARKINGS. ANY SIGNING OR STRIPING INSTALLED BEFORE LAYOUT APPROVAL SHALL BE SUBJECT TO REMOVAL AND REINSTALLATION AT THE CONTRACTOR'S EXPENSE.

TRAFFIC SIGN DIMENSIONS, COLORS AND LETTERING SHALL CONFORM TO THE LATEST MUTCD SPECIFICATIONS. TRAFFIC SIGN SIZE SHALL BE STANDARD UNLESS OTHERWISE SPECIFIED ON THE PLANS.

SIGN LOCATION SHALL BE COORDINATED WITH LANDSCAPING PLANS TO ENSURE SIGN VISIBILITY PER AASHTO STANDARDS.

ALL RI—1 "STOP" SIGNS AND PEDESTRIAN WARNING SIGNS SHALL BE RETRO—REFLECTIVE WITH SHEFTING MATERIAL TO BE DIAMOND UP GRADE MEETING OR EXCEPTING ASTM ALL R1-1 "STOP" SIGNS AND PEDESTRIAN WARNING SIGNS SHALL BE RETRO-REFLECTIVE WITH SHEETING MATERIAL TO BE DIAMOND VIP GRADE, MEETING OR EXCEEDING ASTM 4956-04.
ALL OTHER SIGNS ARE TO BE RETRO-REFLECTIVE WITH SHEETING MATERIAL TO BE HIGH INTENSITY PRISMATIC MEETING OR EXCEEDING ASTM 4956-04.
SIGN BLANKS SHALL BE 5052-H38 ALLOY TREATED ALUMINUM WITH ALODINE 1200 CONVERSION COATING, 0.080" THICK WITH ROUNDED CORNERS.
SIGNS SHALL BE MOUNTED ON STREET LIGHT POLES WHENEVER FEASIBLE.
STRIPING SHALL CONFORM TO THE MOST RECENT EDITION OF THE MUTCD WITH REGARD TO SIZE, COLOR, REFLECTIVITY AND PLACEMENT UNLESS OTHERWISE SPECIFIED ON THE PLANS. FLANS.
ALL THERMOPLASTIC APPLICATIONS SHALL CONFORM TO ADOT SPECIFICATION 704.
TRANSVERSE MARKINGS, SYMBOLS AND LEGENDS SHALL BE 90 MIL (0.090 INCH) TO LONGITUDINAL MARKINGS SHALL BE 60 MIL (0.060 INCH) THICK ALKYD EXTRUDED THERMOPLASTIC THERMOPLASTIC.

ALL PAINT APPLICATION SHALL CONFORM TO ADOT SPECIFICATION 708.

ALL CONFLICTING STRIPING, PAVEMENT MARKINGS, AND CURB PAINT SHALL BE REMOVED BY WET SANDBLASTING OR OTHER APPROVED METHOD PRIOR TO THE INSTALLATION OF NEW STRIPING. SLURRY OR PAINT SHALL NOT BE USED TO COVER EXISTING PAINT. PAVEMENT THAT IS DAMAGED DUE TO THE REMOVAL OF MAKERS OR STRIPING SHALL BE REPAIRED TO THE SATISFACTION OF THE CITY ENGINEER OR HIS DESIGNEE.

REVISED: DETAIL No. SIGNING AND COP STANDARD DETAIL 106P-1 07/16 STRIPING NOTES

ALL MATERIAL, EQUIPMENT AND INSTALLATION SHALL CONFORM TO THE LATEST MUTCD SPECIFICATIONS; THE ADOT TRAFFIC SIGNAL AND LIGHTING STANDARD DRAWINGS, ADOT STANDARD SPECIFICATIONS FOR ROAD AND BRIDGE CONSTRUCTION, AND THE CITY OF PRESCOTT STANDARD DETAILS.

ALL EQUIPMENT SHALL BE APPROVED BY THE CITY OF PRESCOTT THROUGH THE ELECTRICAL EQUIPMENT SUBMITTAL PROCESS PRIOR TO THE ORDERING OF EQUIPMENT.

THE LOCATION OF EACH NEW POLE FOUNDATION, PULLBOX, CONTROLLER CABINET FOUNDATION, UPS CABINET FOUNDATION AND ELECTRICAL SERVICES PEDESTRAL FOUNDATION SHALL BE MARKED IN THE FIELD AS SHOWN ON THE PLANS. THE EXACT LOCATION SHALL BE APPROVED BY THE CITY TRAFFIC ENGINEER AND/OR APPROVED CITY REPRESENTATIVE BY CONTACTING (928)777–1130 PRIOR TO WORK.

ALL VEHICLE AND PEDESTRIAN COUNTDOWN INDICATIONS SHALL BE LED. PEDESTRIAN COUNTDOWN HEADS SHALL BE PROVIDED AT ALL VEHICULAR SIGNAL LOCATIONS WHENEVER SIDEWALK CONNECTIONS EXIST OR ARE INSTALLED.

ALL PEDESTRIAN PUSH BUTTON ASSEMBLIES SHALL CONFORM TO ADOT STANDARD DRAWINGS TST1-1 EXCEPT THAT THE PUSH BUTTON SHALL BE A MINIMUM OF TWO INCH IN DIAMETER. PUSH BUTTONS MUST MEET ADA REQUIREMENTS AND BE MOUNTED AT ADA HEIGHTS.

ACCESSIBLE PEDESTRIAN SIGNAL SYSTEMS SHALL BE REQUIRED WHEN DIRECTED BY THE CITY TRAFFIC ENGINEER AND/OR APPROVED CITY REPRESENTATIVE.

CONTROLLER CABINET SHALL BE TYPE IV ECONOLITE TS2, TYPE 1 WITH ELEVATOR BASE. PROVISION FOR BATTERY BACK—UP SHALL BE PROVIDED IN ALL TRAFFIC SIGNAL CABINETS.

METER PEDESTRIA CABINET SHALL BE MYERS PBM 2000 OR 1250 UPS W/FOUNDATION OR APPROVED EQUAL.

TRAFFIC SIGNAL PULL BOXES SHALL BE NO. 7 OR NO. 5 AS CALLED FOR ON THE PLANS AND CONFORM TO THE TS 1-4, 1-5 AND 1-5 OF THE ADOT TRAFFIC SIGNALS AND LIGHTING STANDARD DRAWINGS. BOX LIDS SHALL BE LOCKING AND LABELED WITH "TRAFFIC SIGNAL" UNLESS OTHERWINES SPECIFIED BY THE CITY TRAFFIC ENGINEER AND/OR THE APPROVED CITY REPRESENTATIVE. ONLESS CHIERMISE SPECIFIED BY THE CITY TRAFFIC ENGINEER AND/OR THE APPROVED CITY REPRESENTATIVE

ALL CONDUITS SHALL BE SCHEDULE 40 PVC, OF A DIAMETER AS CALLED FOR ON THE APPROVED PLANS.

LOOP DETECTOR SHALL BE SIX (6') FEET BY FIFTY (50') FEET QUADRUPOLE UNLESS OTHERWISE SPECIFIED BY THE CITY TRAFFIC ENGINEER AND/OR THE APPROVED CITY REPRESENTATIVE. ALL VEHICLE DETECTION LOOP CABLES SHALL BE #14 AWG IMSA 50-2-1984 CABLE. NO SPLICE SHALL BE ALLOWED IN THE DETECTION LOOP CABLE EXCEPT AT THE PULLBOX ADJACENT TO THE LOOP. THE DETECTOR LEAD—IN SHALL NOT BE SPLICED.

THE TOP OF THE POLE FOUNDATION SHALL BE LEVEL WITH THE FINISHED GRADE. IF THE SLOPE OR SHOULDER DROPS OFF FROM FINISHED GRADE, THE CONTRACTOR SHALL GRADE AROUND THE POLE FOUNDATION. THE TOP OF THE FOUNDATION SHALL EXTEND NO MORE THAN 4 INCHES ABOVE THE ADJACENT ULTIMATE GRADE.

ALL CONCRETE USED FOR TRAFFIC SIGNAL POLE AND CABINET FOUNDATIONS SHALL BE CLASS "A".

THE CONTRACTOR SHALL CONTRACTOR SHALL BE CLASS
"A".

THE CONTRACTOR SHALL CONTRACTOR SHALL BE CLASS
"A".

THE CONTRACTOR SHALL CONTRACTOR SHALL CONTRACTOR SHALL BE CLASS
"A".

THE CONTRACTOR SHALL CONTRACTOR SHALL CONTRACTOR SHALL BE CLASS
"A".

THE CONTRACTOR SHALL CONTRACTOR SHALL BE CLASS
"A".

THE CONTRACTOR SHALL CONTRACTOR SHALL CONTRACTOR SHALL BE CLASS
"A".

EROSION AND SEDIMENTATION

CONTROL NOTES

A COPY OF THE APPROVED GRADING AND DRAINAGE PLAN FOR THIS PROJECT AND

PREVENTION PLAN (SWPPP) SHALL BE MAINTAINED ON THE SITE AND AVAILABLE FOR REVIEW. THOSE ELEMENTS OF THE GRADING AND DRAINAGE PLAN PERTINENT TO OR

THE ESC/SWPPP AND RELATED RECORDS MUST BE MADE AVAILABLE UPON REQUEST TO

THE IMPLEMENTATION OF THESE PLANS AND THE CONSTRUCTION, MAINTENANCE, REPLACEMENT, AND UPGRADING OF THESE FACILITIES IS THE RESPONSIBILITY OF THE

PERMITTEE/CONTRACTOR UNTIL ALL CONSTRUCTION IS APPROVED AND A NOTICE OF

THE SCHEMATIC EROSION CONTROL MEASURES SHOWN ON THE PLANS ARE A MINIMUM.

THE CONTRACTOR SHALL PROVIDE ALL NECESSARY MEANS TO PROTECT EXISTING FACILITIES AND ADJACENT PROPERTIES FROM NOISE, DUST, AND STORM WATER RUNOFF

ON SITE OR CHANNELED INTO A STORM DRAIN SYSTEM, PROVIDED THAT IT IS FREE

EMISSION AND/OR TRANSPORT OF FUGITIVE DUST FROM CONSTRUCTION ACTIVITIES.

STABILIZED, TRANSFERRED TO NEW OWNERSHIP, OR DEVELOPED UNDER FUTURE PLANS

WITH A NEW NOTICE OF INTENT (NOI), SWPPP, AND PERMIT. ONCE THE CONSTRUCTION

ACTIVITIES HAVE BEEN COMPLETED AND THE SITE HAS MET THE FINAL STABILIZATION REQUIREMENTS OF THE PERMIT. THE AUTHORIZED SITE REPRESENTATIVE MAY FILE A

RESCOTT ENGINEERING DIVISION TO TERMINATE COVERAGE UNDER THE PERMIT.

A CONCRETE WASHOUT SHALL BE INSTALLED FOR ALL PROJECTS THAT PROPOSI CONCRETE TO BE MIXED ON SITE OR BE DELIVERED FROM A BATCH PLANT. THE

NOTICE OR TERMINATION (NOT) WITH ADEQ. WITH A COPY SUBMITTED TO THE CITY OF

CONCRETE WASHOUT SHALL BE LOCATED A MINIMUM OF FIFTY (50) FEET FROM ANY

DRAINAGE INFRASTRUCTURE OR NATURAL DRAINAGE FEATURES OR WATER BODIES AND INCORPORATE AN IMPERMEABLE LINER TO CONTAIN THE REQUIRED VOLUME. ALL DRIED CONCRETE WASTE SHALL BE BROKEN INTO MANAGEABLE PIECES AND DISPOSED OF

THROUGHOUT CONSTRUCTION OF THE PROJECT AND BUILDINGS ON LOTS, AND SHALL CONDUCT HIS OPERATIONS IN SUCH A MANNER THAT STORM WATER WILL BE CONTAINED

EROSION AND SEDIMENT CONTROL (ESC) PLAN OR STORM WATER POLLUTION

REFERENCED ON THE SWPPP SHALL BE CONSIDERED A PART OF THE SWPPP.

ADEQ AND THE CITY OF PRESCOTT.

FROM POLLUTANTS AND DEBRIS.

COP STANDARD DETAIL

ALL CONCRETE USED FOR TRAFFIC SIGNAL POLE AND CABINET FOUNDATIONS SHALL BE CLASS "A".

THE CONTRACTOR SHALL CONTACT THE CITY TRAFFIC ENGINEER AND/OR THE APPROVED CITY REPRESENTATIVE TO ARRANGE FOR METER AND ELECTRICAL SERVICE CONNECTION FROM ARIZONA PUBLIC SERVICE (APS). THE CONTRACTOR IS RESPONSIBLE FOR PROVIDING AND INSTALLING THE SERVICE CONDUIT RUN FROM THE POWER COMPANY SOURCE TO THE SIGNAL METER PEDESTAL.

EMERGENCY VEHICLE PREEMPTION SHALL BE INSTALLED AT ALL TRAFFIC SIGNAL INTERSECTIONS. THE CONTRACTOR SHALL PROVIDE AND INSTALL AN OPTICOM 700 SERIES SYSTEM OR APPROVED EQUAL TO INCLUDE, SENSORS, PROCESSORS, CONFIRMATION AND CONTROLLER HARDWARE, MOUNTING HARDWARE, INTERFACE CABLES, OPTICAL CABLES, AND ANY OTHER EQUIPMENT REQUIRED FOR A FULLY FUNCTIONING PRE-EMPTION SYSTEM.

CONTRACTOR SHALL PERFORM A GROUND RESISTANCE TEST FOR EACH INSTALLED GROUND ROD AND POLE FOUNDATION GROUNDING COIL IN ACCORDANCE WITH ADOT SPEC. 723—3.03.

CONTRACTOR SHALL BAG ALL NEWLY INSTALLED VEHICULAR AND/OR PEDESTIAN TRAFFIC SIGNAL HEADS WITH BURLAP OR OTHER APPROVED MATERIAL UNTIL FINAL INSPECTION AND ACCEPTANCE BY THE CITY TRAFFIC ENGINEER AND/OR THE APPROVED CITY REPRESENTATIVE.

CONTRACTOR SHALL REPLACE ALL LANDSCAPING AND/OR THE APPROVED CITY REPRESENTATIVE.

CONTRACTOR SHALL REPLACE ALL LANDSCAPING AND/OR IRRIGATION FACILITIES THAT MAY BE DISTURBED OR DAMAGED DURING TRAFFIC SIGNAL CONSTRUCTION AT HIS EXPENSE CONTACT THE PROPERTY OWNER FOR INFORMATION ON THE LOCATION OF IRRIGATION EQUIPMENT.

CONTRACTOR SHALL PROVIDE AND INSTALL "TRAFFIC CONTROL CHANGE" SIGNS WITH FLAGS FOR 30 DAYS FOLLOWING TURN—ON.

CONTRACTOR SHALL PROVIDE AND INSTALL "TRAFFIC SIGNAL EQUIPMENT TO THE CITY OF PRESCOTT PUBLIC WORKS DEPARTMENT. FOR ADDITIONAL INFORMATION, PLEASE CONTACT THE TRAFFIC SIGNAL SUPERVISOR AT (928)777—1683

CONTROLTOR SHALL PROVIDE A SIX—FOOT COILED CONTROL CORD IN THE POLICE PANEL OF THE CONTROLLER CABINET.

TRAFFIC SIGNAL NOTES COP STANDARD DETAIL

REVISED: DETAIL No. 106P-2 07/16

REVISED: DETAIL N

07/16

CITY ENGINEER

105P-2

1. PRIOR TO BIDDING THE WORK, THE CONTRACTOR SHALL THOROUGHLY SATISFY HIM/HER SELF AS TO THE ACTUAL CONDITIONS AND REQUIREMENTS OF THE WORK. ALL QUANTITIES SHOWN ON THE PLANS ARE APPROXIMATE AND ARE FURNISHED SOLELY FOR THE CONTRACTOR'S CONVENIENCE. THEY DO NOT NECESSARILY CORRESPOND TO BID SCHEDULE ITEMS. PAYMENT SHALL BE BASED ON BID SCHEDULE ITEMS FOR ACTUAL QUANTITIES PROVIDED AND INSTALLED. THE CONTRACTOR SHALL NOT BE RELIEVED OF HIS RESPONSIBILITY FOR INDEPENDENTLY ESTIMATING WORK QUANTITIES PRIOR TO BIDDING. NO CLAIM SHALL BE MADE AGAINST THE OWNER OR THE ENGINEER FOR ANY ALLEGED MISUNDERSTANDING OF THE CONDITIONS, QUANTITIES OR NATURE OF THE WORK.

GENERAL NOTES

2. THESE CONSTRUCTION PLANS ARE SUBJECT TO THE INTERPRETATION OF INTENT BY THE ENGINEER. ALL QUESTIONS REGARDING THESE PLANS SHALL BE DIRECTED TO THE ENGINEER. ANY INTERPRETATION OF THE PLANS BY ANYONE OTHER THAN THE ENGINEER SHALL BE RESPONSIBLE FOR ANY CONSEQUENCES

3. IF TWO OR MORE GIVEN SPECIFICATIONS DIFFER IN CONTENT, THE MORE RESTRICTIVE OR STRINGENT SPECIFICATION, IN THE OPINION OF THE PROJECT ENGINEER WILL GOVERN.

4. THE CONTRACTOR IS RESPONSIBLE TO OBTAIN COPIES OF THE MAG STANDARDS, AS WELL AS ALL OTHER STANDARDS AND SPECIFICATIONS WHICH MAY BE NECESSARY TO COMPLETELY AND ACCURATELY INTERPRET THESE PLANS.

5. THE ENGINEER MAY ORDER ANY OR ALL WORKMANSHIP AND MATERIALS USED FOR THIS PROJECT TO BE TESTED ACCORDING TO APPLICABLE STANDARDS. THE CONTRACTOR SHALL SUPPLY ALL SAMPLES FOR THE TESTING AND CERTIFICATES OR RESULTS OF TESTING AT HIS EXPENSE.

6. THE CONTRACTOR MAY SUBMIT CAREFULLY DOCUMENTED AND CONSIDERED WRITTEN PROPOSALS FOR ALTERNATE MATERIALS AND CONSTRUCTION METHODS. THOSE PROPOSALS THAT ARE FOUND TO BE IN CONFORMITY WITH GOOD ENGINEERING DESIGN AND CAN BE EASILY MAINTAINED BY JURISDICTIONAL FORCES MAY BE GIVEN WRITTEN APPROVAL FOR INCORPORATION IN THE CONSTRUCTION PLANS IF THEY ARE FOUND TO BE IN THE BEST PUBLIC INTEREST.

7. ANY WORK PERFORMED WITHOUT THE KNOWLEDGE AND APPROVAL OF THE ENGINEER OR HIS AUTHORIZED REPRESENTATIVE IS SUBJECT TO REMOVAL AND REPLACEMENT AT THE CONTRACTOR'S EXPENSE.

8. THE ENGINEER OR HIS AUTHORIZED REPRESENTATIVE MAY SUSPEND THE WORK BY WRITTEN NOTICE WHEN, IN HIS JUDGMENT, PROGRESS IS UNSATISFACTORY, IMPROPER WORKMANSHIP IS BEING PERFORMED, WORK BEING DONE IS UNAUTHORIZED OR DEFECTIVE, WEATHER CONDITIONS ARE UNSUITABLE, OR THERE IS DANGER TO THE PUBLIC HEALTH OR SAFETY.

9. ALL IMPROVEMENTS SHALL BE CONSTRUCTED BY CONTRACTOR(S) THAT ARE LICENSED BY THE ARIZONA STATE REGISTRAR OF CONTRACTORS, WITH A CLASS OF LICENSE(S) FOR THE SPECIFIC WORK BEING PERFORMED. THE CONTRACTOR IS REQUIRED TO COMPLY WITH ALL LOCAL, STATE, AND FEDERAL LAWS AND REGULATIONS APPLICABLE TO THE CONSTRUCTION OF THIS PROJECT. THE CONTRACTOR IS RESPONSIBLE FOR ALL CONSTRUCTION METHODS, SEQUENCING, AND SAFETY DURING CONSTRUCTION.

10. THE GENERAL CONTRACTOR AND ANY SUBCONTRACTORS PERFORMING WORK SHOWN ON THESE PLANS SHALL CONDUCT THEIR OPERATIONS SO THAT ALL EMPLOYEES ARE PROVIDED A SAFE PLACE TO WORK AND THE PUBLIC IS PROTECTED. ALL CONTRACTORS AND SUBCONTRACTORS SHALL COMPLY WITH ALL APPLICABLE O.S.H.A. REGULATIONS.

11. THE CONTRACTOR AND ANY SUBCONTRACTORS SHALL HAVE A COMPLETE AND CURRENT SET OF PLANS ON-SITE AT ALL TIMES. IT IS THE RESPONSIBILITY OF THE GENERAL CONTRACTOR TO SUPPLY ANY SUBCONTRACTORS WITH THESE PLANS.

12. THE CONTRACTOR SHALL MAKE ARRANGEMENTS FOR AND PROVIDE ALL NECESSARY WATER FOR HIS

13. IT IS THE SOLE RESPONSIBILITY OF THE CONTRACTOR TO OBTAIN, AT HIS OWN EXPENSE, SUCH PERMITS AS ARE REQUIRED FROM THE APPROPRIATE AGENCIES.

14. THE CONTRACTOR SHALL WARRANT ALL WORK FOR A MINIMUM OF A TWO YEAR PERIOD BEGINNING AFTER FINAL ACCEPTANCE IS GIVEN BY THE ENGINEER.

15. THE CONTRACTOR SHALL GUARD AGAINST DAMAGE DURING CONSTRUCTION TO EXISTING PROPERTIES AND IMPROVEMENTS. ANY ITEMS DAMAGED BY THE CONSTRUCTION SHALL BE REPLACED IN KIND OR BETTER AT THE CONTRACTOR'S EXPENSE.

16. CONSTRUCTION STAKING SHALL BE THE CONTRACTOR'S RESPONSIBILITY WITH CONTROL PROVIDED BY THE DESIGN ENGINEER. THE CONTRACTOR SHALL CONTACT THE ENGINEER 48 HOURS PRIOR TO STARTING WORK TO SCHEDULE STAKING.

17. A PRE-CONSTRUCTION MEETING IS REQUIRED FOR THIS PROJECT. THE CONTRACTOR SHALL COORDINATE WITH THE PROJECT ENGINEER TO SCHEDULE AN ON-SITE MEETING PRIOR TO THE START OF

18. THE CONTRACTOR SHALL MAINTAIN A COMPLETE SET OF AS-BUILT PLANS ON SITE FOR REFERENCE AT ALL TIMES. THE AS-BUILT PLANS WILL BE FURNISHED BY THE CONTRACTOR TO THE ENGINEER AT THE COMPLETION OF THE PROJECT FOR RECORD. THE AS-BUILT PLANS MUST BE UPDATED DAILY BY THE CONTRACTOR AND INCLUDE, IN ADDITION TO THE PLANNED CONSTRUCTION, ANY CHANGES AUTHORIZED BY THE ENGINEER AND ANY UTILITIES DISCOVERED DURING THE TRENCHING OPERATIONS BY SIZE, LOCATION, AND TYPE REDLINED ONTO THE PLANS BY STATION/DISTANCE/DEPTH.

19. THE CONTRACTOR IS TO UNCOVER ALL EXISTING LINES BEING TIED INTO AND VERIFY GRADES, MATERIAL, SIZE & ELEVATIONS BEFORE COMMENCING CONSTRUCTION & ORDERING MATERIALS.

20. ALL MATERIALS SHALL BE INSTALLED PER MANUFACTURER'S GUIDELINES.

CONSTRUCTION OPERATION AT HIS OWN EXPENSE.

UTILITY CONFLICT NOTES:

1. COOPERATION WITH UTILITY COMPANIES SHALL BE DONE IN ACCORDANCE WITH SECTION 105.6 OF MAG SPECIFICATIONS.

2. EXISTING UTILITY INFORMATION IS APPROXIMATE AND FOR INFORMATION PURPOSES ONLY. HORIZONTAL LOCATIONS ARE BASED ON BLUESTAKE (MULESERVICES) & AS-BUILT DATA (TOWN OF PRESCOTT VALLEY) WITH ELEVATIONS APPROXIMATED FROM POTHOLE INFORMATION & AS-BUILT INFORMATION. THE CONTRACTOR SHALL CAREFULLY EXCAVATE, INCLUDING POTHOLING IF NECESSARY, TO VERIFY ALL EXISTING UTILITY LOCATIONS & ELEVATIONS PRIOR TO CONSTRUCTION.

3. POTENTIAL CONFLICTS IDENTIFIED ON THE PLANS DO NOT RELIEVE THE CONTRACTOR AND/OR UTILITY COMPANIES FROM THE RESPONSIBILITY TO IDENTIFY ALL CONFLICTS WITH THE PROPOSED IMPROVEMENTS.

4. FAILURE BY THE CONTRACTOR AND/OR UTILITY COMPANY TO IDENTIFY CONFLICTS PRIOR TO CONSTRUCTION SHALL NOT RESULT IN ANY CLAIM BROUGHT AGAINST THE TOWN OR ENGINEER.

104P

07/16

20

REVISIONS

COP ROUND 1

These drawings are the property of W. Alan Kenson & Associates P.C., and may not be reproduced in any way without the written consent

of W. Alan Kenson & Associates, P.C.

45636 BEN B. HUZA

ARIZONA, U


COMMENTS COP ROUND 2 ∠ COMMENTS


ნ ≷ წ


DRAWN E BH CHECKED BY TS/BH


December 4, 2024 799 SHEET


5/8" HOLE FOR 1/2" DIA. PIN, 24" LONG, HOT ROLLED STEEL

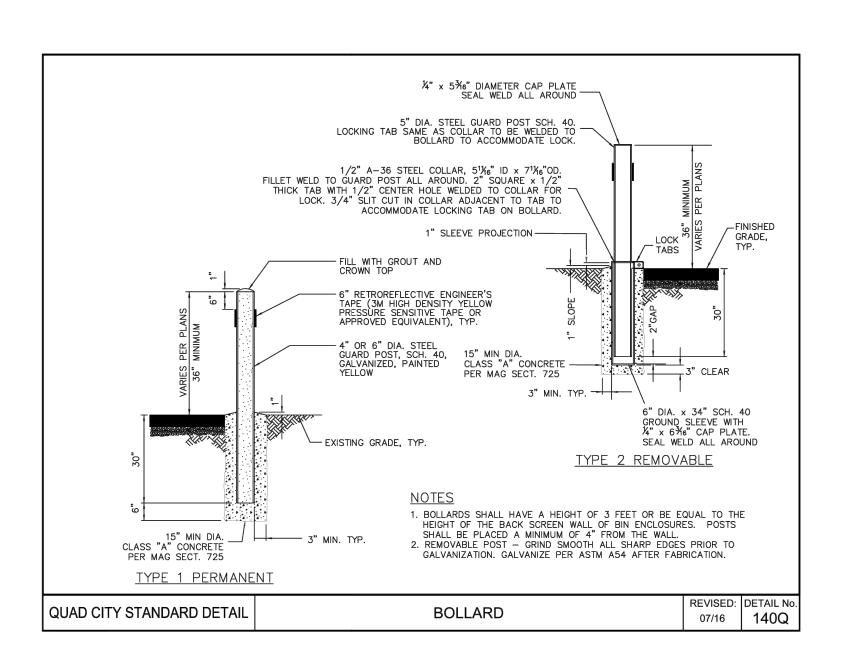


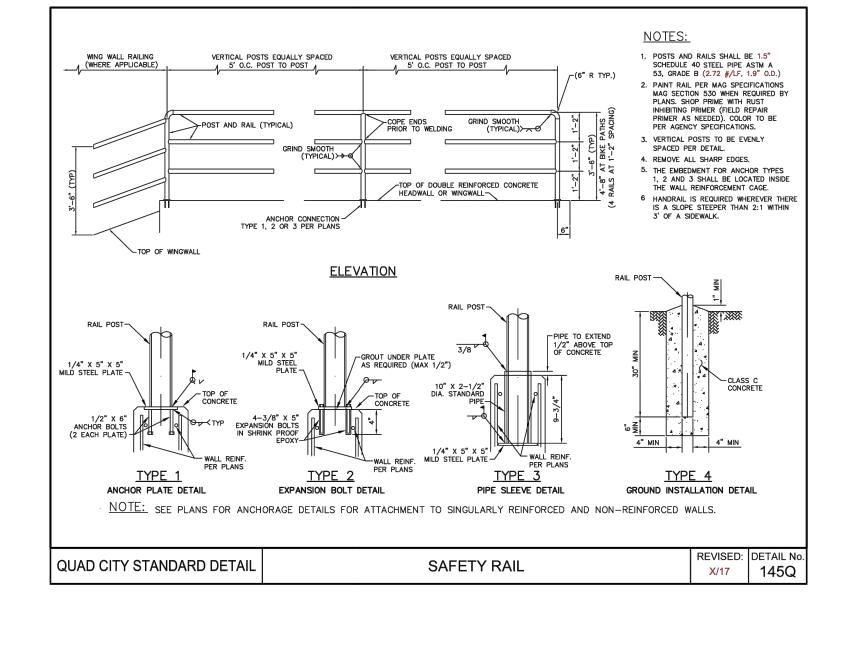


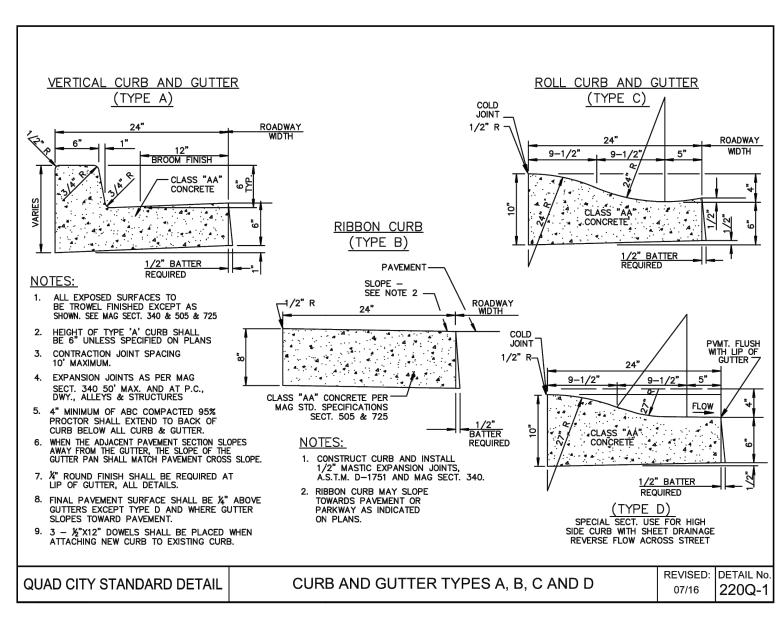


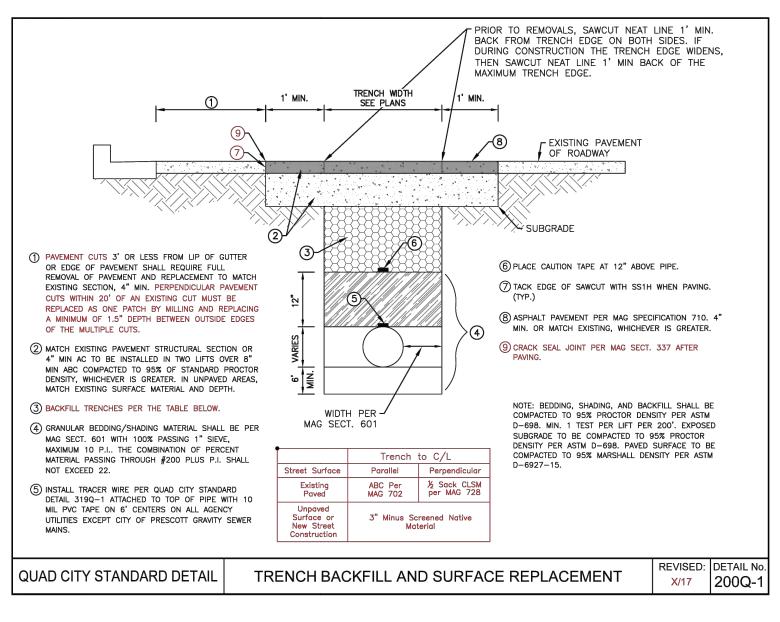

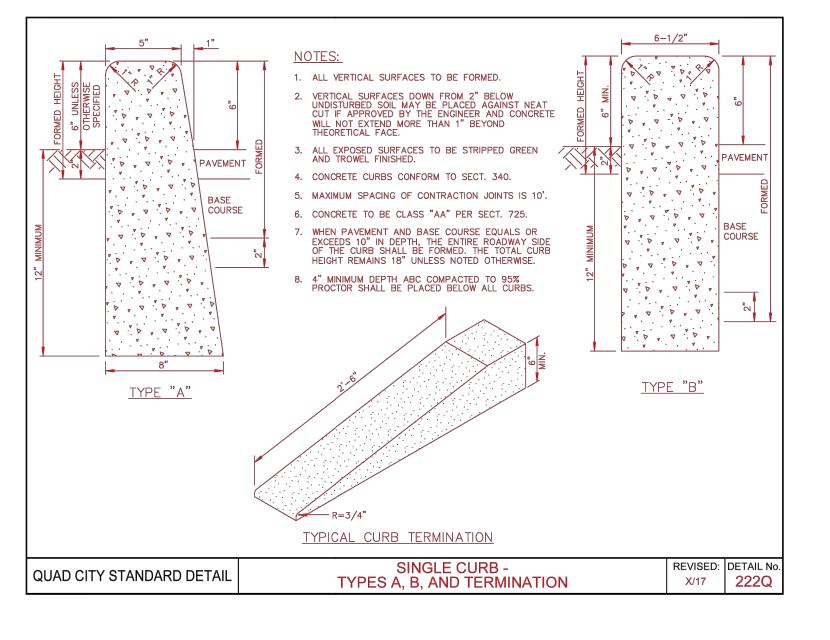

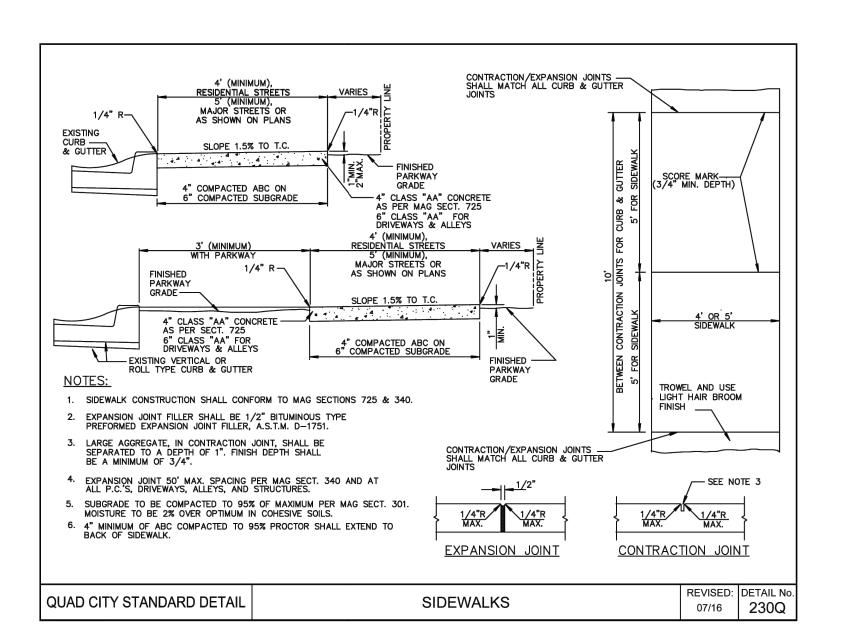

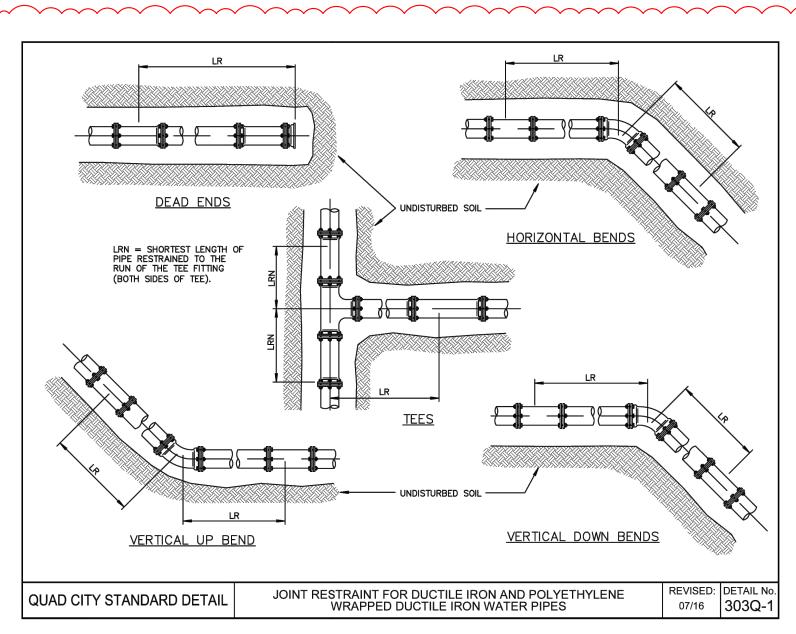

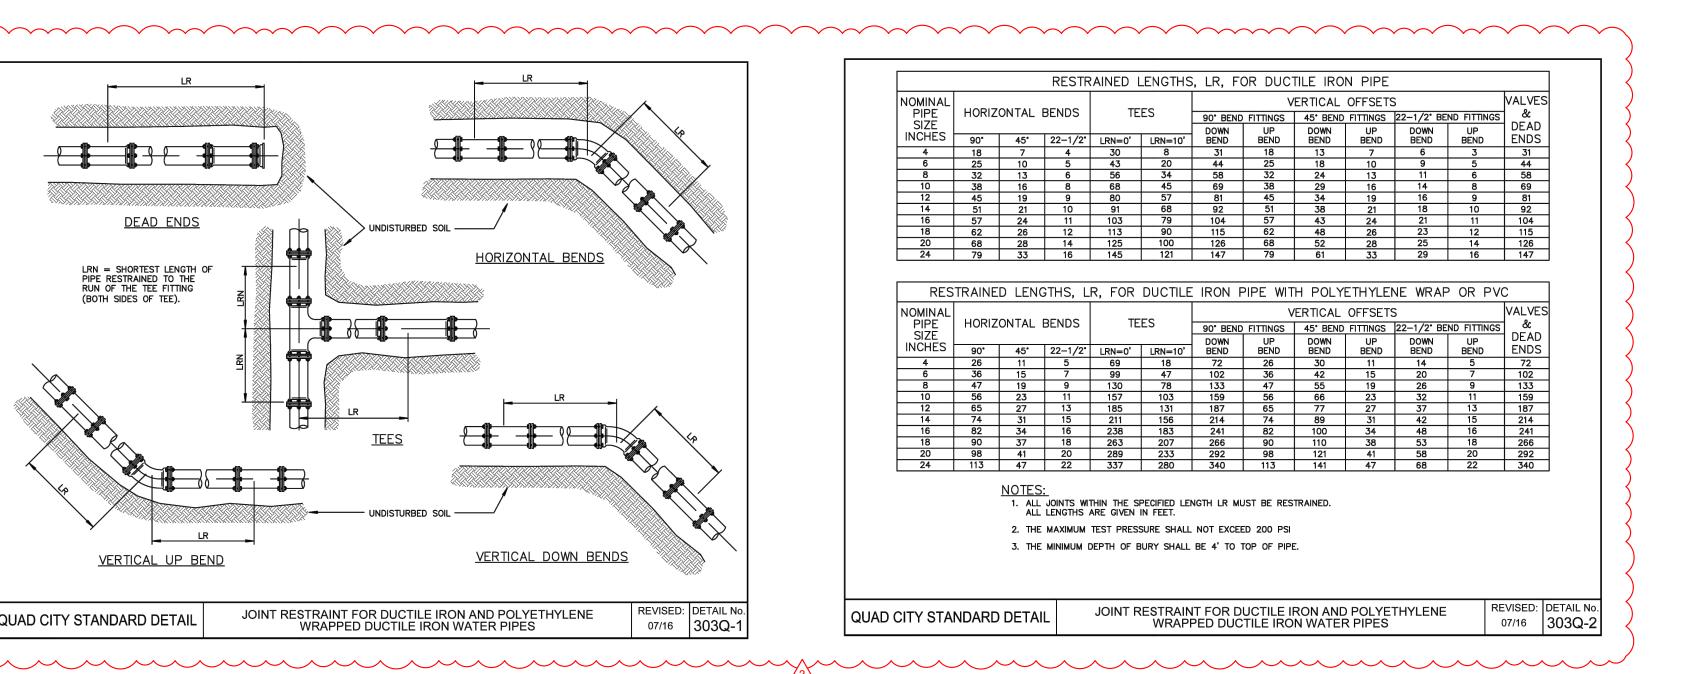



REVISIONS

COP ROUND 1 COMMENTS COP ROUND 2 2 COMMENTS

These drawings are the property of W. Alan

Kenson & Associates P.C., and may not be

reproduced in any way without the written consent of W. Alan Kenson & Associates, P.C.


45636


BEN B.


HUZA

DRAWN B' BH CHECKED BY TS/BH December 4, 2024 JOB NO. **799**

DR

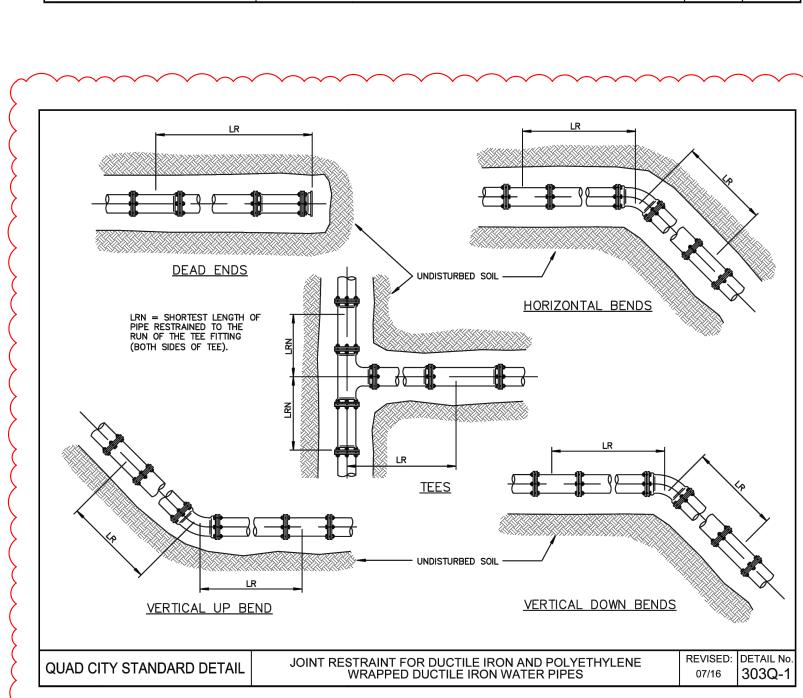

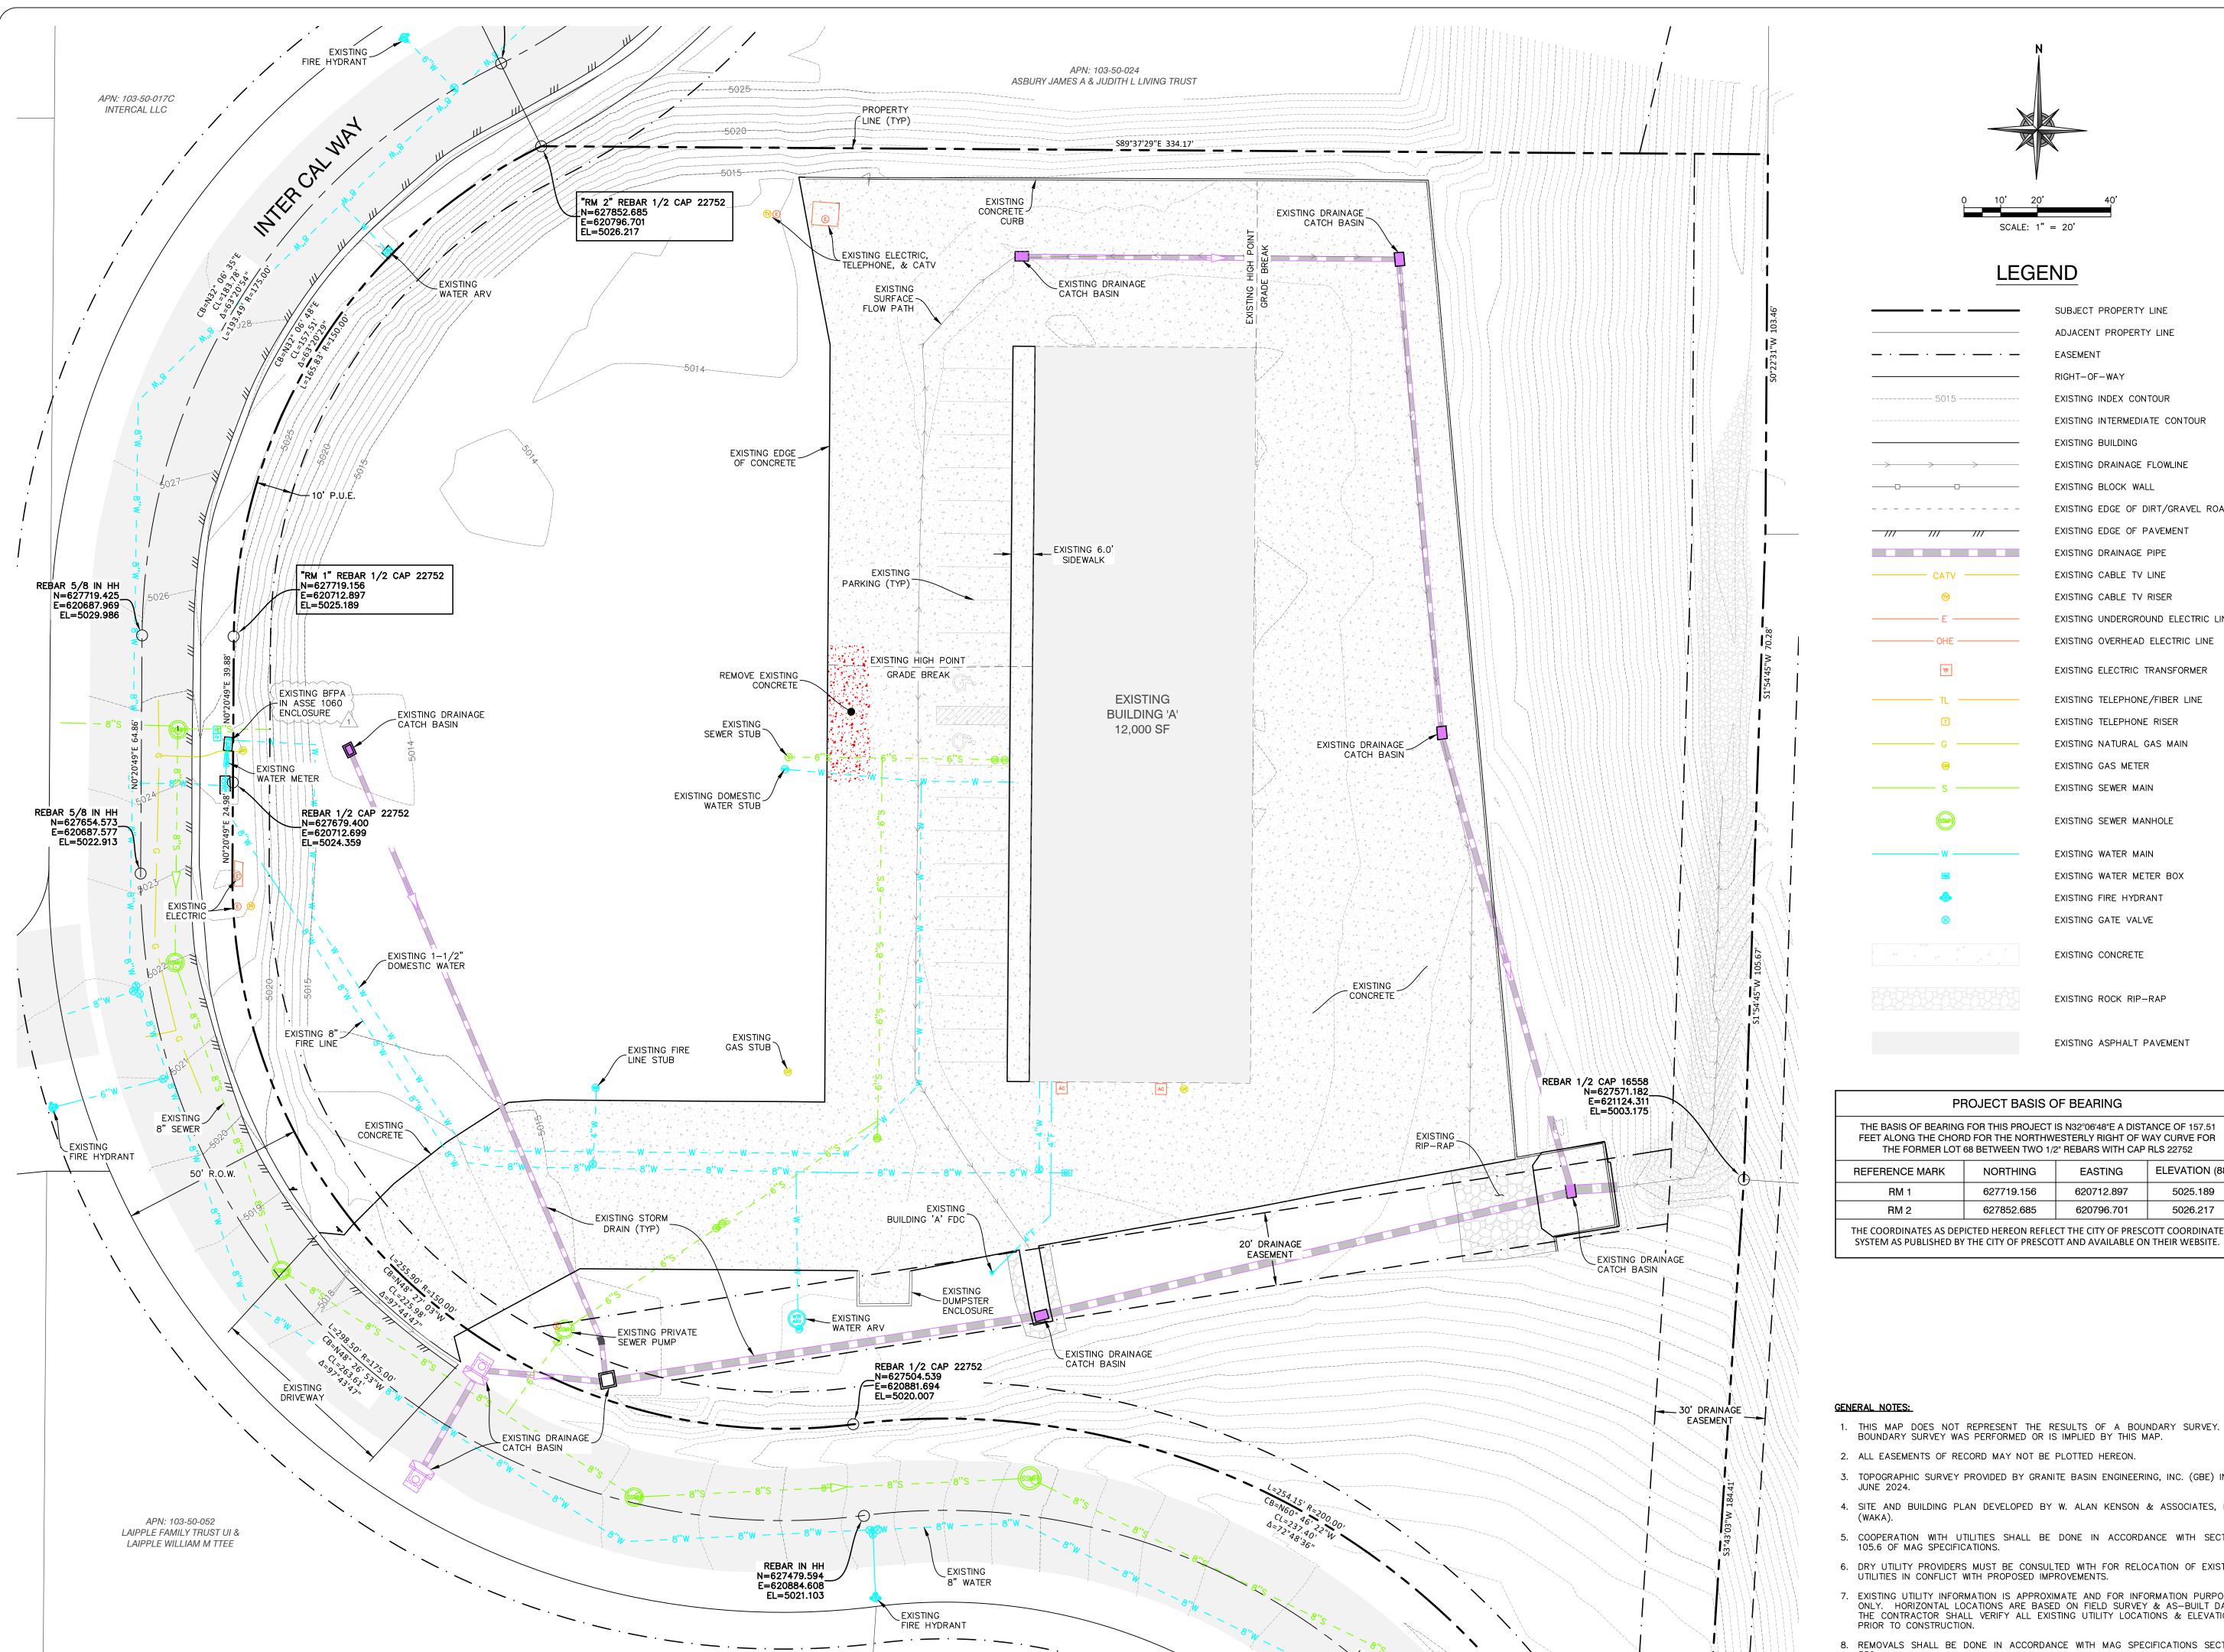

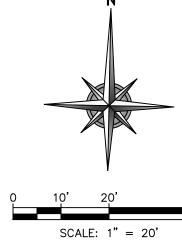

LEGEND

SUBJECT PROPERTY LINE

	COBCECT THOSE ENTITIES
	ADJACENT PROPERTY LINE
_ · _ · _ · _ · _	EASEMENT
	RIGHT-OF-WAY
5015	EXISTING INDEX CONTOUR
	EXISTING INTERMEDIATE CONTOUR
	EXISTING BUILDING
\rightarrow \rightarrow \rightarrow	EXISTING DRAINAGE FLOWLINE
	EXISTING BLOCK WALL
	EXISTING EDGE OF DIRT/GRAVEL ROAD
/// /// ///	EXISTING EDGE OF PAVEMENT
	EXISTING DRAINAGE PIPE
CATV —	EXISTING CABLE TV LINE
₩	EXISTING CABLE TV RISER
Е ——	EXISTING UNDERGROUND ELECTRIC LINE
——————————————————————————————————————	EXISTING OVERHEAD ELECTRIC LINE
TR	EXISTING ELECTRIC TRANSFORMER
π. ———	EXISTING TELEPHONE/FIBER LINE
T	EXISTING TELEPHONE RISER
G	EXISTING NATURAL GAS MAIN
<u> </u>	EXISTING GAS METER
s ———	EXISTING SEWER MAIN
(SOMH)	EXISTING SEWER MANHOLE
	EXISTING WATER MAIN
	EXISTING WATER METER BOX
•	EXISTING FIRE HYDRANT
⊗	EXISTING GATE VALVE
	EXISTING CONCRETE
	EXISTING ROCK RIP-RAP

PROJECT	BASIS	OF	BFAR	INC

			ELEVATION (00)			
THE FORMER LOT 68 BETWEEN TWO 1/2" REBARS WITH CAP RLS 22752						
FEET ALONG THE CHORD FOR THE NORTHWESTERLY RIGHT OF WAY CURVE FOR						
THE BASIS OF BEARING FOR THIS PROJECT IS N32°06'48"E A DISTANCE OF 157.51						

EXISTING ASPHALT PAVEMENT

REFERENCE MARK	NORTHING	EASTING	ELEVATION (88)			
RM 1	627719.156	620712.897	5025.189			
RM 2 627852.685 620796.701 5026.217						
THE COORDINATES AS DEPICTED HEREON REFLECT THE CITY OF PRESCOTT COORDINATE						


- 1. THIS MAP DOES NOT REPRESENT THE RESULTS OF A BOUNDARY SURVEY. NO
- 2. ALL EASEMENTS OF RECORD MAY NOT BE PLOTTED HEREON.
- 3. TOPOGRAPHIC SURVEY PROVIDED BY GRANITE BASIN ENGINEERING, INC. (GBE) IN
- 4. SITE AND BUILDING PLAN DEVELOPED BY W. ALAN KENSON & ASSOCIATES, P.C.
- 5. COOPERATION WITH UTILITIES SHALL BE DONE IN ACCORDANCE WITH SECTION 105.6 OF MAG SPECIFICATIONS.
- 6. DRY UTILITY PROVIDERS MUST BE CONSULTED WITH FOR RELOCATION OF EXISTING UTILITIES IN CONFLICT WITH PROPOSED IMPROVEMENTS.
- 7. EXISTING UTILITY INFORMATION IS APPROXIMATE AND FOR INFORMATION PURPOSES ONLY. HORIZONTAL LOCATIONS ARE BASED ON FIELD SURVEY & AS—BUILT DATA. THE CONTRACTOR SHALL VERIFY ALL EXISTING UTILITY LOCATIONS & ELEVATIONS
- 8. REMOVALS SHALL BE DONE IN ACCORDANCE WITH MAG SPECIFICATIONS SECTION 350.


REVISIONS	BY
COP ROUND 1 COMMENTS	ВН
COP ROUND 2 COMMENTS	ВН

These drawings are the property of W. Alan Kenson & Associates P.C., and may not be reproduced in any way without the written consent



DRAWN BY BH CHECKED BY TS/BH DATE December 4, 2024 JOB NO. **799** SHEET

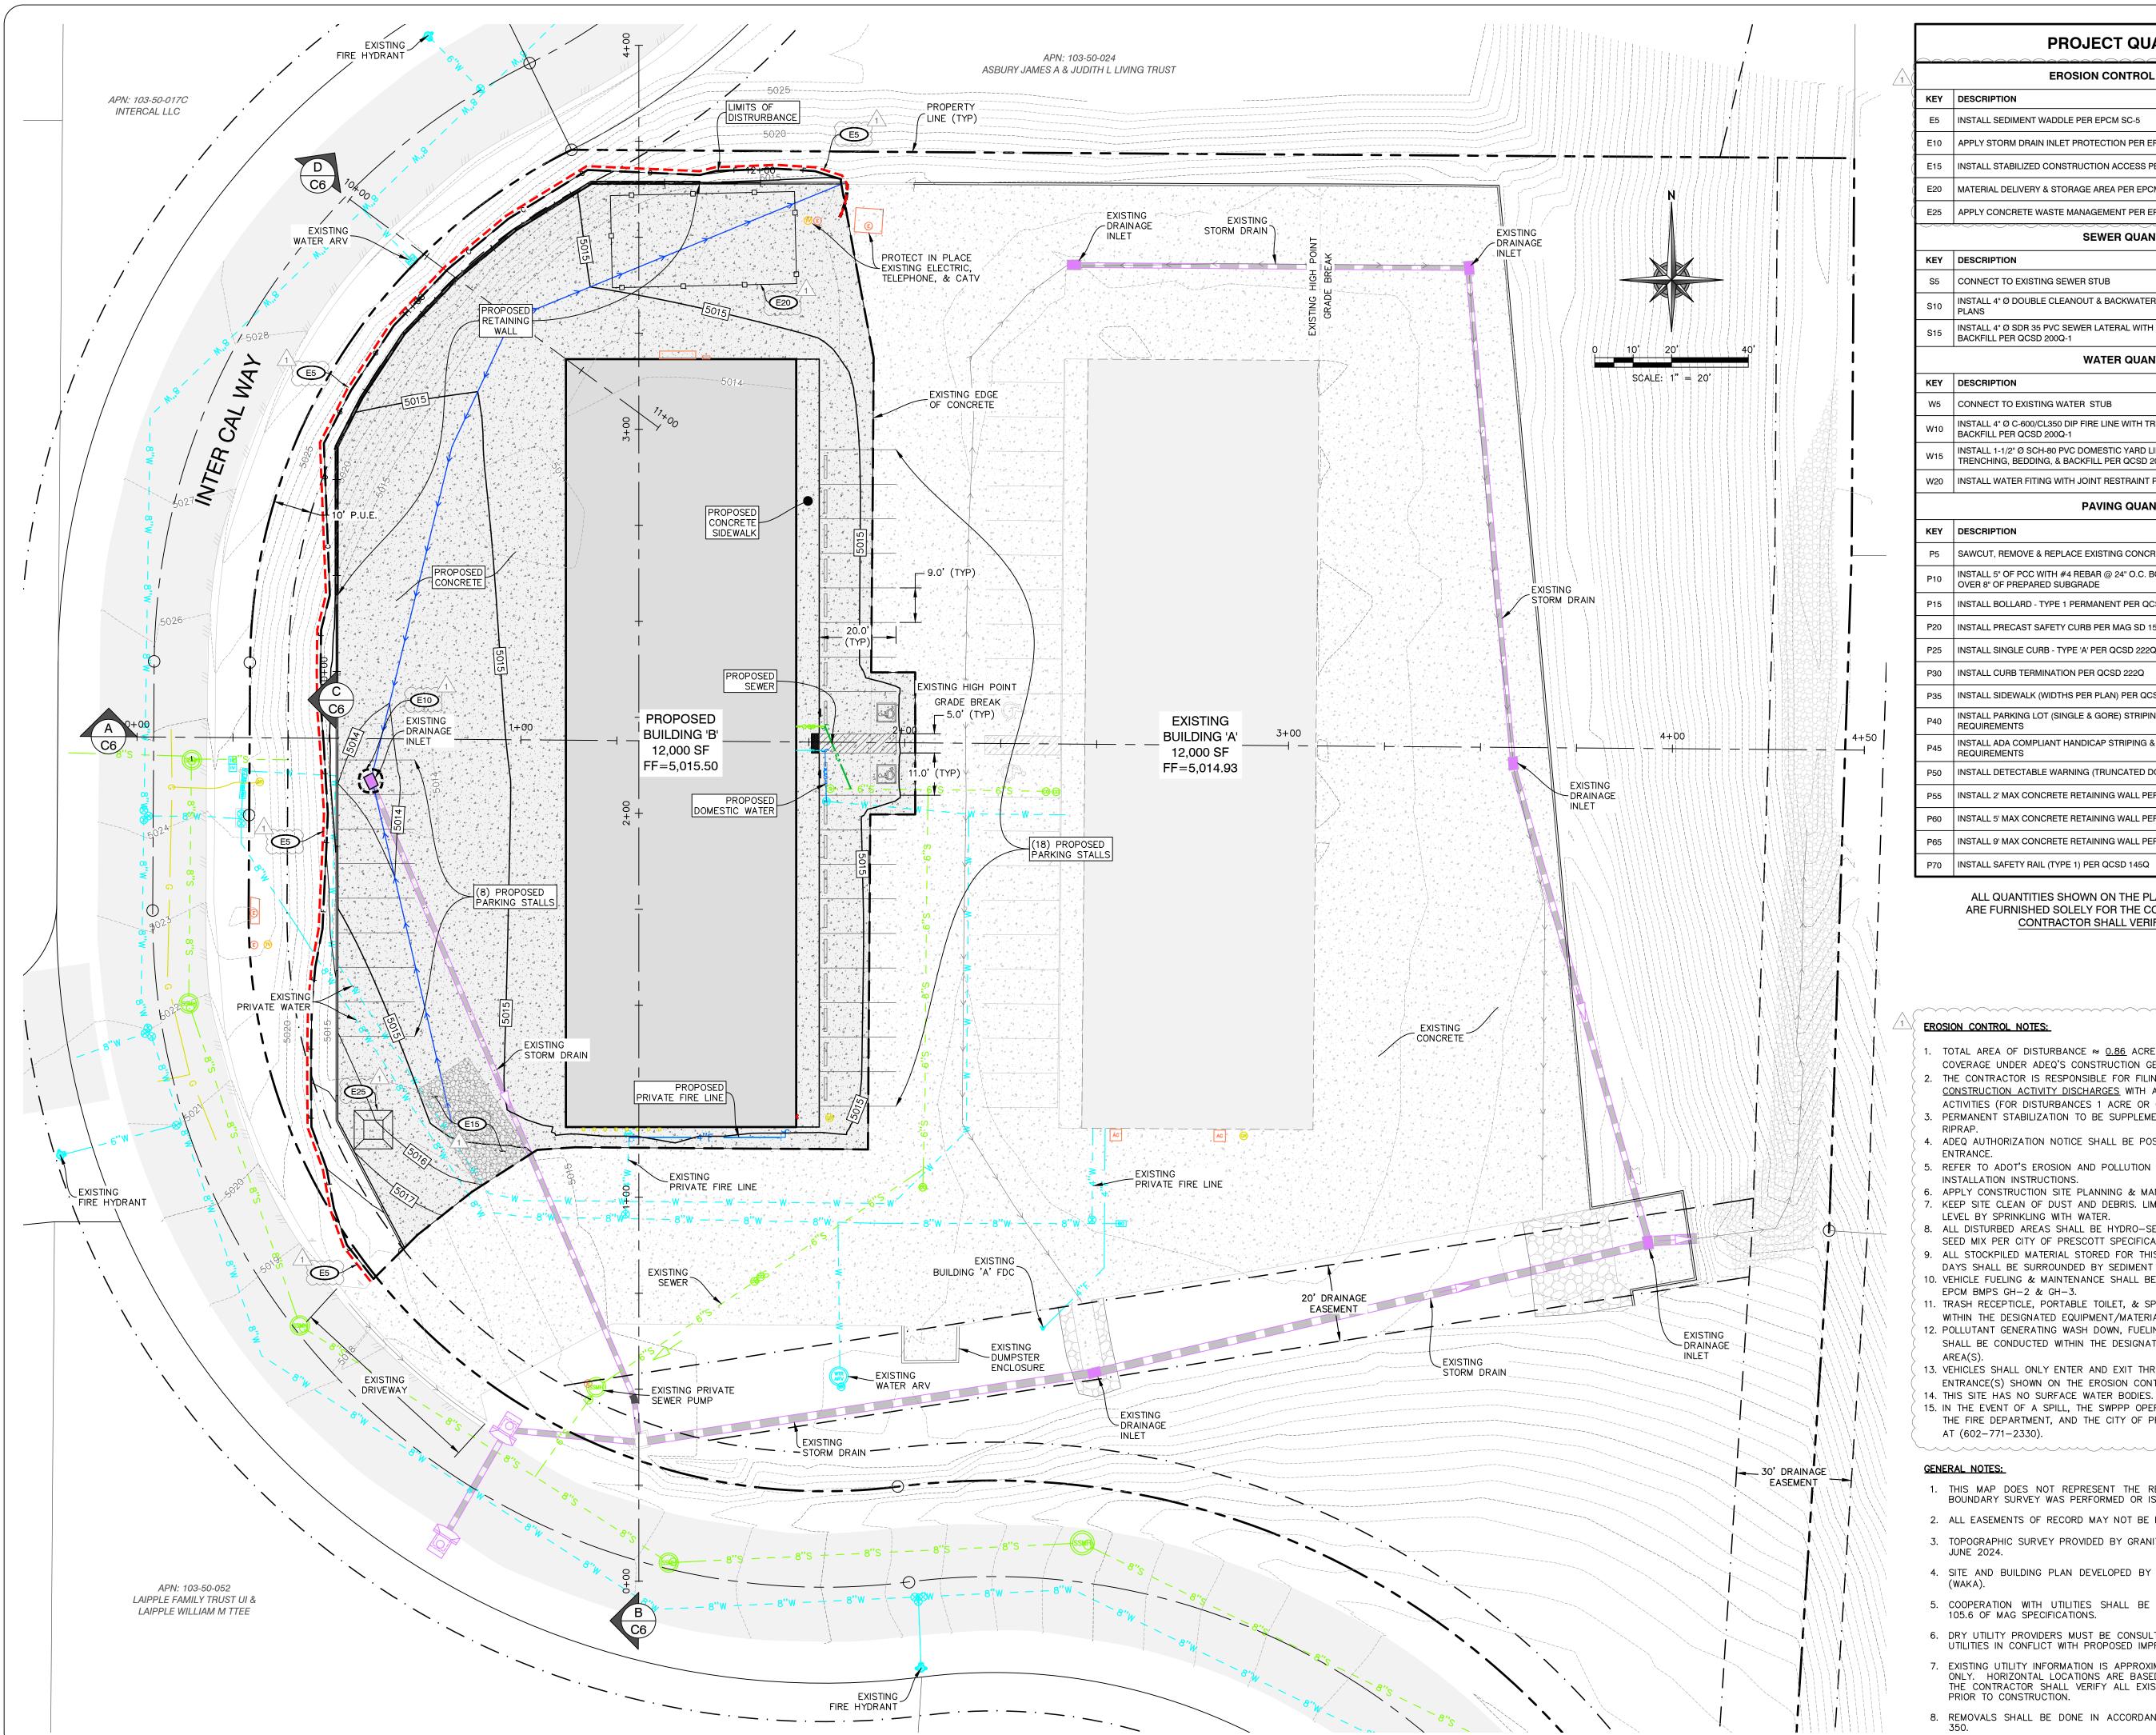

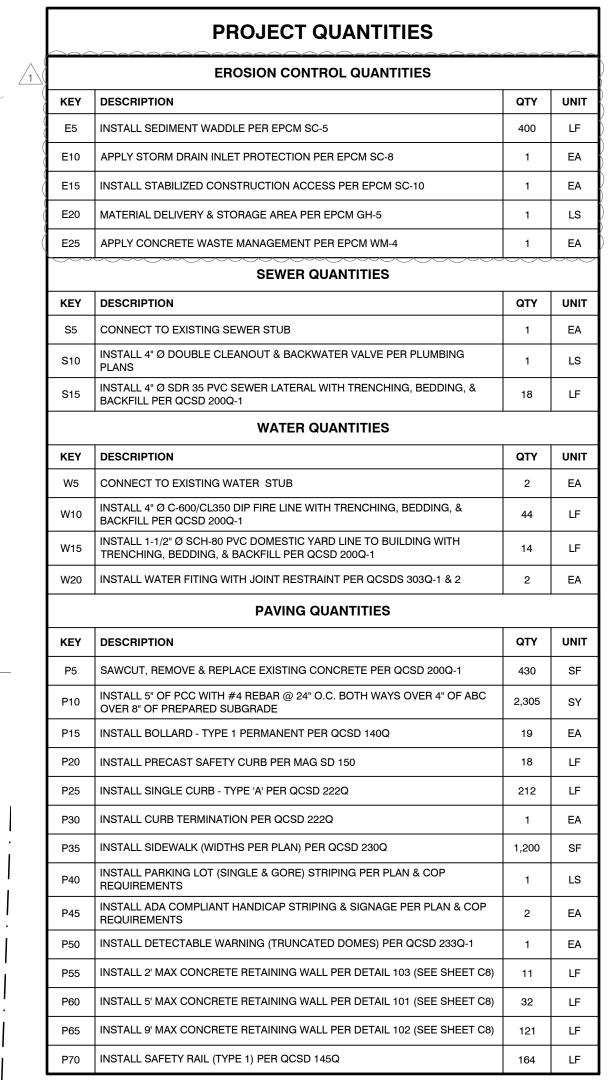

ALL QUANTITIES SHOWN ON THE PLANS ARE APPROXIMATE AND ARE FURNISHED SOLELY FOR THE CONTRACTOR'S CONVENIENCE. CONTRACTOR SHALL VERIFY ALL QUANTITIES.

EROSION CONTROL NOTES:

- 1. TOTAL AREA OF DISTURBANCE ≈ 0.86 ACRES WHICH DOES NOT WARRANT COVERAGE UNDER ADEQ'S CONSTRUCTION GENERAL PERMIT.
- 2. THE CONTRACTOR IS RESPONSIBLE FOR FILING THE NOTICE OF INTENT (NOI) FOR CONSTRUCTION ACTIVITY DISCHARGES WITH ADEQ PRIOR TO ANY CONSTRUCTION ACTIVITIES (FOR DISTURBANCES 1 ACRE OR GREATER).
- 3. PERMANENT STABILIZATION TO BE SUPPLEMENTED BY LANDSCAPE PLAN AND
- 4. ADEQ AUTHORIZATION NOTICE SHALL BE POSTED ON-SITE NEAR CONSTRUCTION
- 5. REFER TO ADOT'S EROSION AND POLLUTION CONTROL MANUAL (EPCM) FOR BMP INSTALLATION INSTRUCTIONS.
- 6. APPLY CONSTRUCTION SITE PLANNING & MANAGEMENT PER EPCM CP-1 & CP-2. 7. KEEP SITE CLEAN OF DUST AND DEBRIS. LIMIT DUST TO LOWEST PRACTICABLE
- 8. ALL DISTURBED AREAS SHALL BE HYDRO-SEEDED PER ADOT EPCM BMP EC-4 WITH SEED MIX PER CITY OF PRESCOTT SPECIFICATIONS.
- 9. ALL STOCKPILED MATERIAL STORED FOR THIS PROJECT FOR MORE THAN SEVEN (7) DAYS SHALL BE SURROUNDED BY SEDIMENT WADDLES PER ADOT EPCM BMP GH-7.
- 10. VEHICLE FUELING & MAINTENANCE SHALL BE DONE IN ACCORDANCE WITH ADOT EPCM BMPS GH-2 & GH-3.
- 11. TRASH RECEPTICLE, PORTABLE TOILET, & SPILL RESPONSE KIT SHALL BE LOCATED
- WITHIN THE DESIGNATED EQUIPMENT/MATERIAL STORAGE AREA. 12. POLLUTANT GENERATING WASH DOWN, FUELING, AND MAINTENANCE ACTIVITIES
- SHALL BE CONDUCTED WITHIN THE DESIGNATED EQUIPMENT/MATERIAL STORAGE
- 13. VEHICLES SHALL ONLY ENTER AND EXIT THROUGH THE STABILIZED CONSTRUCTION ENTRANCE(S) SHOWN ON THE EROSION CONTROL PLAN.
- 15. IN THE EVENT OF A SPILL, THE SWPPP OPERATOR SHALL IMMEDIATELY CONTACT THE FIRE DEPARTMENT, AND THE CITY OF PRESCOTT, AND WITHIN 24 HOURS ADEQ AT (602-771-2330).


- 1. THIS MAP DOES NOT REPRESENT THE RESULTS OF A BOUNDARY SURVEY. NO BOUNDARY SURVEY WAS PERFORMED OR IS IMPLIED BY THIS MAP.
- 2. ALL EASEMENTS OF RECORD MAY NOT BE PLOTTED HEREON.
- 3. TOPOGRAPHIC SURVEY PROVIDED BY GRANITE BASIN ENGINEERING, INC. (GBE) IN
- 4. SITE AND BUILDING PLAN DEVELOPED BY W. ALAN KENSON & ASSOCIATES, P.C.
- 5. COOPERATION WITH UTILITIES SHALL BE DONE IN ACCORDANCE WITH SECTION
- 105.6 OF MAG SPECIFICATIONS.
- 6. DRY UTILITY PROVIDERS MUST BE CONSULTED WITH FOR RELOCATION OF EXISTING UTILITIES IN CONFLICT WITH PROPOSED IMPROVEMENTS.
- 7. EXISTING UTILITY INFORMATION IS APPROXIMATE AND FOR INFORMATION PURPOSES ONLY. HORIZONTAL LOCATIONS ARE BASED ON FIELD SURVEY & AS-BUILT DATA. THE CONTRACTOR SHALL VERIFY ALL EXISTING UTILITY LOCATIONS & ELEVATIONS PRIOR TO CONSTRUCTION.
- 8. REMOVALS SHALL BE DONE IN ACCORDANCE WITH MAG SPECIFICATIONS SECTION


REVISIONS COP ROUND 1 COMMENTS COP ROUND 2 2 COMMENTS These drawings are the property of W. Alan Kenson & Associates P.C., and may not be

reproduced in any way without the written consent





CHECKED BY TS/BH December 4, 2024 JOB NO. **799**

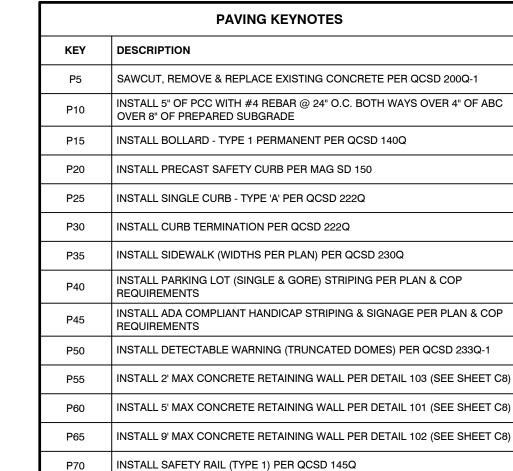

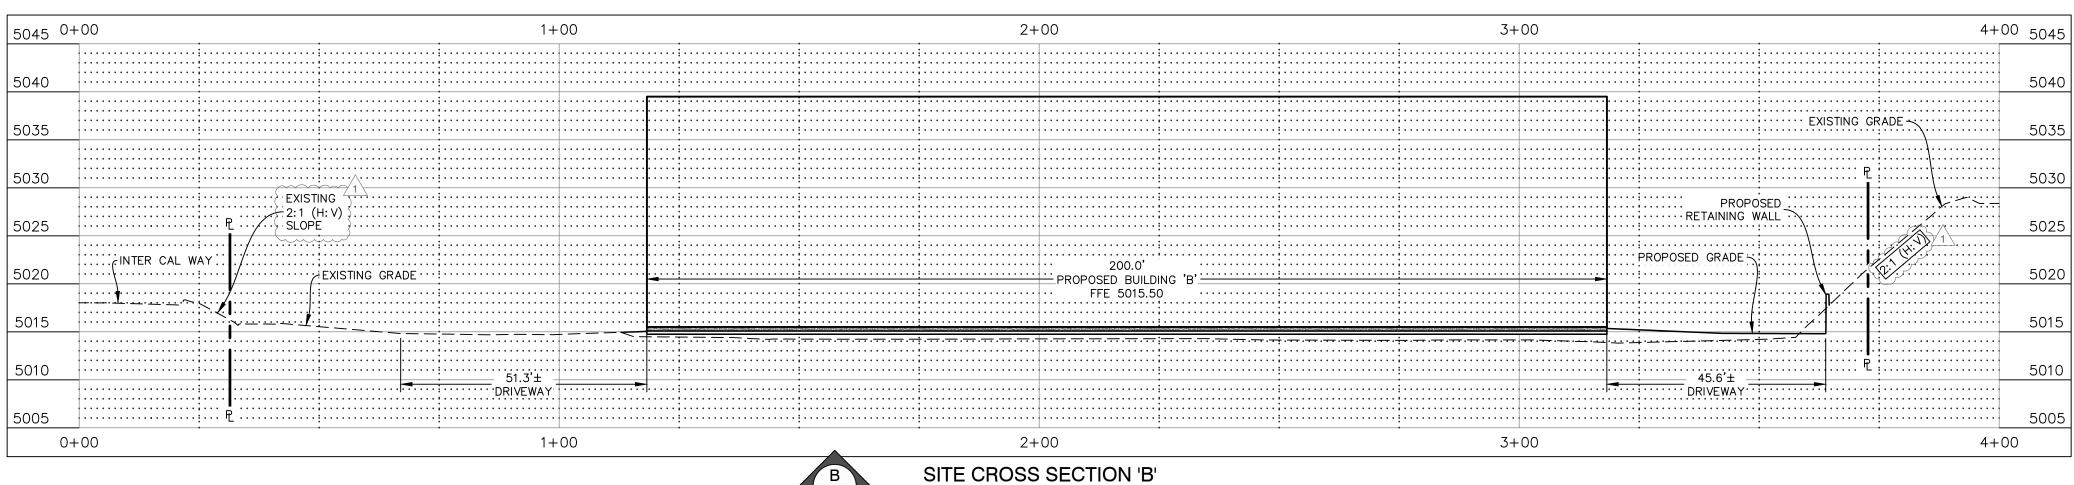

SCALE: 1" = 20' HORIZ. 1" = 10' VERT.

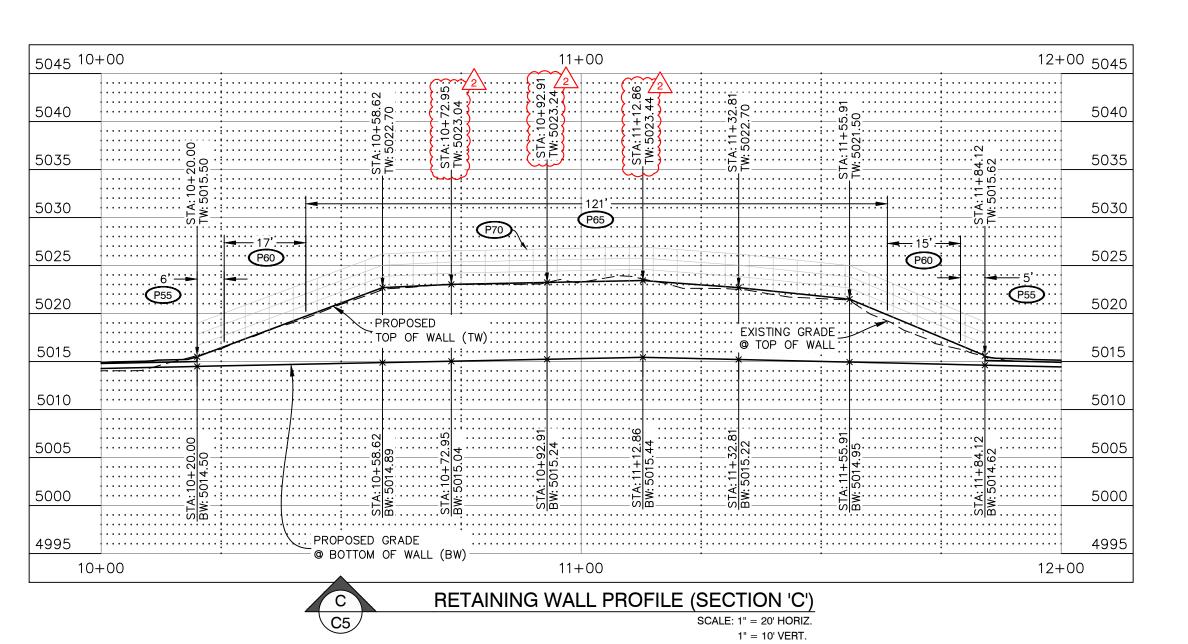

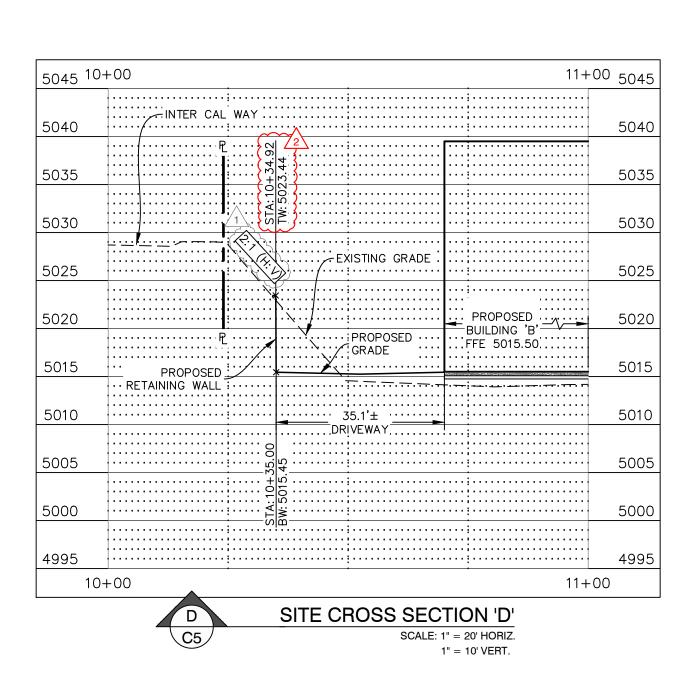

GENERAL NOTES:

1. THIS MAP DOES NOT REPRESENT THE RESULTS OF A BOUNDARY SURVEY. NO

BOUNDARY SURVEY WAS PERFORMED OR IS IMPLIED BY THIS MAP.

2. ALL EASEMENTS OF RECORD MAY NOT BE PLOTTED HEREON.

UTILITIES IN CONFLICT WITH PROPOSED IMPROVEMENTS.

- 3. TOPOGRAPHIC SURVEY PROVIDED BY GRANITE BASIN ENGINEERING, INC. (GBE) IN JUNE 2024.
- 4. SITE AND BUILDING PLAN DEVELOPED BY W. ALAN KENSON & ASSOCIATES, P.C.
- (WAKA).
- 5. COOPERATION WITH UTILITIES SHALL BE DONE IN ACCORDANCE WITH SECTION
- 105.6 OF MAG SPECIFICATIONS. 6. DRY UTILITY PROVIDERS MUST BE CONSULTED WITH FOR RELOCATION OF EXISTING
- 7. EXISTING UTILITY INFORMATION IS APPROXIMATE AND FOR INFORMATION PURPOSES ONLY. HORIZONTAL LOCATIONS ARE BASED ON FIELD SURVEY & AS—BUILT DATA. THE CONTRACTOR SURVEY ALL EXISTING UTILITY LOCATIONS & ELEVATIONS PRIOR TO CONSTRUCTION.
- 8. REMOVALS SHALL BE DONE IN ACCORDANCE WITH MAG SPECIFICATIONS SECTION 350.

DRAWN BY BH CHECKED BY TS/BH DATE December 4, 2024 JOB NO. **799**


SHEET


COP ROUND 2 2 COMMENTS These drawings are the property of W. Alan Kenson & Associates P.C., and may not be

REVISIONS

COP ROUND 1

COMMENTS

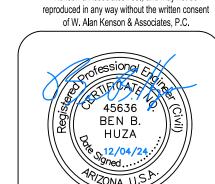

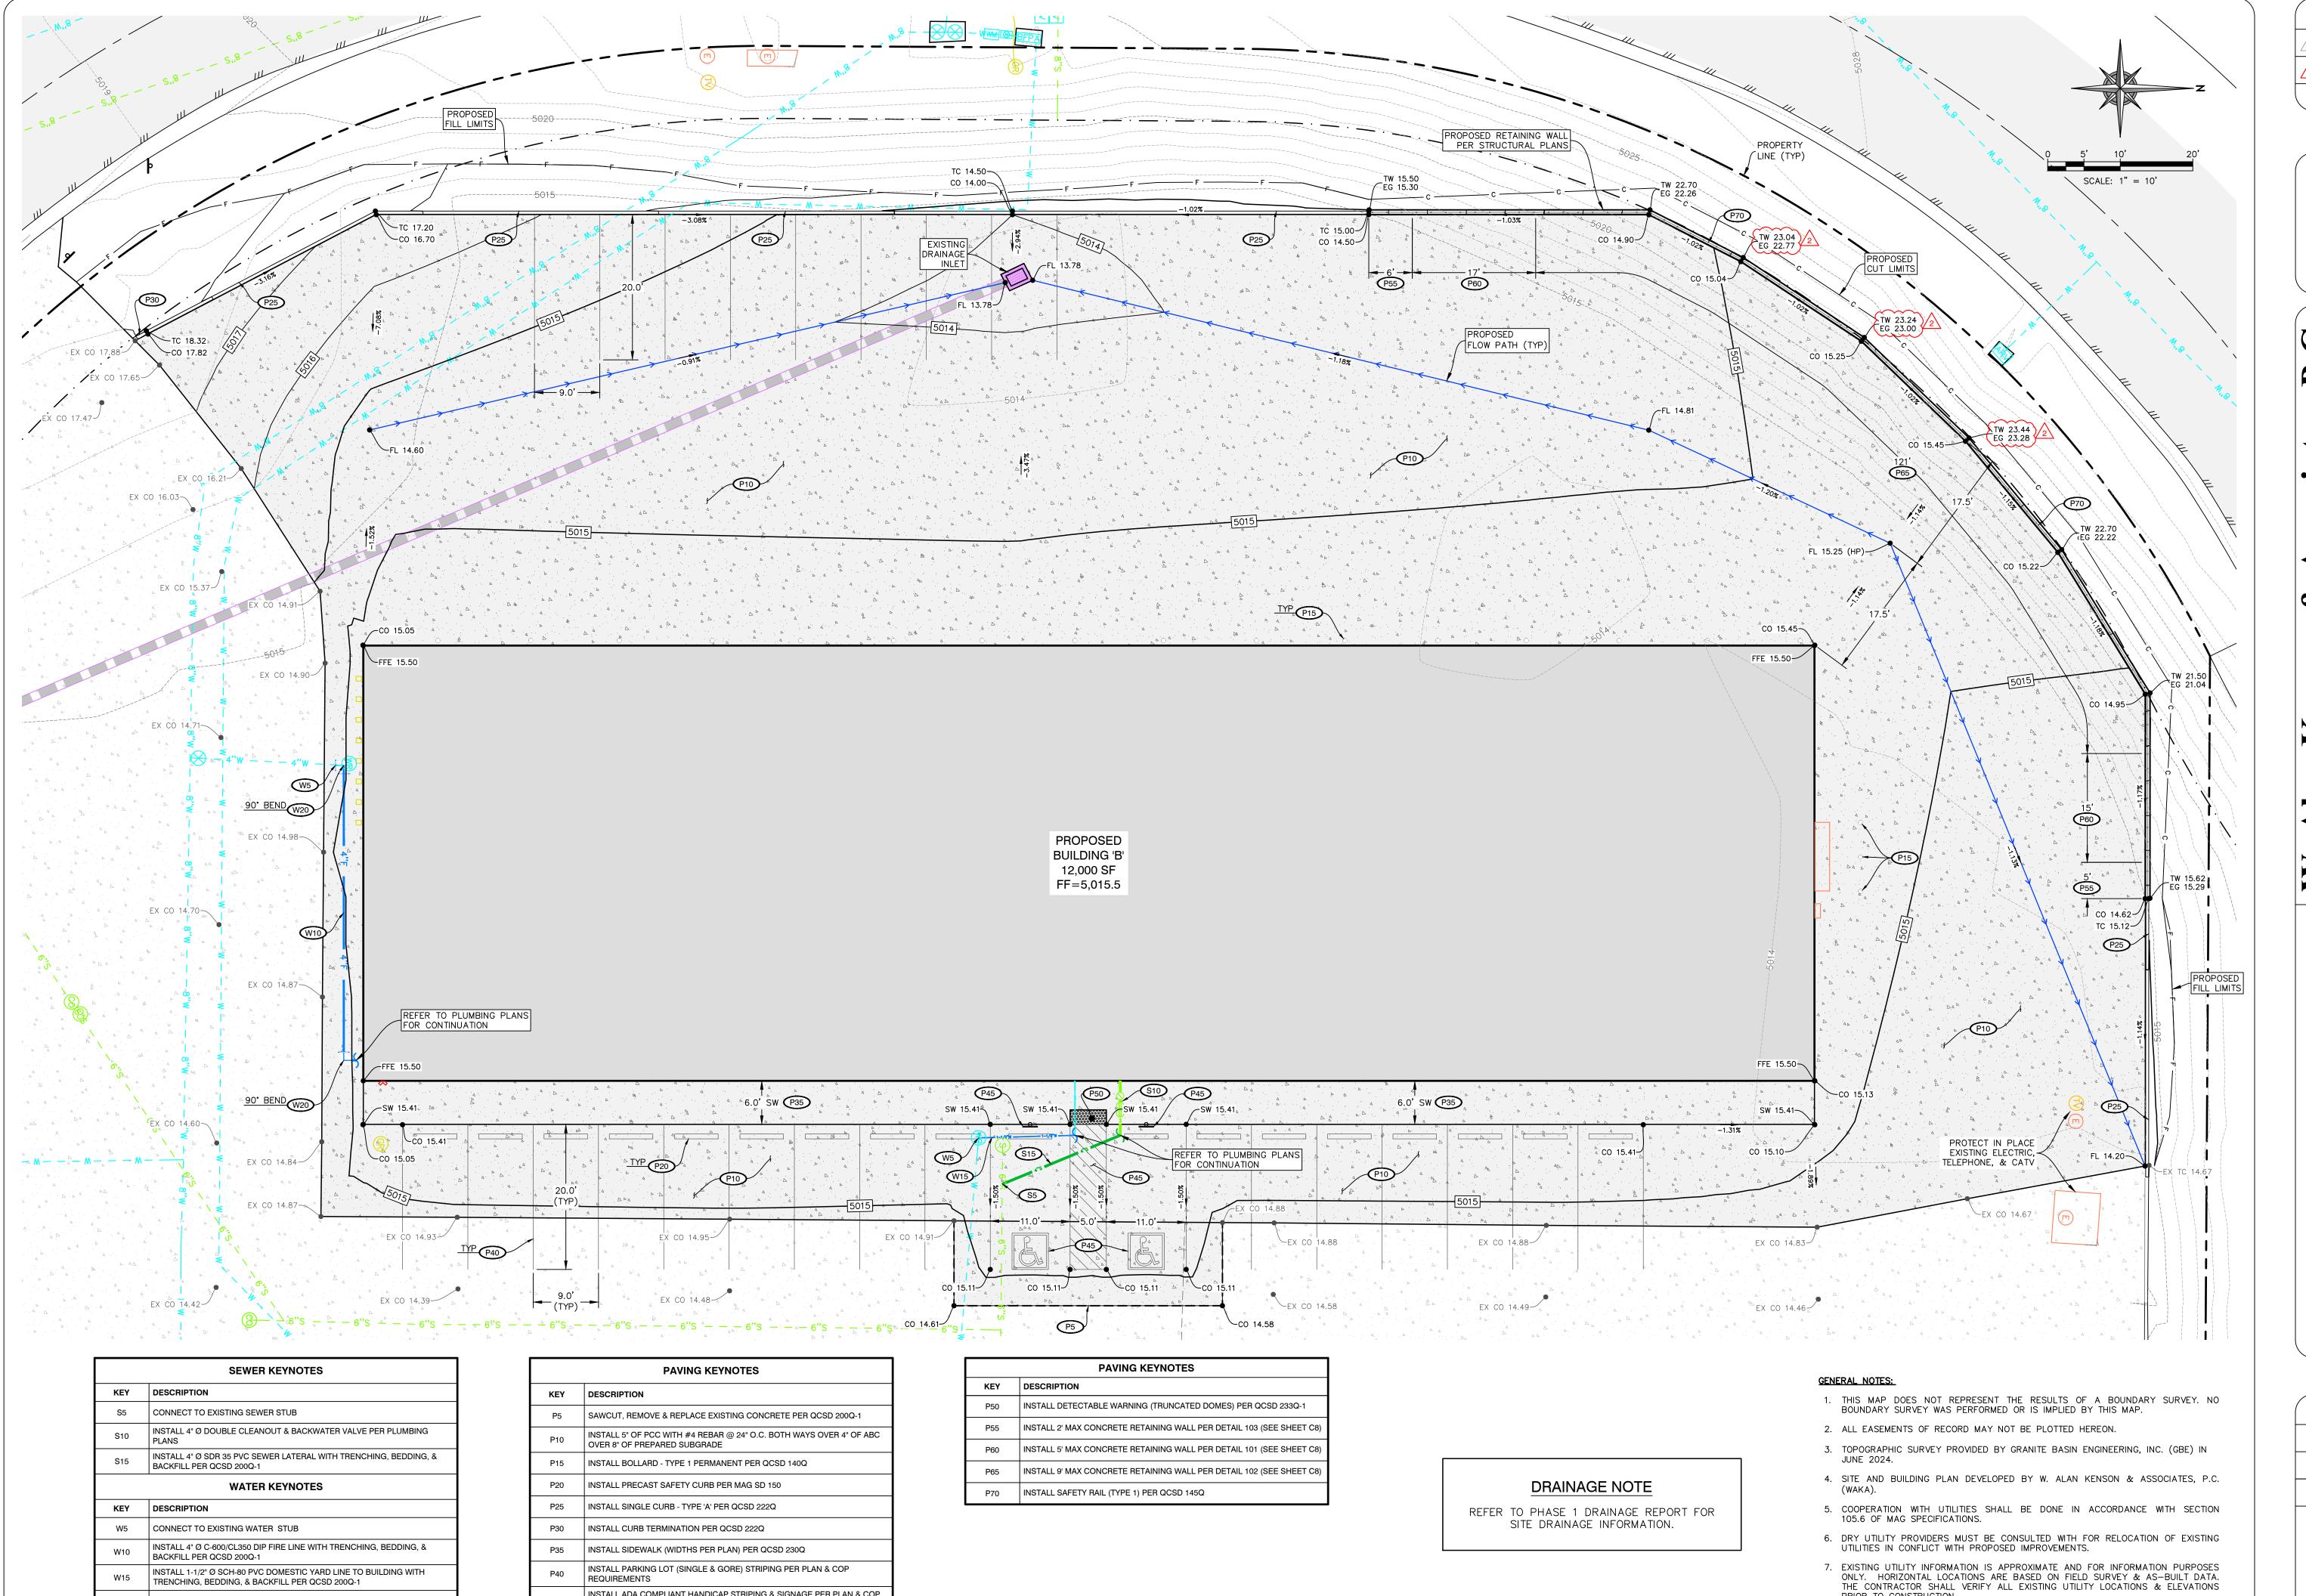

INSTALL ADA COMPLIANT HANDICAP STRIPING & SIGNAGE PER PLAN & COP


REQUIREMENTS

W20 INSTALL WATER FITING WITH JOINT RESTRAINT PER QCSDS 303Q-1 & 2

COP ROUND 1 COMMENTS

2 COMMENTS

These drawings are the property of W. Alan Kenson & Associates P.C., and may not be reproduced in any way without the written consent of W. Alan Kenson & Associates, P.C.

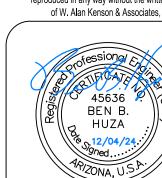


DRAWN BY CHECKED BY TS/BH


DATE December 4, 2024 JOB NO. **799** SHEET


PRIOR TO CONSTRUCTION.


8. REMOVALS SHALL BE DONE IN ACCORDANCE WITH MAG SPECIFICATIONS SECTION 350.

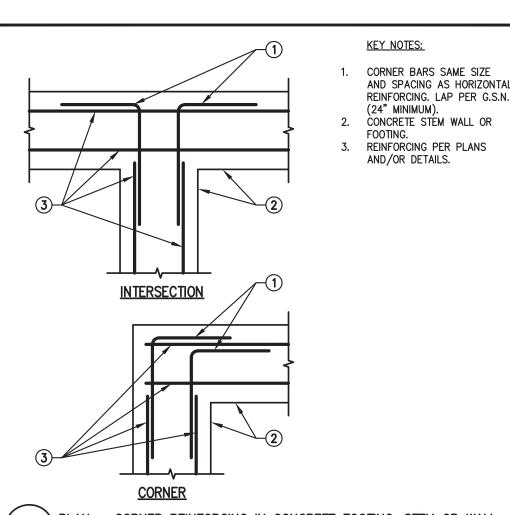

PLAN - CORNER REINFORCING IN CONCRETE FOOTING, STEM OR WALL

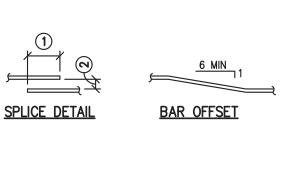

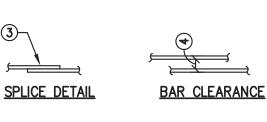


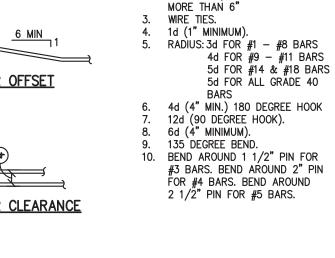



KEY NOTES:


LAP - SEE G.S.N.

MAXIMUM 1/5 LAP BUT NOT

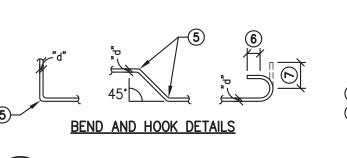

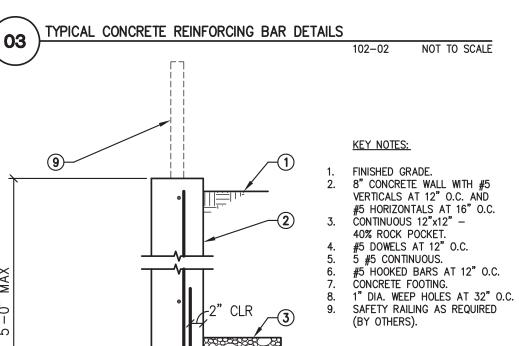

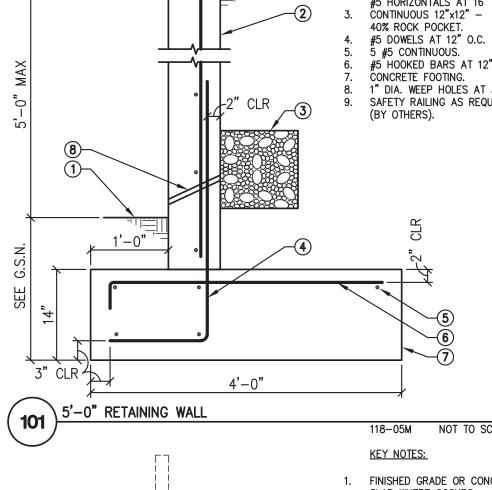

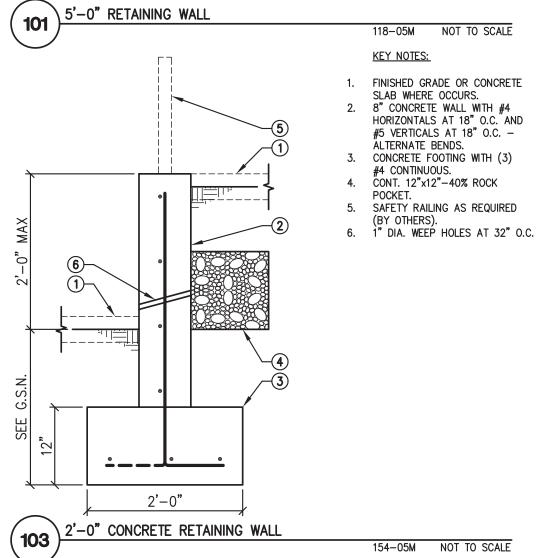


	CLASS B TENSION SPLICE LENGTHS (INCHES)					COI	MP. BARS	
CONC PSI	$f'c = \ge 2,5$	00/3,000	f'c = ≥	4,000	f'c = ≥	5,000	f'c	= ≥ 3 , 000
BAR LOCATION SIZE (METRIC)	REGULAR	TOP	REGULAR	TOP	REGULAR	TOP	STD LAP	ENCLOSED WITH SPIRAL TIES
#3 (10)	24"	31"	19"	24"	17"	22"	12"	12"
#4 (13)	32"	41"	25"	32"	22"	29"	15"	12"
# 5 (16)	39"	51"	31"	40"	28"	36"	19"	14"
#6 (19)	47"	61"	37"	48"	33"	43"	23"	17"
# 7 (22)	69"	89"	54"	70"	49"	63"	26"	20"
#8 (25)	78"	102"	62"	80"	55"	72"	30"	23"
# 9 (29)	88"	115"	70"	91"	63"	81"	34"	25"
#10 (32)	99"	129"	79"	102"	70"	91"	38"	28"
#11 (36)	110"	143"	87"	113"	78"	101"	42"	31"

KEY NOTES:

- 1. TOP BARS ARE ANY HORIZONTAL BARS PLACED SO THAT MORE THAN 12" OF FRESH CONCRETE IS CAST IN THE MEMBER BELOW THE REINFORCEMENT.
- 2. LAP SPLICES SHALL BE CLASS "B" TENSION LAP SPLICES PER LATEST EDITION OF ACI 318 UNLESS SPECIFICALLY NOTED OTHERWISE ON THE DRAWINGS OR SCHEDULES.
- 3. CONTACT STRUCTURAL ENGINEER IF CLEAR SPACING OF REINFORCEMENT IS LESS THAN OR EQUAL TO 2 BAR DIAMETERS (<), OR IF CLEAR COVER IS LESS THAN THE BAR DIAMETER (db).
- 4. THIS TABLE IS BASED ON NORMAL WEIGHT CONCRETE. 5. FOR ADDITIONAL INFORMATION, SEE G.S.N., PLANS, SCHEDULES AND DETAILS.

	COLLEDINE	FOD	DEINICODOINIO	CTEEL
(02)LAF	SCHEDULE	FUR	REINFORCING	SIEEL

NOT TO SCALE

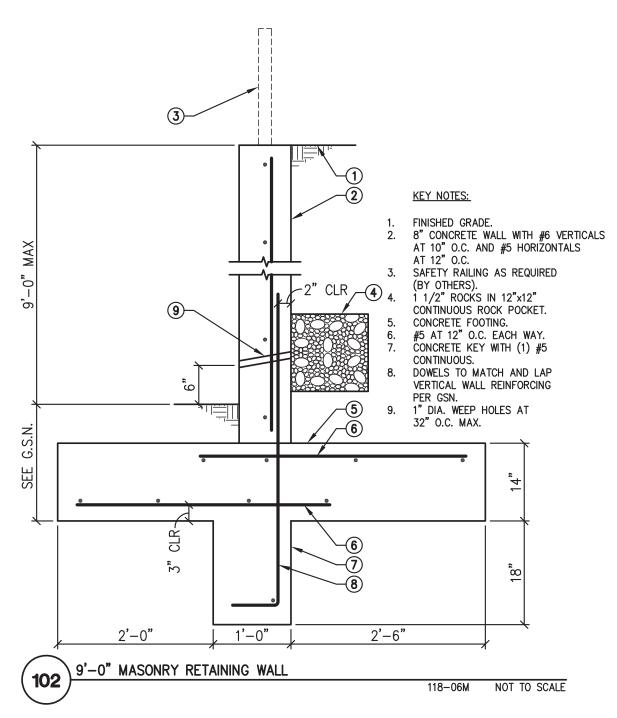

GENERAL STRUCTURAL NOTES

BUILDING CODE:

2018 INTERNATIONAL BUILDING CODE, (IBC) WITH APPLICABLE CITY AMENDMENTS.

LATERAL LOADS :

ULTIMATE DESIGN WIND SPEED = 115 MPH (3s GUST). NOMINAL DESIGN WIND SPEED = 90 MPH (3s GUST). RISK CATEGORY: II

INTERNAL PRESSURE COEFFICIENT (ENCLOSED BUILDINGS): +0.18 / -0.18

FOUNDATIONS:

SOIL REPORT BY ETC; JOB NO. 6270. SPREAD FOOTINGS SHALL BEAR ON FIRM, UNDISTURBED SOIL 24" MINIMUM BELOW ADJACENT FINISHED GRADE, PAD GRADE OR EXISTING GRADE AS STATED IN SOILS REPORT. FINISHED GRADE IS DEFINED AS TOP OF SLAB FOR INTERIOR FOOTINGS AND LOWEST ADJACENT GRADE WITHIN 5 FEET OF PERIMETER FOOTINGS.

DESIGN SOIL BEARING VALUE: 2000 PSF. (CONTINUOUS FOOTINGS)

REFER TO SOILS REPORT FOR ADDITIONAL INFORMATION PRIOR TO COMMENCEMENT OF EARTHWORK. BEFORE ANY CONCRETE IS PLACED, EXCAVATION SHALL BE CHECKED AND APPROVED BY A

STRUCTURAL CONCRETE:

ALL CAST-IN-PLACE CONCRETE CONSTRUCTION HAS BEEN DESIGNED ACCORDING TO ACI 318-14 AND SHALL CONFORM TO THE FOLLOWING:

> CEMENT SHALL CONFORM TO ASTM C-150 TYPE I OR II. MIXING SHALL CONFORM TO ASTM C-94.

AGGREGATES (NORMAL WEIGHT CONCRETE) SHALL CONFORM TO ASTM C-33. THE MINIMUM COMPRESSIVE STRENGTH OF CONCRETE (F'c) AT 28 DAYS SHALL BE:

FOUNDATIONS (DESIGN BASED ON 2,500 PSI) ----- 3,000 PSI FLAT SLABS, BEAMS, WALLS AND GRADE BEAMS ----- 3,000 PSI

- 1 ALL CONCRETE SHALL BE MECHANICALLY VIBRATED AND THOROUGHLY CONSOLIDATED DURING PLACEMENT AND SHALL BE THOROUGHLY WORKED AROUND REINFORCEMENT AND EMBEDDED FIXTURES AND INTO CORNERS OF THE FORMS UNLESS NOTED OTHERWISE.
- 2 SLUMP RANGE SHALL BE 4-6 INCHES, ADMIXTURES MAY NOT BE USED WITHOUT THE SPECIFIC PRIOR WRITTEN APPROVAL FROM THE ARCHITECT/STRUCTURAL ENGINEER. ADMIXTURES USING ANY FORM OF CHLORIDES SHALL NOT BE USED.
- 3 THE EMBEDMENT OF ANY CONDUITS, PIPES, SLEEVES, ETC. SHALL NOT BE PERMITTED WITHIN ANY CONCRETE STRUCTURAL ELEMENT (IE: COLUMNS, BEAMS, ELEVATED SLABS, ETC.) WITHOUT WRITTEN APPROVAL FROM SIMPLY STRUCTURAL INC. UNLESS NOTED OTHERWISE
- ON THE DRAWINGS. 4 FLY ASH - IF PERMITTED BY ARCHITECTURAL SPECIFICATIONS, SHALL CONFORM TO "STANDARD SPECIFICATIONS FOR COAL FLY ASH AND RAW OR CALCINED NATURAL POZZOLAN FOR USE IN CONCRETE" (ASTM C 618). FLY ASH SHALL NOT BE USED IN ARCHITECTURALLY EXPOSED CONCRETE, ON SLABS WITH A BURNISHED OR ACID FINISH, OR WHERE IT COULD NEGATIVELY
- EFFECT ANY MATERIAL IN CONTACT WITH IT. 5 TESTING OF CONCRETE - SAMPLES FOR STRENGTH TESTS OF EACH CLASS OF CONCRETE PLACED EACH DAY SHALL BE TAKEN NOT LESS THAN: ONCE A DAY, NOR LESS THAN ONCE FOR EACH 150-YD3 OF CONCRETE NOR LESS THAN ONCE FOR EACH 5,000-FT2 OF SURFACE AREA FOR SLABS OR WALLS. SAMPLES SHALL BE TAKEN IN ACCORDANCE WITH "STANDARD PRACTICE FOR MAKING AND CURING CONCRETE TEST SPECIMENS IN THE FIELD" (ASTM C 31); AND TESTED IN ACCORDANCE WITH "STANDARD TEST METHOD FOR COMPRESSIVE STRENGTH OF CYLINDRICAL
- CONCRETE SPECIMENS" (ASTM C 39) 6 TEST DATA FOR CONCRÈTE SUBMITTALS — TEST DATA SHALL BE SUBMITTED FOR REVIEW PER ACI 318 CHAPTER 5. REFERENCE TABLE R5.3 FOR SPECIFIC REQUIREMENTS.

LAP SPLICES IN CONCRETE:

- 1 LAP SPLICES SHALL BE STAGGERED A MINIMUM OF ONE LAP LENGTH AND SHALL BE CLASS B" TENSION LAP SPLICES PER ACI 318-14 UNLESS NOTED OTHERWISE. 2 DOWEL VERTICAL REINFORCING TO FOUNDATION WITH STANDARD 90-DEGREE HOOKS UNLESS
- MATCHING REINFORCING BARS SHALL BE INSTALLED IN ALL CORNERS, JAMBS AND WALL
- INTERSECTIONS (24" X 24") 4 LAPS IN WELDED WIRE FABRIC SHALL BE MADE SO THAT THE OVERLAP MEASURED BETWEEN
- OUTERMOST CROSS WIRES OF EACH FABRIC SHEET, IS NOT LESS THAN THE SPACING OF
- ONLY WHEN SPECIFICALLY NOTED ON DRAWINGS MAY CONCRETE COLUMN DOWEL EMBEDMENT AND LAP SPLICES IN CONCRETE COLUMNS BE STANDARD COMPRESSION LAP SPLICES. 6 ALL SPLICE LOCATIONS SUBJECT TO APPROVAL BY THE STRUCTURAL ENGINEER.

REINFORCING STEEL

LATEST ACI 318-14 CODE AND DETAILING MANUAL APPLY. ALL REINFORCING SHALL BE CHAIRED TO ENSURE PROPER CLEARANCES. SUPPORT OF FOUNDATION REINFORCING MUST PROVIDE ISOLATION FROM MOISTURE/CORROSION BY USE OF PLASTIC OR CONCRETE CHAIR. DUCT-TAPE COVERED REINFORCING IS NOT AN ÁCCEPTABLE CHAIR. ALL DIMENSIONS REFERENCED IN DRAWINGS AS "CLEAR" SHALL BE FROM FACE OF STRUCTURE TO EDGE OF REINFORCING, AND SHALL NOT BE LESS THAN STATED, NOR GREATER THAN "CLEAR" DIMENSION PLUS 3/8". ALL OTHERS SHALL BE PLUS OR MINUS 1/4" TYPICAL UNLESS NOTED OTHERWISE. ALL REINFORCING SHALL BE SECURELY TIED IN PLACE TO PREVENT MOVEMENT DURING CONCRETE PLACEMENT. DEFORMED REINFORCING SPECIFICATIONS AS FOLLOWS:

1 ASTM A615 (Fy = 60 KSI) FOR ALL BARS.

CLEAR CONCRETE COVERAGE'S OF ALL STEEL SHALL BE:

CAST AGAINST AND PERMANENTLY EXPOSED TO EARTH ----- 3" EXPOSED TO EARTH OR WEATHER: #6 OR LARGER ----#5 AND SMALLER ------

STRUCTURAL STEEL:

THE DESIGN, FABRICATION AND ERECTION OF STRUCTURAL STEEL FOR BUILDINGS AND STRUCTURES SHALL BE IN ACCORDANCE WITH AISC 360. FOR ALL STEEL WHERE Fy > 36 KSI, THE ASTM OR OTHER SPECIFICATION DESIGNATION SHALL BE INCLUDED NEAR THE ERECTION MARK ON EACH SHIPPING ASSEMBLY OR IMPORTANT CONSTRUCTION COMPONENT OVER ANY SHOP COAT OF PAINT PRIOR TO SHIPMENT FROM THE FABRICATOR'S PLANT. USE THE FOLLOWING MINIMUM PROPERTIES UNLESS NOTED

* ROUND HSS SHALL BE ASTM A500 GRADE C (Fy = 42 KSI).

SHOP DRAWINGS:

USE OF DRAWINGS CREATED BY SIMPLY STRUCTURAL INC. ARE NOT ACCEPTABLE FOR USE AS SHOP DRAWINGS. ANY SUBMITTALS CONTAINING SUCH WILL BE REJECTED WITHOUT REVIEW.

- 1. SIMPLY STRUCTURAL INC. ASSUMES NO RESPONSIBILITY FOR THE FAILURE OF THE CONTRACTOR TO PROVIDE SHOP DRAWINGS FOR REVIEW. SIMPLY STRUCTURAL INC. WILL REVIEW COMPLETED CONTRACTORS SHOP DRAWINGS AND OTHER APPROPRIATE SUBMITTALS THAT ARE A PROPERLY FUNCTIONING AND INTEGRAL ELEMENT OF THE OVERALL STRUCTURAL SYSTEM DESIGNED BY SIMPLY STRUCTURAL INC. REVIEWING IS INTENDED ONLY AS AN AID TO THE CONTRACTOR IN OBTAINING CORRECT SHOP DRAWINGS.
- 2. SHOP DRAWINGS SUBMITTALS SHALL INCLUDE AT A MINIMUM:
- A LAYOUT PLAN KEYED TO TRUSS/JOIST/BEAMS ETC.

B CLEARLY DEFINED DESIGN LOADS.

- C SEAL AND SIGNATURE OF A LICENSED ENGINEER IN THE STATE OF CONSTRUCTION AFFIXED DIRECTLY TO BOUND DOCUMENTS.
- 3. BEFORE SUBMITTING SHOP DRAWINGS OR ANY RELATED MATERIAL, THE CONTRACTOR SHALL:
- A REVIEW EACH SUBMISSION FOR CONFORMANCE WITH THE MEANS, METHODS, TECHNIQUES, SEQUENCES, OPERATIONS OF CONSTRUCTION, AND SAFETY PRECAUTIONS AND PROGRAMS ALL OF WHICH ARE THE SOLE RESPONSIBILITY OF THE CONTRACTOR.

B APPROVE AND STAMP AND SIGN EACH SUBMISSION BEFORE SUBMITTING IT.

- C ITEMS NOT IN ACCORDANCE WITH CONTRACT DOCUMENTS SHALL BE FLAGGED UPON CONTRACTOR'S REVIEW. SIMPLY STRUCTURAL INC. SHALL ASSUME THAT NO SHOP DRAWING OR RELATED SUBMITTAL COMPRISES A VARIATION UNLESS THE CONTRACTOR ADVISES SIMPLY STRUCTURAL INC. IN WRITING. D VERIFY ALL DIMENSIONS WITH ARCHITECT.
- 4. THE ENGINEER HAS THE RIGHT TO APPROVE OR DISAPPROVE ANY CHANGES TO CONTRACT DOCUMENTS AT ANYTIME BEFORE OR AFTER SHOP DRAWING REVIEW.
- 5. THE SHOP DRAWINGS DO NOT REPLACE THE CONTRACT DOCUMENTS. ITEMS OMITTED OR SHOWN INCORRECTLY AND ARE NOT FLAGGED BY THE STRUCTURAL ENGINEER OR ARCHITECT SHALL NOT BE CONSIDERED CHANGES TO CONTRACT DOCUMENTS. IT IS THE CONTRACTOR'S RESPONSIBILITY TO ENSURE ALL ITEMS ARE CONSTRUCTED ACCORDING TO THE CONTRACT DOCUMENTS.
- 6. SIMPLY STRUCTURAL INC. WILL REDLINE UP TO FIVE COPIES OF EACH SUBMITTAL. FOUR WILL BE RETURNED TO THE SUBMITTING PARTY OR CONTRACTOR. SIMPLY STRUCTURAL INC. WILL RETAIN ONE COPY OF EACH SUBMITTAL FOR REFERENCE AND RECORDS.

GENERAL NOTES:

- 1. THE STRUCTURAL CONSTRUCTION DOCUMENTS REPRESENT THE FINISHED STRUCTURE. THEY DO NOT INDICATE THE METHOD OF CONSTRUCTION. DURING CONSTRUCTION, THE CONTRACTOR SHALL BE RESPONSIBLE FOR THE SAFETY OF THE BUILDING AND THE CONSTRUCTION SITE. THE CONTRACTOR SHALL USE ADEQUATE SHORING, BRACING, AND GUYS IN ACCORDANCE WITH ALL NATIONAL, STATE AND LOCAL SAFETY ORDINANCES. THE STRUCTURAL ENGINEER OF RECORD SHALL NOT BE RESPONSIBLE FOR THE CONTRACTOR'S MEANS, METHODS, TECHNIQUES, SEQUENCES FOR PROCEDURE OF CONSTRUCTION, OR THE SAFETY PRECAUTIONS AND THE PROGRAMS INCIDENT THERETO (NOR SHALL OBSERVATION VISITS TO THE SITE INCLUDE OR IMPLY INSPECTION OF THESE ITEMS).
- 2. WHERE REFERENCE IS MADE TO VARIOUS TEST STANDARDS FOR MATERIALS, SUCH STANDARDS SHALL BE THE LATEST EDITION AND/OR ADDENA. ANY ENGINEERING DESIGN, PROVIDED BY OTHERS AND SUBMITTED FOR REVIEW, SHALL BEAR THE SEAL OF A REGISTERED ENGINEER RECOGNIZED BY THE BUILDING CODE JURISDICTION OF THIS PROJECT.
- 3. NOTES AND DETAILS ON DRAWINGS SHALL TAKE PRECEDENCE OVER GENERAL STRUCTURAL NOTES AND TYPICAL DETAILS. WHERE NO DETAILS ARE SHOWN, CONSTRUCTION SHALL CONFORM TO SIMILAR WORK ON THE PROJECT, AND/OR PROVIDED FOR IN THE CONTRACT DOCUMENTS. WHERE DISCREPANCIES OCCUR BETWEEN PLANS, DETAILS, GENERAL STRUCTURAL NOTES AND SPECIFICATIONS, THE MOST STRINGENT REQUIREMENT SHALL GOVERN.

4. CONTRACTOR SHALL BE RESPONSIBLE FOR VERIFICATION OF ALL DIMENSIONS WITH ARCHITECTURAL

- DRAWINGS PRIOR TO START OF CONSTRUCTION. RESOLVE ANY DISCREPANCY WITH THE ARCHITECT. ESTABLISH AND VERIFY ALL OPENINGS AND INSERTS FOR ARCHITECTURAL, CIVIL, MECHANICAL, PLUMBING AND ELECTRICAL ITEMS WITH APPROPRIATE TRADE DRAWINGS AND SUBCONTRACTORS PRIOR TO CONSTRUCTION.
- 5. TYPICAL DETAILS MAY NOT NECESSARILY BE CUT ON PLANS, BUT APPLY UNLESS NOTED OTHERWISE.
- 6. CONSTRUCTION MATERIALS SHALL BE SPREAD OUT IF PLACED ON FRAMED CONSTRUCTION, LOAD SHALL NOT EXCEED THE DESIGN LIVE LOAD PER SQUARE FOOT.
- 7. OPTIONS ARE FOR CONTRACTOR'S CONVENIENCE. IF AN OPTION IS CHOSEN, CONTRACTOR SHALL BE RESPONSIBLE FOR ALL NECESSARY CHANGES, APPROVALS AND THE COORDINATION OF THE WORK WITH ALL RELATED TRADES AND SUPPLIERS.

STATEMENT OF SPECIAL STRUCTURAL INSPECTIONS:

IN ADDITION TO THE INSPECTIONS REQUIRED BY SECTION 110 OF THE INTERNATIONAL BUILDING CODE SPECIAL STRUCTURAL INSPECTION IS REQUIRED FOR THE WORK LISTED BELOW AS STATED IN SECTION 1704 AND 1705 OF THE INTERNATIONAL BUILDING CODE. THE SPECIAL INSPECTOR SHALL OBSERVE THE WORK/TESTING ASSIGNED FOR CONFORMANCE WITH THE APPROVED DRAWINGS AND SPECIFICATIONS.

- 1. CONCRETE CONSTRUCTION: (REFERENCE IBC TABLE 1705.3)
- * CONTINUOUSLY DURING THE TAKING OF TEST SPECIMENS AND PLACING OF ALL CONCRETE. * NO INSPECTION IS REQUIRED DURING PLACEMENT OF CONCRETE FOR SLABS ON GRADE OR SPREAD FOOTINGS FOR LIGHT FRAMED BUILDINGS UP TO 3 STORIES TALL (PLACEMENT OF
- ALL SLAB AND FOOTING REINFORCING REQUIRES SPECIAL INSPECTION AS NOTED BELOW).
- * VERIFY USE OF REQUIRED DESIGN STRENGTH.

AT (602) 443-0303 PRIOR TO STARTING CONSTRUCTION.

- REINFORCING STEEL: (REFERENCE IBC SECTION 1705.3 AND TABLE 1705.3) INSPECTION OF IN PLÀCE REINFORCING. THE SPECIAL INSPECTOR NEED NÓT BE PRESENT CONTINUOUSLY DURING PLACEMENT OF REINFORCING STEEL PROVIDED THE SPECIAL INSPECTOR HAS INSPECTED FOR CONFORMANCE. PRIOR TO CLOSING FORMS OR THE DELIVERY OF CONCRETE TO THE JOBSITE. FOR ALL CONCRETE HAVING SPECIAL STRUCTURAL INSPECTION PER ITEM 1.
- * FOR SLABS ON GRADE. * FOR CONCRETE FOOTINGS.

SPECIAL STRUCTURAL INSPECTION NOTES:

- 1. CONTACT SIMPLY STRUCTURAL INC. PRIOR TO THE START OF CONSTRUCTION FOR ADDITIONAL INFORMATION.
- 2. SPECIAL INSPECTOR SHALL FURNISH INSPECTION REPORTS TO THE BUILDING OFFICIAL, THE ENGINEER OR ARCHITECT OF RECORD, AND OTHER DESIGNATED PERSONS AT A MINIMUM OF 3. THE SPECIAL INSPECTOR SHALL SUBMIT A FINAL SIGNED REPORT STATING WHETHER THE WORK
- REQUIRING SPECIAL INSPECTION WAS, TO THE BEST OF THE INSPECTOR'S KNOWLEDGE, IN CONFORMANCE TO THE APPROVED PLANS AND SPECIFICATIONS AND THE APPLICABLE WORKMANSHIP PROVISIONS OF THE BUILDING CODE.
- 4. ALL DISCREPANCIES SHALL BE BROUGHT TO THE IMMEDIATE ATTENTION OF THE CONTRACTOR, THEN, IF UNCORRECTED, THE PROPER DESIGN AUTHORITY AND THE BUILDING OFFICIAL. THE SPECIAL INSPECTOR IS NOT AUTHORIZED TO APPROVE DEVIATIONS FROM THE DESIGN DRAWINGS
- OR SPECIFICATIONS. 5. CONTRACTOR SHALL PROVIDE THE SPECIAL INSPECTOR SAFE ACCESS TO ALL ITEMS REQUIRING SPECIAL INSPECTION. ACCESS SHALL BE PROVIDED VIA IN-PLACE LADDERS, SCAFFOLDING, AND/OR CONTRACTOR OPERATED LIFTS AS REQUIRED FOR SAFE OBSERVATION.
- 6. SPECIAL INSPECTIONS SHALL BE PERFORMED UNDER THE DIRECT SUPERVISION OF A STATE LICENSED STRUCTURAL ENGINEER. WHO IS FAMILIAR WITH THE STRUCTURAL DESIGN OF THIS PROJECT. THE SUPERVISING <u>STRUCTURAL ENGINEER</u> SHALL SEAL THE SPECIAL INSPECTION CERTIFICATE. 7. CONTACT SIMPLY STRUCTURAL INC. FOR SPECIAL STRUCTURAL INSPECTIONS IN THE PHOENIX AREA


SPECIAL GEOTECHNICAL INSPECTION:

1. EXCAVATION, GRADING AND FILL (BY SOILS ENGINEER) (REFERENCE TABLE 1705.6). SOILS ENGINEER SHALL PROVIDE OBSERVATION AND TESTING SERVICES DURING THE GRADING AND FOUNDATION PHASE OF CONSTRUCTION. INSPECTION AND TESTING REPORTS SHALL BE SUBMITTED TO THE BUILDING DEPARTMENT AND SIMPLY STRUCTURAL INC.

STANDARD ABBREVIATIONS

	STANDARD A	DDNEVI	ATIONS
A.B	ANCHOR BOLT	I.J	ISOLATION JOINT
	AGGREGATE BASE COURSE		INFORMATION
	AIR CONDITIONER		INTERIOR
	ABOVE FINISHED FLOOR	JT	JOINT
ALT		K(KIP)	1000 POUNDS
APPROX	APPROXIMATELY	L	
@	AT (MEASUREMENT)	LBS (#)	POUNDS
ARCH	ARCHITECTURAL	LG	LONG
BLDG		L.L	LIVE LOAD
ВМ			LONG LEG HORIZONTAL
	BELOW FINISHED FLOOR		LONG LEG VERTICAL
	BOTTOM OF BEAM		LONGITUDINAL
	BOTTOM OF DECK		MANUFACTURER
	BOTTOM OF FOOTING		MASONRY
BOTT			MASONRY CONTROL JOINT
BRG			MATERIAL
	CANTILEVER		MAXIMUM
	CAST IN PLACE CONSTRUCTION JOINT		MINIMUM MISCELLANEOUS
	CONSTRUCTION JOINT		
CL ======= CLR. =======		•	NOT APPLICABLE NOT TO SCALE
	CONCRETE MASONRY UNIT		ON CENTER
COL			OPENING
CONC			PREFABRICATED
	CONTINUOUS	PL	
	CONTRACTOR		POUNDS PER LINEAR FOOT
CTR			POUNDS PER SQUARE FOOT
DTL			POUNDS PER SQUARE INCH
DIA			POST TENSION OR PRESSURE
DIM			REINFORCING
D.L		REQ'D	
ø OR DIA	DIAMETER	REV	REVISED/ REVISION
DN	DOWN	SCHED	
DWG		SIM	SIMILAR
EA	EACH	S.I.P	STRUCTURAL INSULATED PANE
E.E			SHORT LEG HORIZONTAL
E.F			SHORT LEG VERTICAL
	EXPANSION JOINT	SQ	
EL			STANDARD
EQ			SHEARWALL
E.W		STL	
EXIST			STRUCTURAL
EXP FIN			TOP CHORD TOP OF BEAM
FIR			TOP OF BEAM
	FOUNDATION		TOP OF FOOTING
	FINISHED FLOOR		TOP OF LEDGER
FT			TOP OF MASONRY
FTG			TOP OF PLATE
GA			TOP OF STEEL
	GALVANIZED		TOP OF WALL
	GENERAL CONTRACTOR		TRANSVERSE
	GLUE-LAMINATED BEAM	TYP	
	GENERAL STRUCTURAL NOTES		UNLESS NOTED OTHERWISE
	HEADED ANCHOR STUD	VERT	VERTICAL
	HOLLOW CORE		VALLEY SET
HG		WD	
HORIZ	HORIZONTAL	W/	WITH
	HIGH POINTS	W/C	WATER/CEMENT RATIO
	INTERNATIONAL BUILDING CODE		WITHOUT
	INTERNATIONAL CODE COUNSEL		WORK POINT
I.R.C	INTERNATIONAL RESIDENTIAL CODE	W.W.F	WELDED WIRE FABRIC
		1	



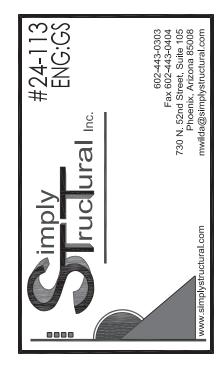

THESE DRAWINGS ARE THE INSTRUMENTS OF SERVICE AND ARE THE PROPERTY OF SIMPLY STRUCTURAL INC · SIMPLY STRUCTURAL INC. EXPRESSLY RESERVES ITS COMMON LAW COPYRIGHT AND OTHER PROPERTY RIGHTS TO THESE PLANS. THESE PLANS ARE NOT TO BE REPRODUCED, CHANGED OR COPIE

IN ANY FORM OR MANNER

WHATSOEVER, NOR ARE THEY TO

BE ASSIGNED TO ANY THIRD

PARTY, WITHOUT FIRST OBTAININ

THE EXPRESSED WRITTEN

PERMISSION AND CONSENT OF

SIMPLY STRUCTURAL INC.

TREATED


WRITTEN DIMENSIONS ON THEST DRAWINGS SHALL HAVE PRECEDEN OVER SCALED DIMENSIONS. COPYRIGHT 2024, SIMPLY STRUCTURAL IN APPROVAL AND CERTIFICATION: 3

DAYS PAYMENT PERIOD: 7 DAYS CONTRAC



Checked By: AS NOTED 7/24/24

#24-113

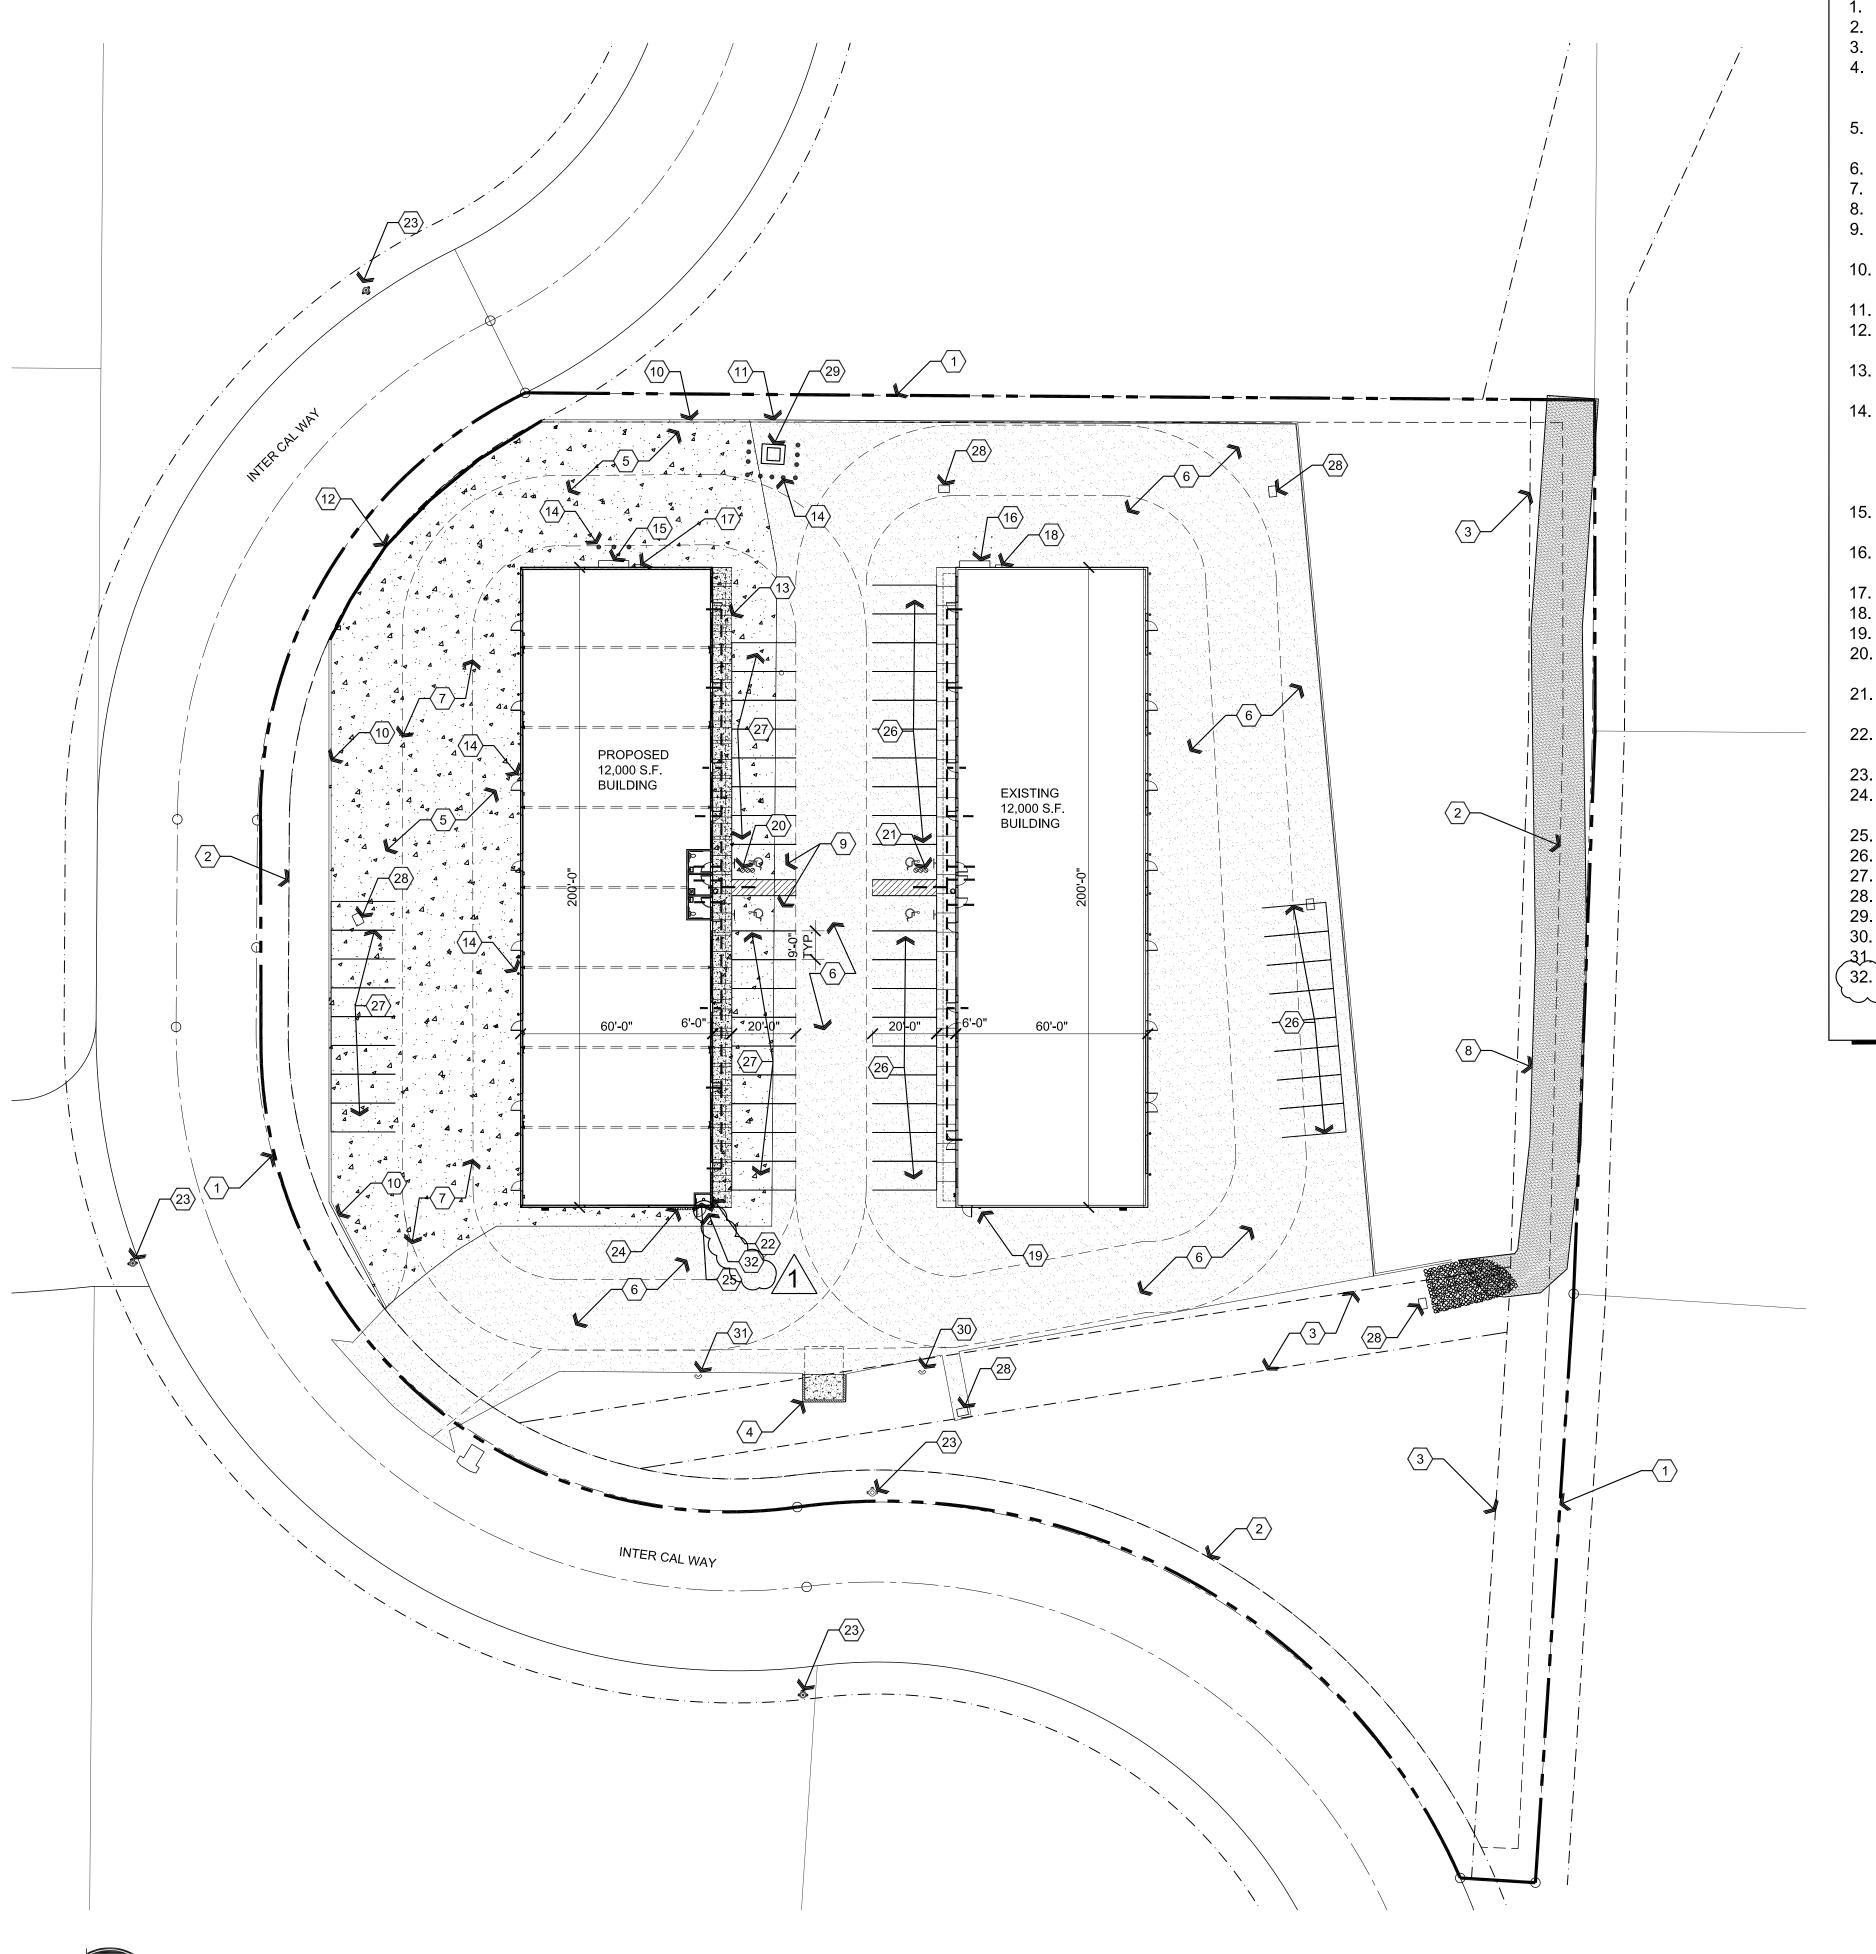

Architectural Site Plan

Descriptive Keynotes \bigcirc

1. PROPERTY LINE.

2. BUILDING SETBACK LINE.

3. EASEMENT LINE.

4. EXISTING 6'-0" HIGH DUMPSTER ENCLOSURE IN ACCORDANCE WITH CITY OF PRESCOTT'S STANDARD DETAIL NO. 4-15P.

5. PROVIDE CONCRETE PAVEMENT OVER COMPACTED A.B.C., REFER TO CIVIL PLANS.

6. EXISTING CONCRETE PAVEMENT.

7. PROPOSED 20' FIRE LANE.

8. EXISTING GROUTED OPEN CHANNEL.

9. PROVIDE ADA ACCESSIBLE PARKING, REFER TO DETAILS C1/A0.1 & D1/A0.1, AND CIVIL PLANS.

10. PROVIDE CAST IN PLACE CONCRETE CURB, REFER TO CIVIL PLANS.

11. EXISTING CONCRETE CURB.

12. PROVIDE CONCRETE RETAINING WALL, REFER TO CIVIL PLANS.

13. PROVIDE CONCRETE SIDEWALK OVER COMPACTED A.B.C., REFER TO CIVIL PLANS.

14. PROVIDE 6'-0" LONG, 4" DIAMETER, CONCRETE FILLED, PROTECTIVE STEEL BOLLARDS, EMBEDDED 2'-0" BELOW GRADE INTO CONCRETE FOOTING, TYPICAL AT EACH ROLL-UP DOOR AND AS INDICATED ELSEWHERE.

15. PROVIDE ELECTRICAL SERVICE ENTRANCE SECTION, REFER TO ELECTRICAL PLANS.

16. EXISTING ELECTRICAL SERVICE ENTRANCE SECTION.

17. PROVIDE CABLE TV TERMINAL BOX.

18. EXISTING CABLE TV TERMINAL BOX.

19. EXISTING NATURAL GAS METERS / REGULATORS. 20. PROVIDE 2-WAY SEWER CLEAN OUT AND

BACKWATER VALVE, REFER TO PLUMBING PLANS. 21. EXISTING 2-WAY SEWER CLEAN OUT AND

BACKWATER VALVE. 22. PROVIDE FIRE DEPARTMENT CONNECTION WITH

LOCKING CAPS.

23. EXISTING FIRE HYDRANT.

24. PROVIDE NATURAL GAS METERS / REGULATORS, REFER TO PLUMBING PLANS.

25. PROVIDE FIRE RISER.

26. EXISTING PARKING SPACE, TYP.

27. PROVIDE PARKING SPACE, TYP.

28. EXISTING DRAINAGE BASIN. 29. EXISTING ELECTRICAL TRANSFORMER.

30. EXISTING REMOTE FDC.

31_PROVIDE REMOTE FDC.

32. PROVIDE FIRE DEPARTMENT KNOX BOX.

PREVIOUS PERMIT # B2105-010

REVISIONS

10/8/2024

City of Prescott Comments 10/8/2024 LO

These drawings are the property of


W. Alan Kenson & Associates P.C.,

and may not be reproduced in any

way without the written consent of

W. Man Kenson & Associates, P.C.


CHECKED BY W.A.K. July 31st, 2024

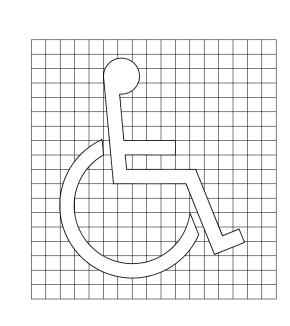

PROPORTIONS





DISPLAY CONDITIONS

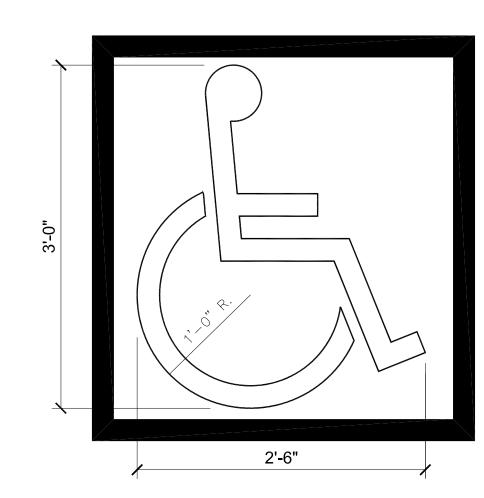

SYMBOL @ PARKING SPACE



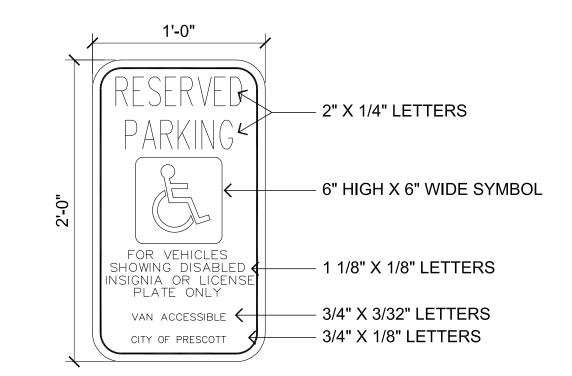

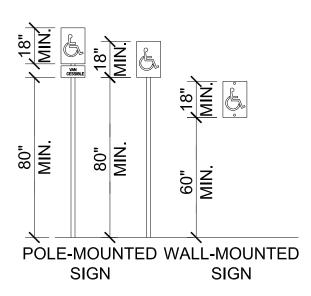

- 1. THE SIGN PLATE SHALL BE A MINIMUM OF 12"x24" WITH A THICKNESS OF .080 ALUMINUM CONSTRUCTION.
- 2. THE SIGN FACE SHALL HAVE A WHITE REFLECTIVE BACKGROUND WITH A BLUE LEGEND. (STANDARD 3M SCOTCHLITE SIGN FACE NUMBER R7-32 OR EQUIVALENT, WITH BLUE SCREEN PRINTED LETTER AS SHOWN ABOVE.)
- 3. ALL ACCESSIBLE PARKING SPACES SHALL BE IDENTIFIED BY A SIGN ON A CITY APPROVED STATIONARY POST OR WALL LOCATION. THESE SIGNS SHALL NOT BE OBSCURED.
- 4. ACCESSIBLE PARKING SPACES SHALL BE DESIGNATED AS RESERVED FOR PHYSICALLY DISABLED BY A SIGN SHOWING THE INTERNATIONAL WHEELCHAIR SYMBOL IN COLOR SCHEME ON CONTRASTING BACKGROUND.
- THE SIGN SHALL HAVE THE MINIMUM VERBIAGE OF "RESERVED PARKING" AND INTERNATIONAL WHEELCHAIR SYMBOL.



Kenson & Associates, P.C.
P.O. Box 11593

These drawings are the property of

A H

acting Building B Cal Way Z 86301

SC Contracting Buildir 6601 Inter Cal Way Prescott, AZ 86301

PROJECT: JSC Co 6601 In Prescot

DRAWING:


DRAWN BY
L.O.

CHECKED BY
W.A.K.

July 31st, 2024


JOB NO.
799

A0.1

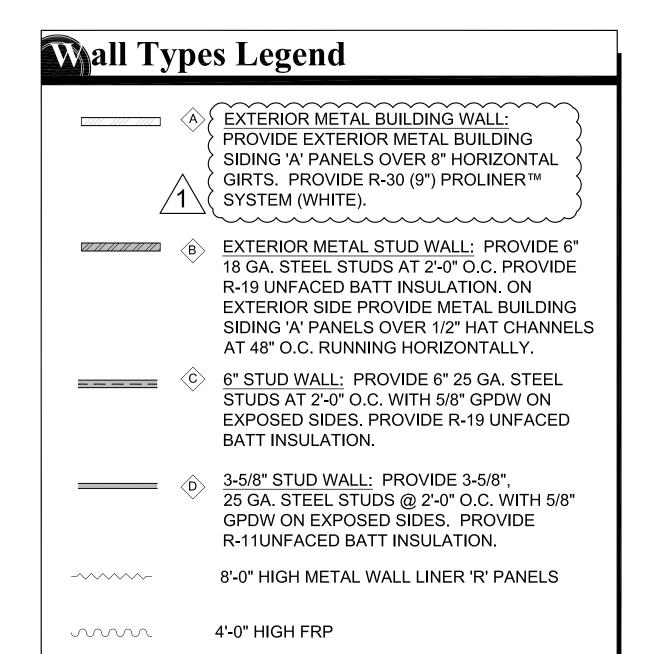



- PROPOSED POTENTIAL FUTURE LOCATION OF WALLS.
- 2. PROVIDE 4" CONCRETE SIDEWALK OVER 4" COMPACTED A.B.C., REFER TO SITE PLAN AND CIVIL PLANS.
- 3. PROVIDE INTERIOR WALL, REFER TO WALL TYPES LEGEND FOR TYPE OF CONSTRUCTION.
- 4. PROVIDE ELECTRICAL SERVICE ENTRANCE SECTION, REFER TO ELECTRICAL PLANS.
- 5. PROVIDE TYPE 2A10BC FIRE EXTINGUISHER IN SURFACE MOUNTED WALL CABINET. FIRE EXTINGUISHERS SHALL BE PROVIDED IN ACCORDANCE WITH THE INTERNATIONAL FIRE CODE (IFC) AND NFPA 10.
- 6. PROVIDE FIRE ALARM CONTROL PANEL.
- 7. PROVIDE DOOR, REFER TO DOOR SCHEDULE. (TYPICAL)
- 8. PROVIDE ROLL UP DOOR, REFER TO DOOR SCHEDULE. (TYPICAL)
- 9. PROVIDE STEEL COLUMN, REFER TO STRUCTURAL PLANS. (TYPICAL)
- 10. ELECTRIC DRINKING FOUNTAIN, REFER TO PLUMBING PLANS.
- 11. LINE OF CANOPY ABOVE.
- 12. PROVIDE A 6"x9" BLUE TACTILE, BRAILLE, 'EXIT' SIGN AS MANUFACTURED BY 'SIMPLY EXIT SIGNS (#SE-1980)' OR EQUAL COMPLYING WITH ICC/ANSI A117.1 SECTION 703.1 AND IBC 1013 & SECTION 1111, ADJACENT TO EACH DOOR TO AN EXIT PASSAGEWAY AND THE EXIT DISCHARGE.

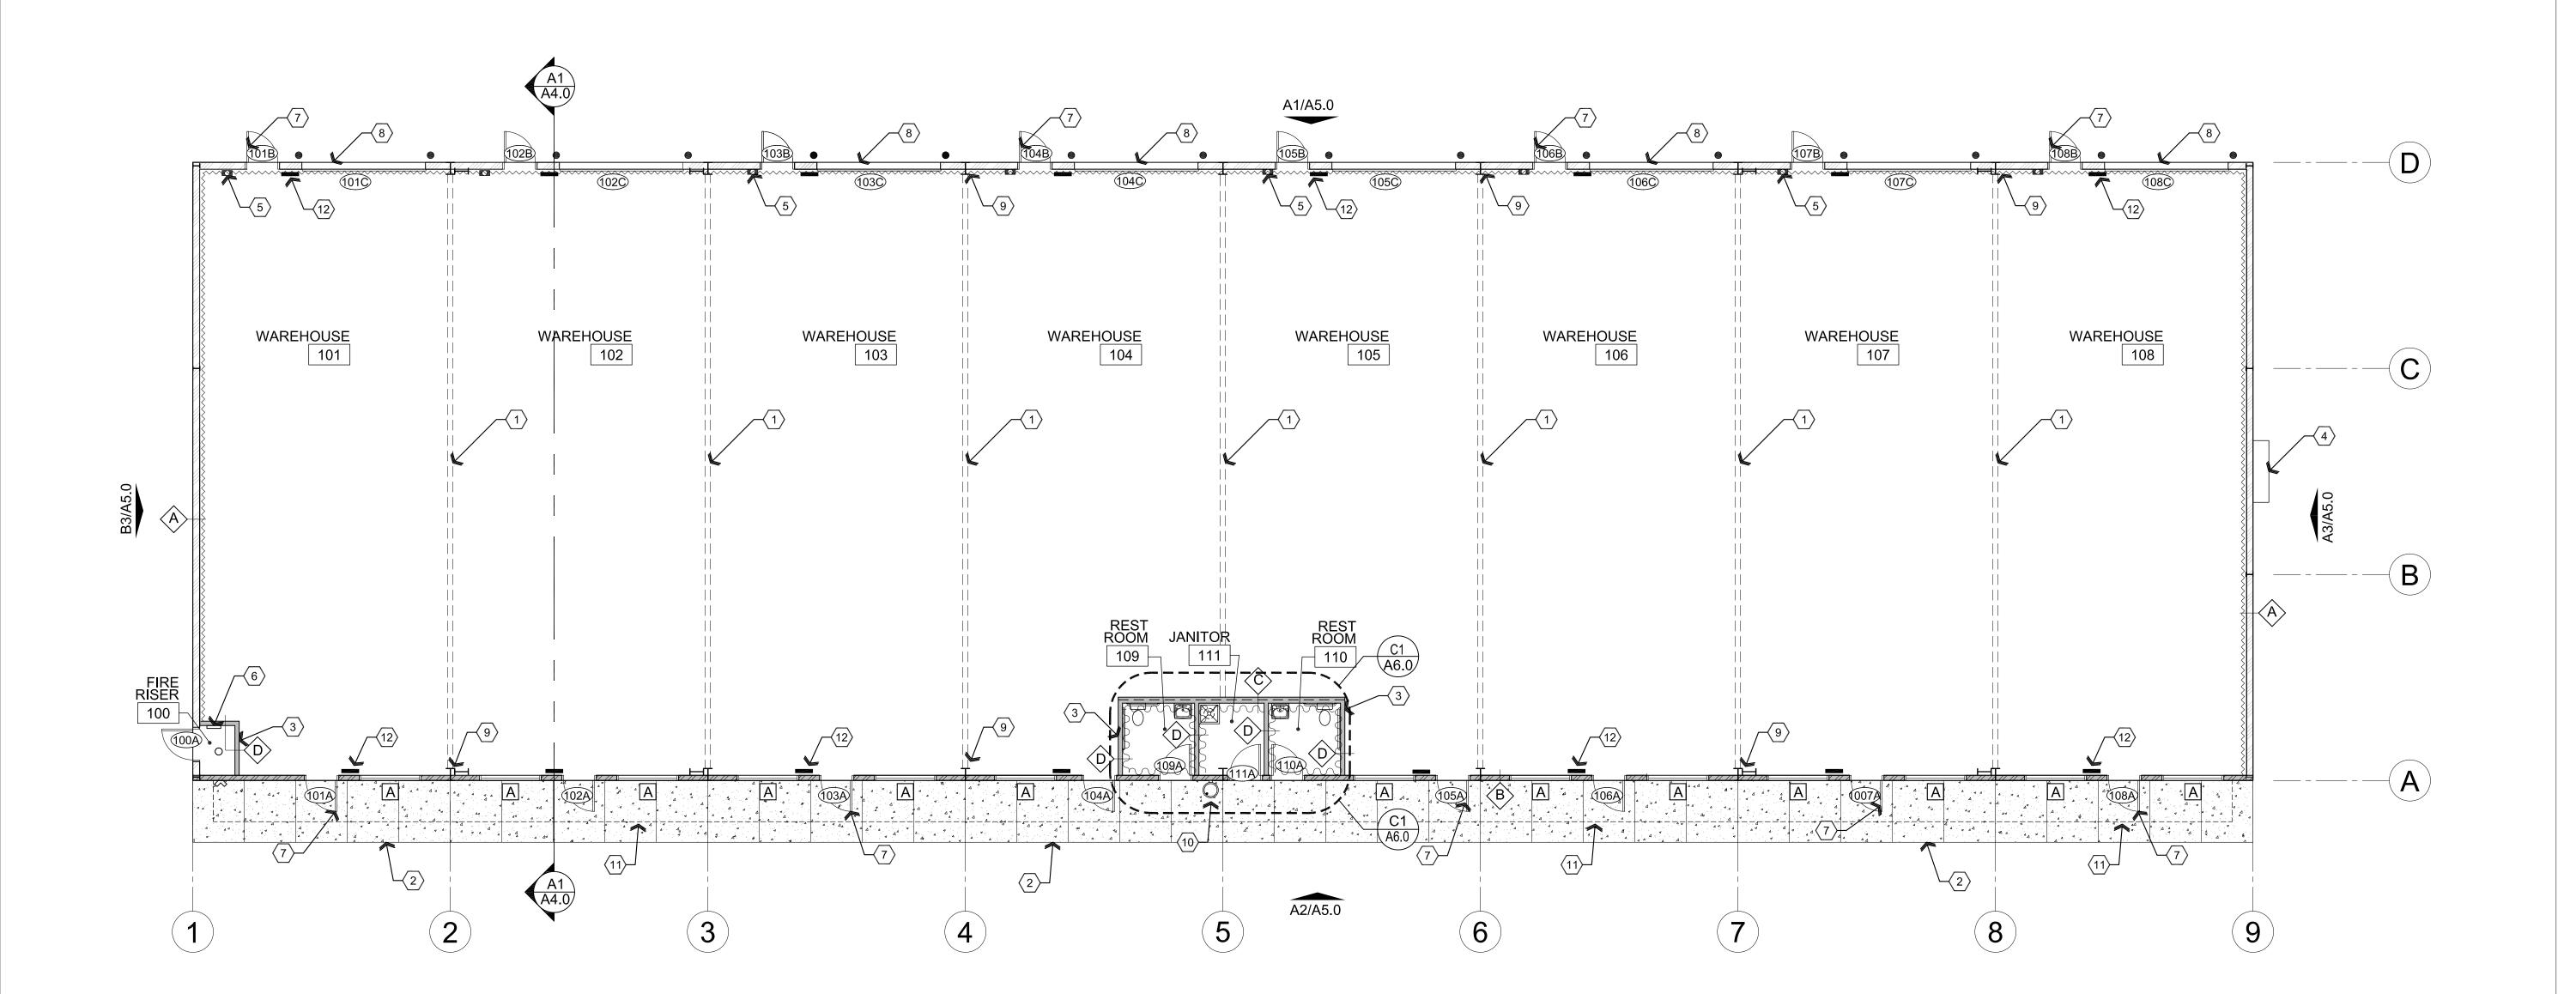

Reference / Wall Types Floor Plan

EXIT SIGNS:

PROVIDE A 6"x9" BLUE TACTILE, BRAILLE, 'EXIT' SIGN AS

AND THE EXIT DISCHARGE.

MANUFACTURED BY 'SIMPLY EXIT SIGNS (#SE-1980)' OR EQUAL COMPLYING WITH ICC/ANSI A117.1 SECTION 703.1 AND IBC 1013 & SECTION 1111, ADJACENT TO EACH DOOR TO AN EXIT PASSAGEWAY


REVISIONS **~~~~** (City of Prescott Comments 10/08/2024

These drawings are the property of W. Alan Kenson & Associates P.C., and may not be reproduced in any way without the written consent of

W. Alan Kenson & Associates, P.C.

L.O. CHECKED BY W.A.K.

July 31st, 2024

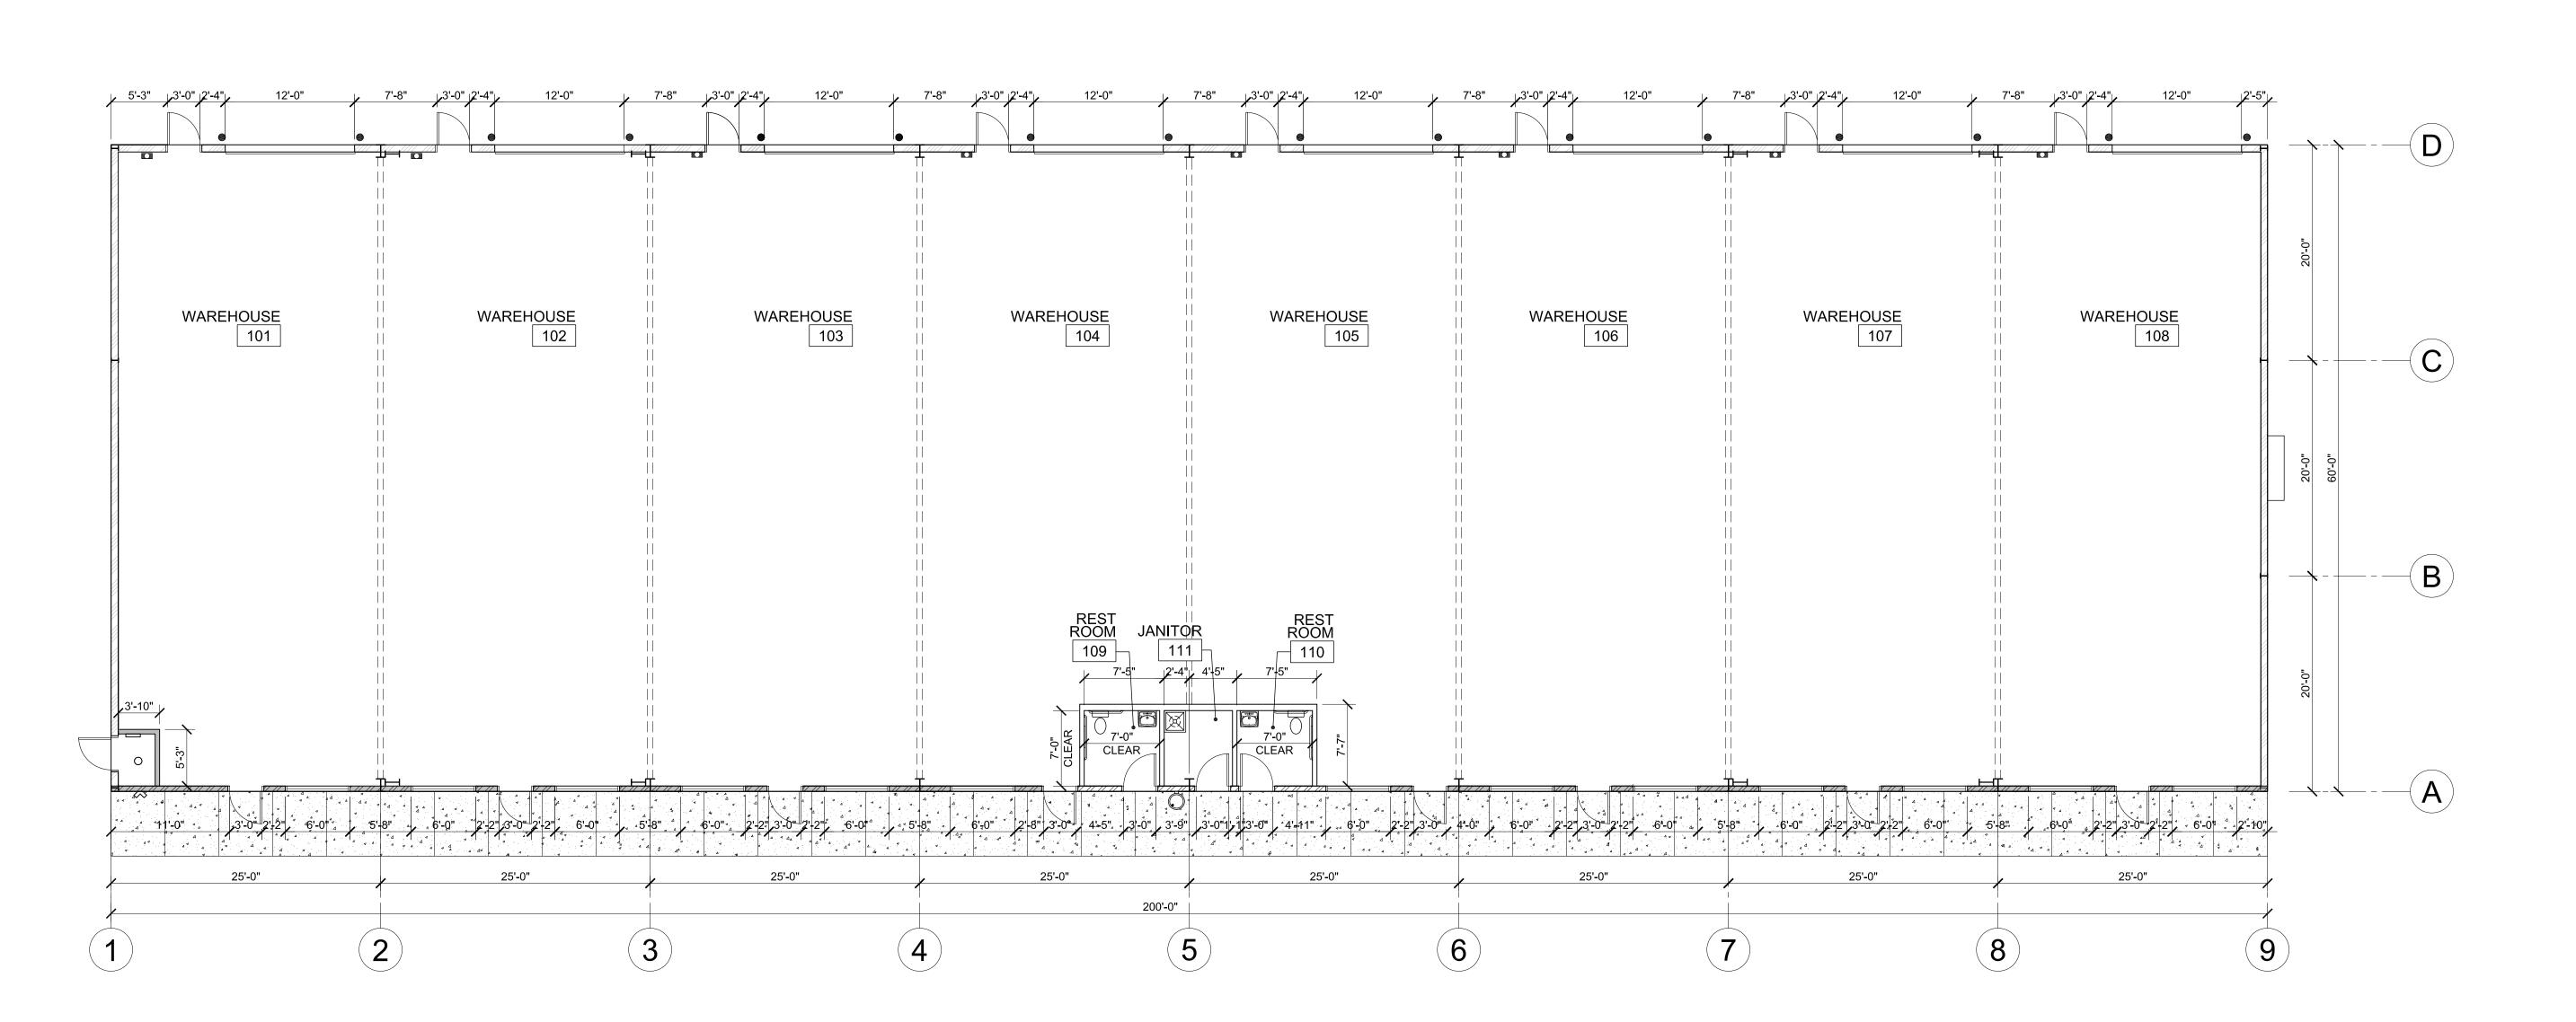

W. Alan Kenson & Associates, P.C

REVISIONS

These drawings are the property of W. Alan Kenson & Associates P.C., and may not be reproduced in any way without the written consent of W. Alan Kenson & Associates, P.C.

G: Dimension Floor Plan

[: JSC Contracting Building B

PROJECT: JSC Contracting 6601 Inter Cal W

DRAWN BY
L.O.
CHECKED BY
W.A.K.

July 31st, 2024


A1.1

JOB NO. **799**


SHEET


Dimension Floor Plan




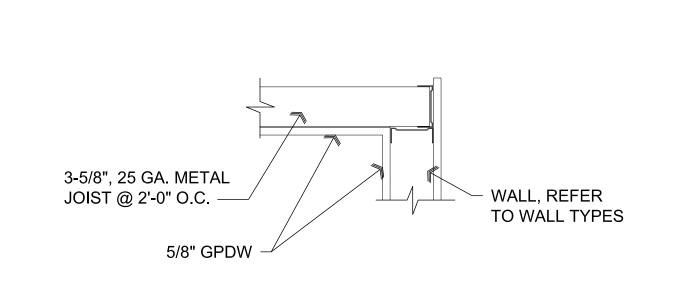

Reflected Ceiling Plan

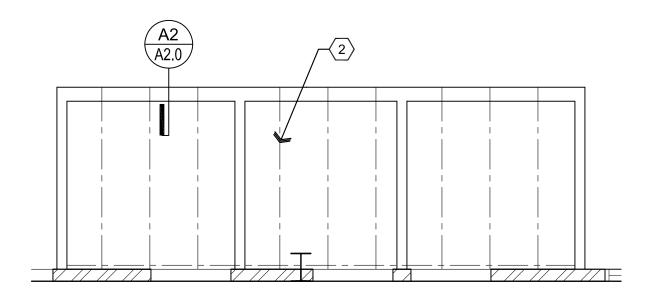

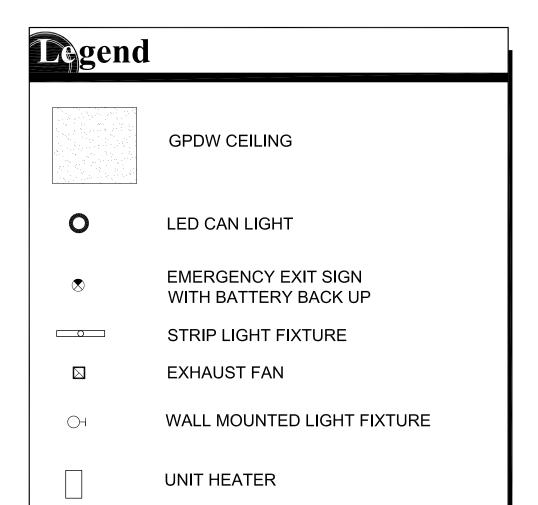


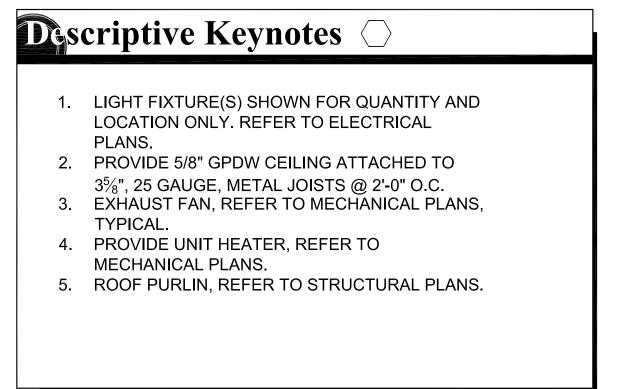

Ceiling Framing Detail

Scale: 1 1/2" = 1'-0"

Bartial Ceiling Framing PlanScale: 1/4"=1'-0"

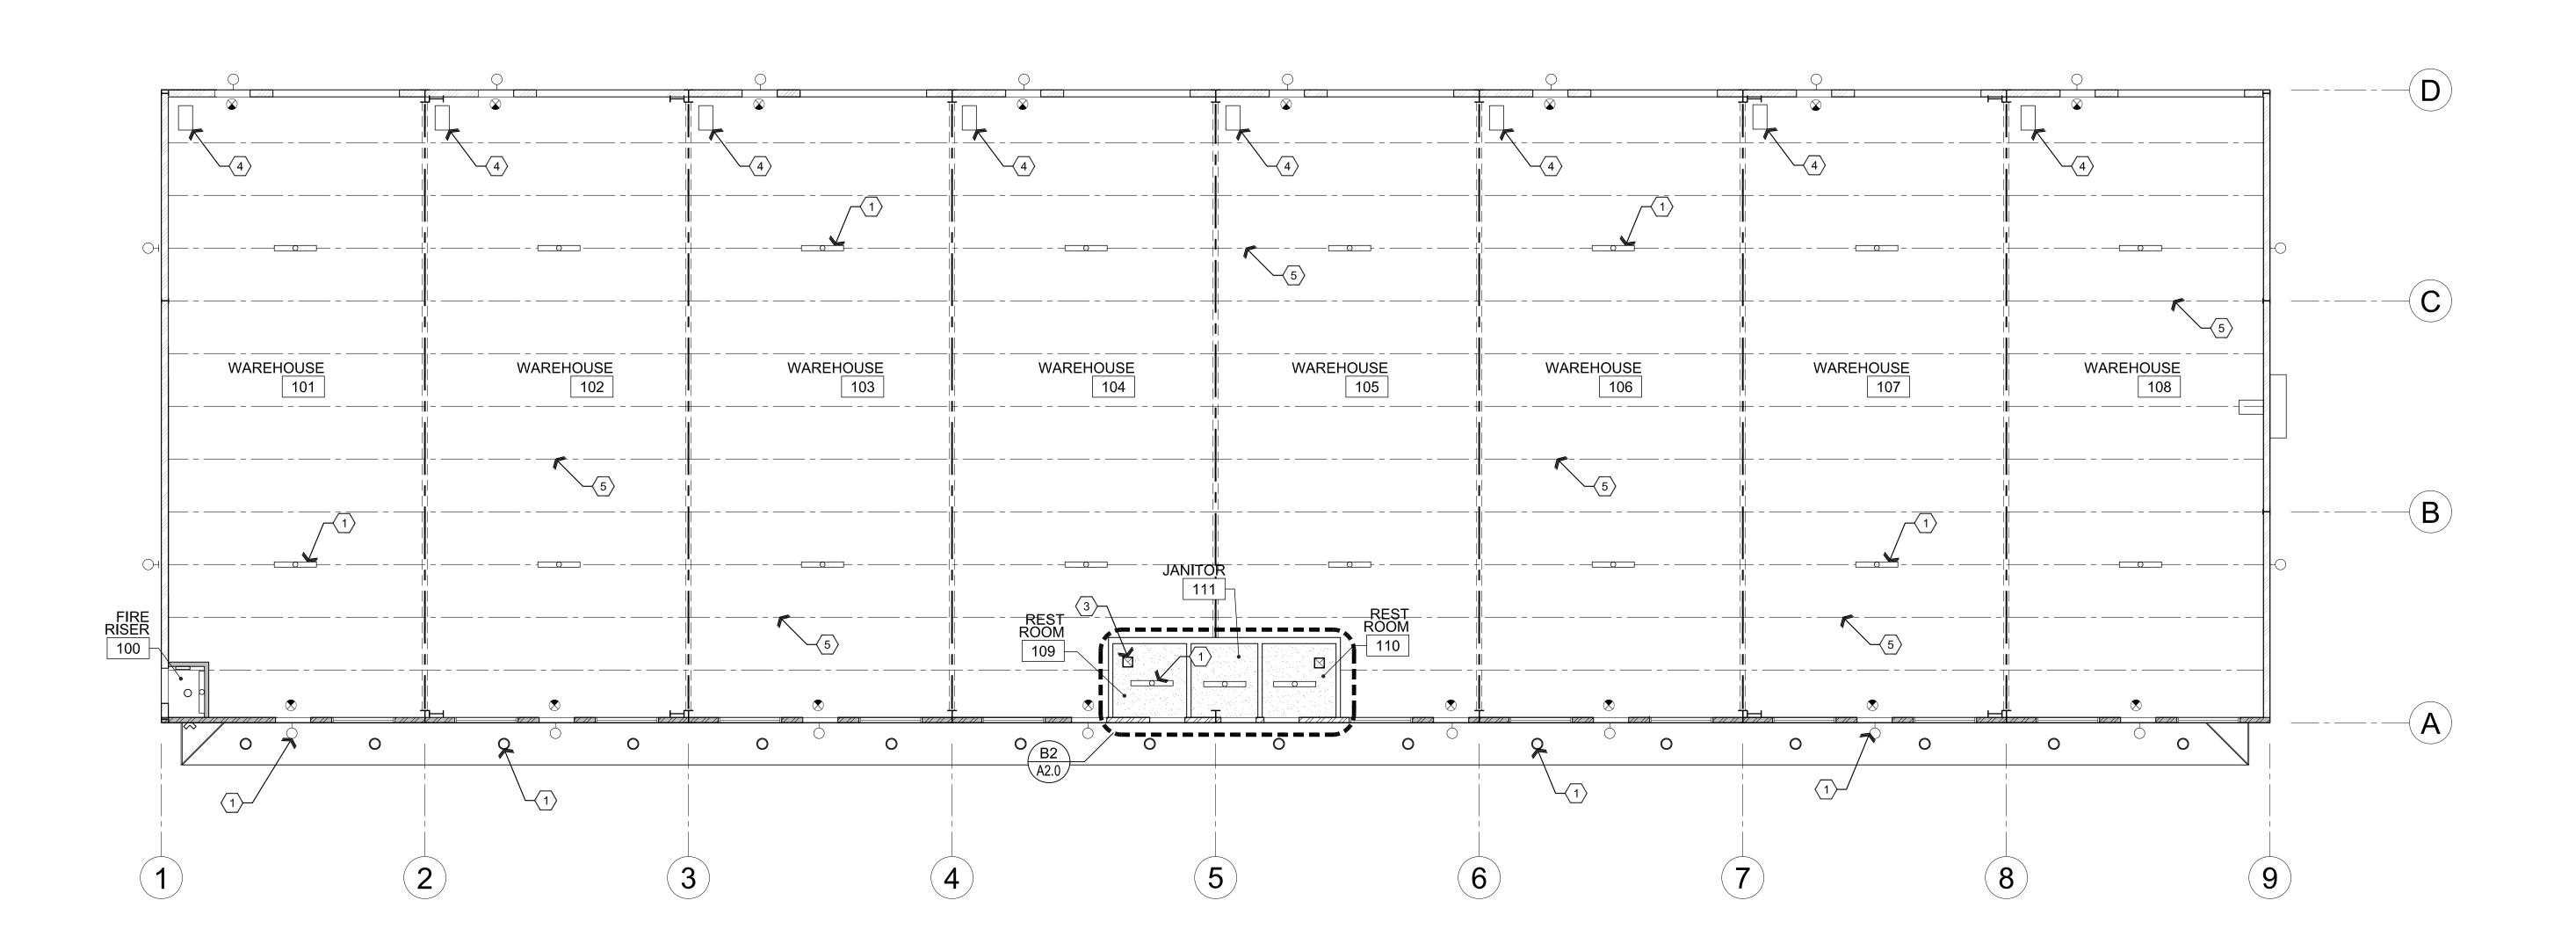

Plan

W. Alan Kenson & Assoc

REVISIONS

These drawings are the property of W. Alan Kenson & Associates P.C.,

ontracting Building B nter Cal Way ott, AZ 86301

PROJECT: JSC Cont

DRAWN BY
L.O.
CHECKED BY
W.A.K.

DATE

July 31st, 2024

JOB NO.
799

A2.0

Roof Drain Leader Sizes:

ROOF AREA: 11,788

4" RAINFALL = .0416 GPM

.0416 x 11,788 = 490 GPM

490 / 192 (3-1/2"x4")= 2.55

3-1/2" x 4" DOWNSPOUTS = 3 LEADERS REQUIRED 5 LEADERS PROVIDED

3" x 5" GUTTER REQUIRED WITH 1/2" SLOPE (225 GPM) *PER 2018 IPC SECTION 1106 (TABLE 1106.3 & 1106.6)

Descriptive Keynotes 🔾

- PROVIDE 24 GAUGE GALVALUME STANDING SEAM SHEET METAL ROOF PANELS, REFER TO MATERIALS SCHEDULE. M-2
- PROVIDE SHEET METAL GUTTER, REFER TO MATERIALS SCHEDULE. M-5
- PROVIDE DOWNSPOUT, TYPICAL OF 5, REFER TO MATERIALS
- SCHEDULE. M-4
- PROVIDE LOKSEAM' METAL AWNING SYSTEM, REFER TO STRUCTURAL PLANS AND MATERIALS SCHEDULE. M-3

 (D) <u>C</u> B SLOPE 12:12 5

Roof Plan


REVISIONS

These drawings are the property of W. Alan Kenson & Associates P.C.,

and may not be reproduced in any way without the written consent of

DRAWN BY
L.O.
CHECKED BY
W.A.K.

July 31st, 2024

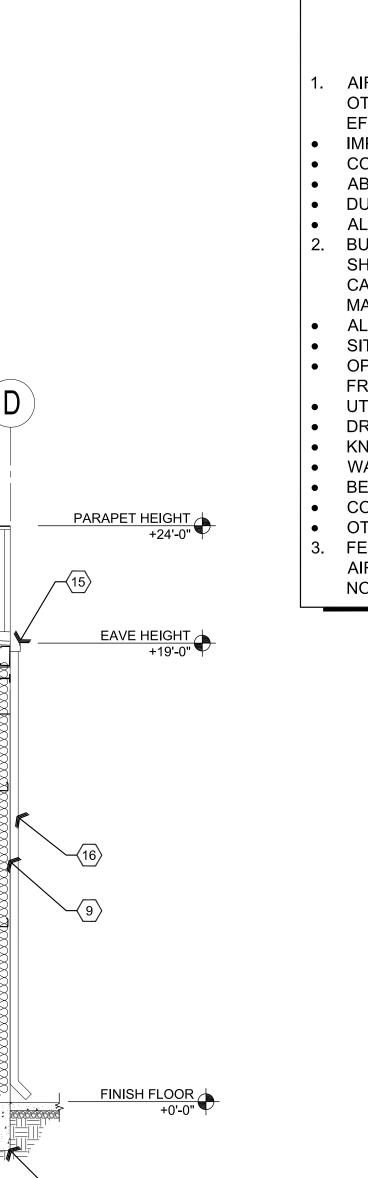

Scale: 1/4"=1'-0"

Descriptive Keynotes \bigcirc

- PROVIDE CONCRETE FOOTING. REFER TO STRUCTURAL PLANS.
- PROVIDE CONCRETE SLAB, REFER TO STRUCTURAL PLANS.
- PROVIDE STEEL COLUMN, REFER TO STRUCTURAL PLANS.
- 4. PROVIDE STEEL BEAM, REFER TO STRUCTURAL PLANS.
- PROVIDE ROOF PURLIN, TYPICAL. REFER TO STRUCTURAL PLANS.
- PROVIDE STRUCTURAL FRAMING FOR AWNING SYSTEM. REFER TO STRUCTURAL PLANS.
- Z___PROVIDE_R=19_UNFACED_BATT_INSULATION_____
- 8. PROVIDE R-30 (9") PROLINER™ SYSTEM (WHITE)
- 9. ÉXTÉRÍOR WALL, RÉFÉR TO WALL TYPES PLAN FOR TYPE OF CONSTRUCTION. 10. PROVIDE 24 GAUGE GALVALUME STANDING SEAM SHEET METAL ROOF PANELS.
- 11. PROVIDE ARTISAN SERIES PANELS AT METAL SOFFIT SYSTEM, REFER TO MATERIALS SCHEDULE. M-9
- 12. PROVIDE METAL ROOF PANEL AT METAL AWNING SYSTEM, REFER TO MATERIALS
- SCHEDULE. M-3 13. PROVIDE SHEET METAL WALL TO ROOF FLASHING.
- 14. PROVIDE SHEET METAL PARAPET CAP, REFER TO MATERIALS SCHEDULE. M-6
- 15. PROVIDE SHEET METAL GUTTER, REFER TO MATERIALS SCHEDULE. M-5
- 16. PROVIDE SHEET METAL DOWNSPOUT, REFER TO MATERIALS SCHEDULE.
- 17. PROVIDE 26 GAUGE "PBA" METAL BUILDING SIDE PANEL, REFER TO MATERIALS SCHEDULE. M-1
- 18. PROVIDE STEEL GIRT, TYPICAL. REFER TO STRUCTURAL PLANS.
- 19. CUT FLANGES AND PLACE BEHIND VERTICAL. 20. CONTINUOUS LIGHT GAUGE STEEL TRACK, REFER TO STRUCTURAL PLANS.
- 21. STEEL STUD WALL. REFER TO WALL TYPES PLAN.
- 22. PROVIDE PBR SHEET METAL LINER PANEL ON INSIDE OF PARAPET.
- 23. PROVIDE 8'-0" TALL PBR SHEET METAL LINER PANEL, REFER TO MATERIALS SCHEDULE. M-8 ŽÝ. Ř-38 (12") LONG TAB BANDEĎ ŠYS FACED W/ VŘŘ+, Ž@12" ĎOUBLE ŠEAL TAB(Š)
- 25. NOT ÙSED.


- 26. PROVIDE 2' OF 2" SLAB INSULATION.

Ar Barrier

NOTE:

PROVIDE AN AIR BARRIER PER THE 2012 IECC SECTION C402.4.1

- 1. AIR LEAKAGE THE CODE ALLOWS THE USE OF AIRFLOW RETARDERS (HOUSE WRAPS) OR OTHER SOLID MATERIALS AS ACCEPTABLE METHODS TO MEET THIS REQUIREMENT. TO BE EFFECTIVE, THE BUILDING THERMAL SEAL MUST BE:
- IMPERMEABLE TO AIR FLOW.
- CONTINUOUS OVER THE ENTIRE BUILDING ENVELOPE.
- ABLE TO WITHSTAND THE FORCES THAT MAY ACT ON IT DURING AND AFTER CONSTRUCTION.
- DURABLE OVER THE EXPECTED LIFETIME OF THE BUILDING.
- ALL SEAMS AND EDGES MUST BE SEALED/TAPED PER MANUFACTURER'S SPECIFICATIONS. 2. BUILDING THERMAL ENVELOPE - THE SEALING METHODS BETWEEN DISSIMILAR MATERIALS SHALL ALLOW FOR DIFFERENTIAL EXPANSION AND CONTRACTION. THE FOLLOWING SHALL BE CAULKED, GASKETED, WEATHER-STRIPPED OR OTHERWISE SEALED WITH AN AIR BARRIER MATERIAL, SUITABLE FILM OR SOLID MATERIAL:
- ALL JOINTS, SEAMS AND PENETRATIONS.
- SITE BUILT WINDOWS, DOORS AND SKYLIGHTS.
- OPENINGS BETWEEN WINDOW AND DOOR ASSEMBLIES AND THEIR RESPECTIVE JAMBS AND FRAMING.
- UTILITY PENETRATIONS.
- DROPPED CEILINGS OR CHASES ADJACENT TO THE THERMAL ENVELOPE. • KNEE WALLS.
- WALLS AND CEILINGS SEPARATING A GARAGE FROM CONDITIONED SPACES.
- BEHIND TUBS AND SHOWERS ON EXTERIOR WALLS.
- COMMON WALLS BETWEEN DWELLING UNITS.
- OTHER SOURCES OF INFILTRATION.
- FENESTRATION AIR LEAKAGE WINDOW, SKYLIGHT AND SLIDING GLASS DOORS SHALL HAVE AN AIR INFILTRATION RATE OF NO MORE THAN 0.3 CFM PER SQUARE FOOT, AND SWINGING DOORS NO MORE THAN 0.5 CFM. SPECIFICATION SHALL BE LISTED ON THE MANUFACTURER LABEL.

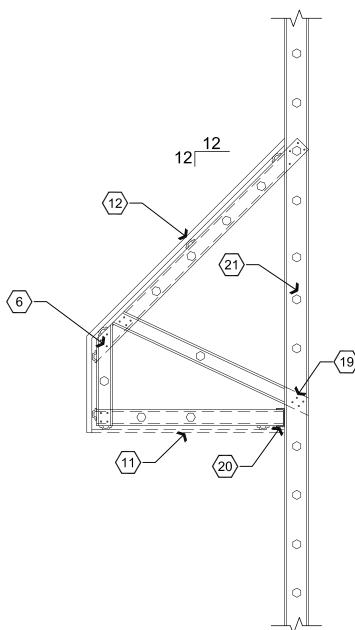

Bank Awning at Stud Wall

Scale: 1/2"=1'-0"

REVISIONS City of Prescott Comments 10/08/2024 These drawings are the property of W. Alan Kenson & Associates P.C

and may not be reproduced in any way without the written consent of W. Alan Kenson & Associates, P.C


te

DRAWN BY

L.O. CHECKED BY W.A.K. July 31st, 2024 JOB NO. **799**

SHEET

Building Section

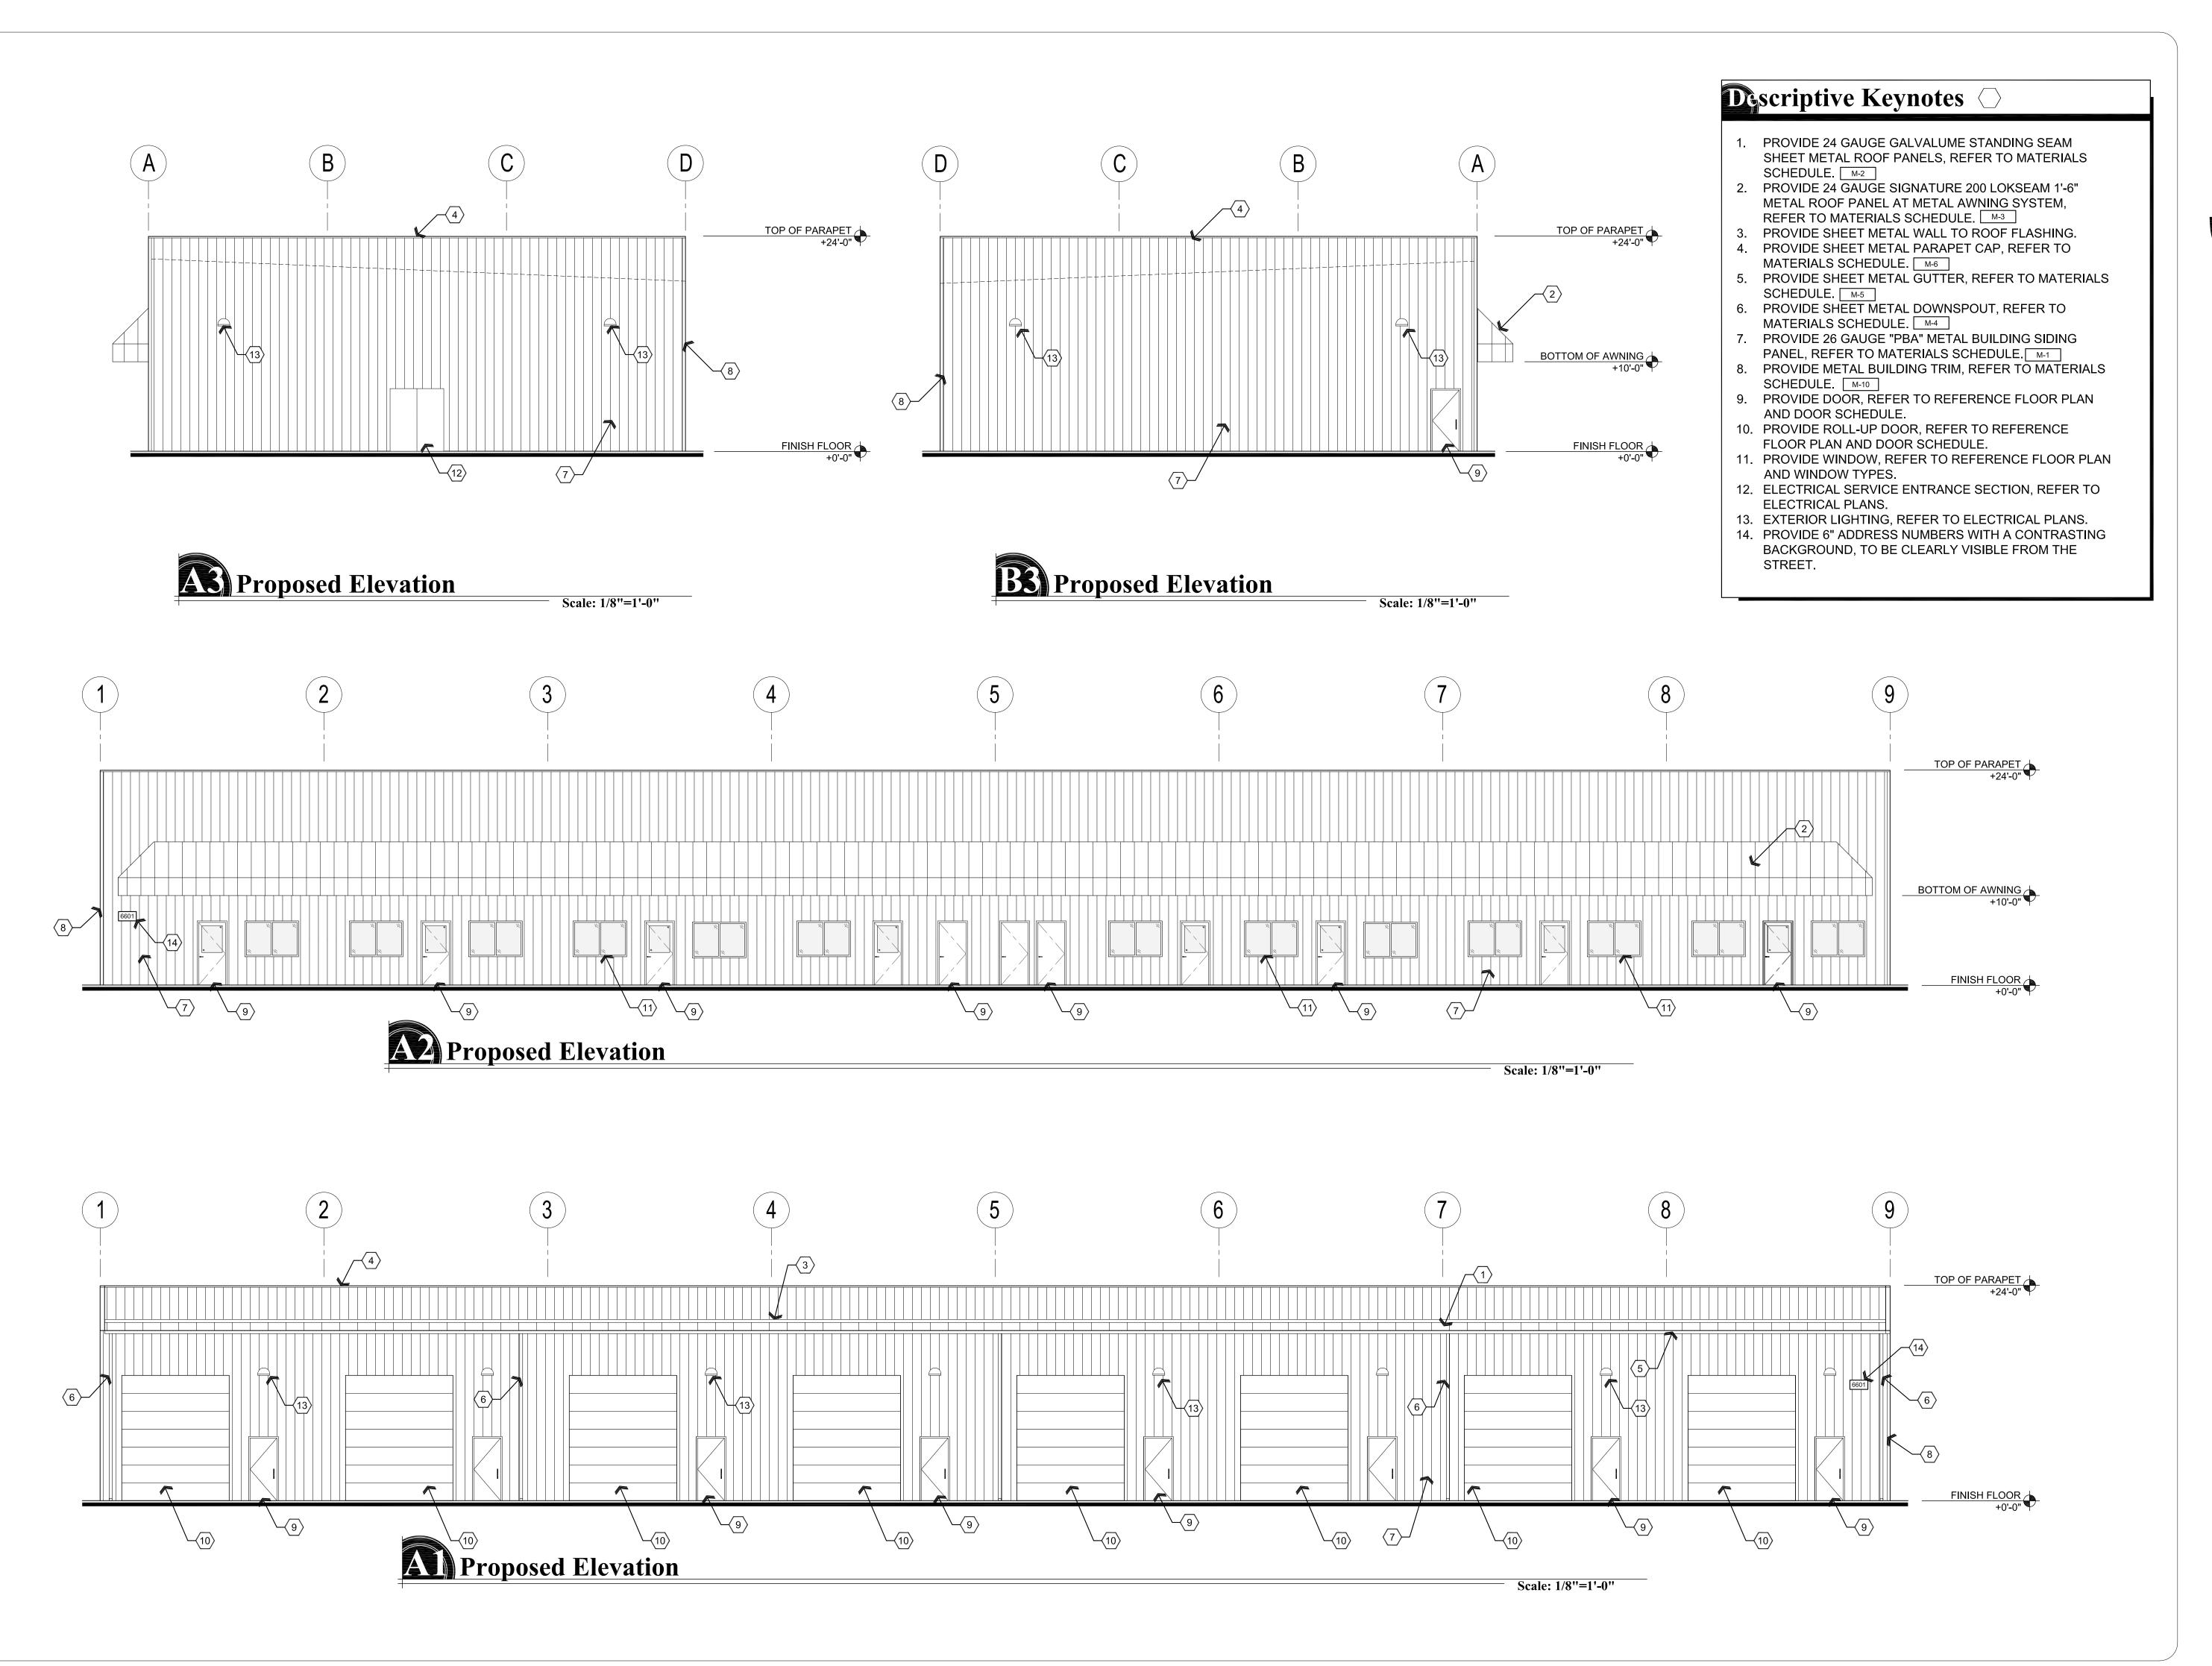


REVISIONS

These drawings are the property of

way without the written consent of

DRAWN BY CHECKED BY W.A.K.

July 31st, 2024

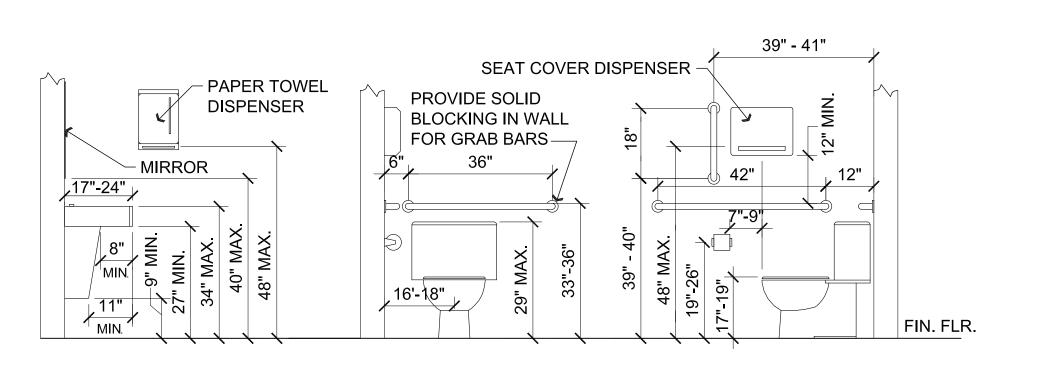

Typical Fixture Mounting Heights

Scale: 1/2"=1'-0"

Descriptive Keynotes (


- 1. PROVIDE 1-1/2" DIAMETER GRAB BARS PER A.D.A. REQUIREMENTS, 42" LONG AT SIDE OF WATER CLOSET / 36" LONG AT REAR OF WATER CLOSET / 18" VERTICAL GRAB BAR, PROVIDE SOLID BLOCKING. REFER TO TOILET ACCESSORY SCHEDULE. TA-3
- 2. PROVIDE PAPER TOWEL DISPENSER, REFER TO TOILET ACCESSORY SCHEDULE. TA-2
- 3. PROVIDE FLOOR MOUNTED WATER CLOSET, REFER TO PLUMBING DRAWINGS.
- PROVIDE WALL HUNG LAVATORY, INSULATE PIPES, REFER TO PLUMBING DRAWINGS.
- 5. PROVIDE ACCESSIBILITY SIGNAGE MOUNTED PER A.D.A. REQUIREMENTS.
- 6. PROVIDE 1/4" PLATE MIRROR.
- 7. PROVIDE SURFACE MOUNTED HAND SOAP DISPENSER, REFER TO TOILET ACCESSORY
- SCHEDULE. TA-1


 8. PROVIDE SURFACE MOUNTED TOILET SEAT COVER DISPENSER, REFER TO TOILET ACCESSORY
- SCHEDULE. TA-4


 9. PROVIDE TOILET PAPER DISPENSER, REFER TO
- TOILET ACCESSORY SCHEDULE. TA-5

 10. MOP SINK, REFER TO PLUMBING PLANS.
- 11. FRP WAINSCOT, 4' HIGH. FRP-1

 12. PROVIDE A.D.A ACCESSIBLE ELECTRIC DRINK
- 12. PROVIDE A.D.A ACCESSIBLE ELECTRIC DRINKING FOUNTAIN, MAXIMUM HEIGHT OF SPOUT OUTLET TO BE 36" FROM FLOOR. REFER TO PLUMBING PLAN.

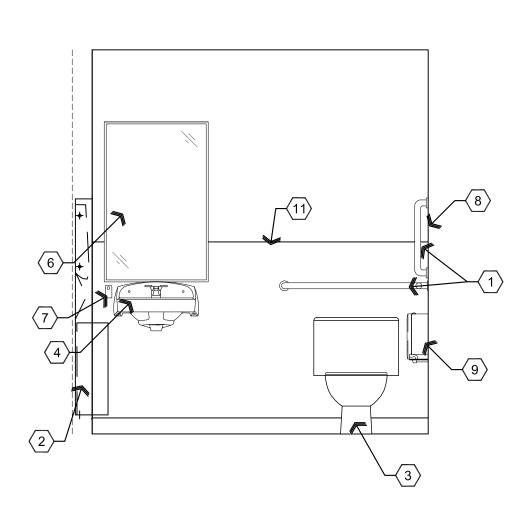

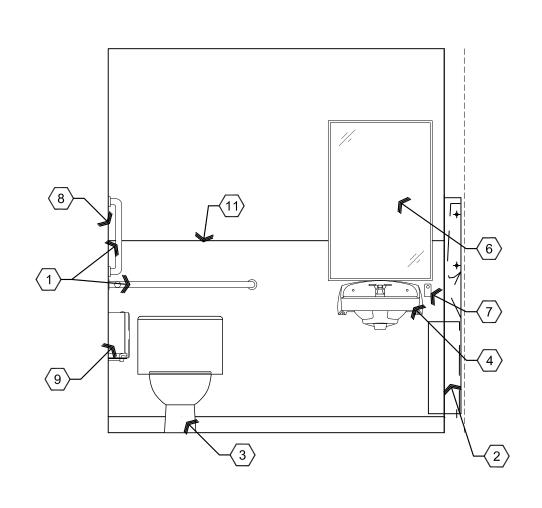

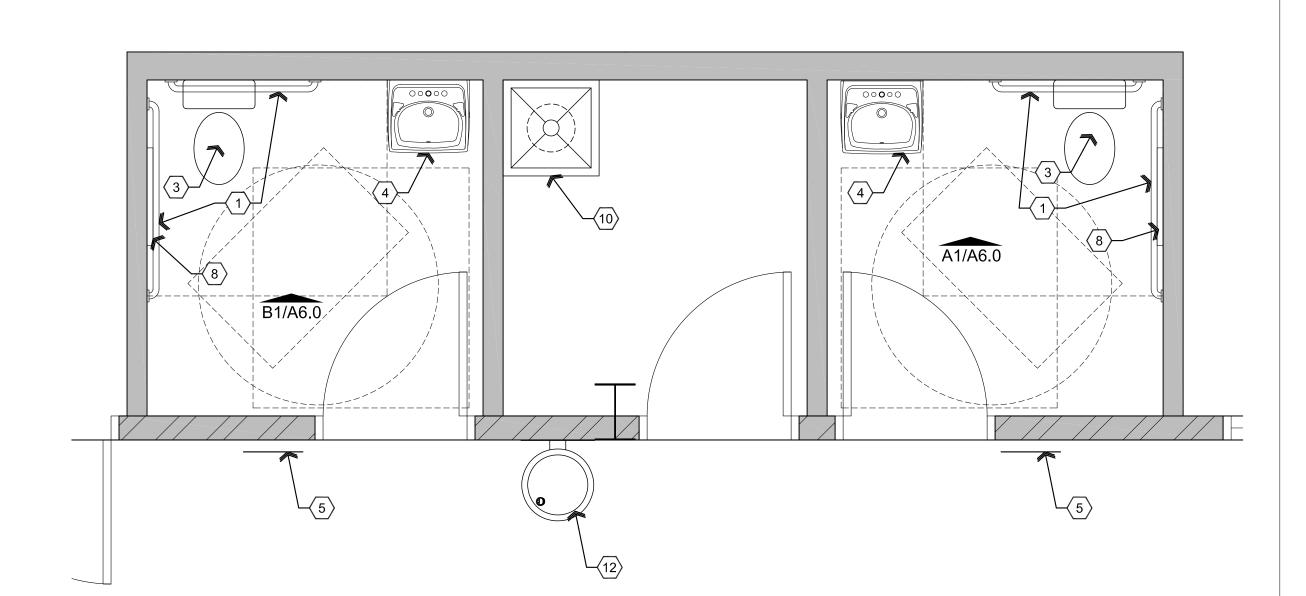







Scale: 1/2"



Alan Kenson & Associates, F P 928-443-5812 P.O. Box 11593

REVISIONS

These drawings are the property of

W. Alan Kenson & Associates P.C., and may not be reproduced in any

way without the written consent of

W. Alan Kenson & Associates, P.C.

PART OF THE PART O

: Contracting Building B 1 Inter Cal Way scott, AZ 86301

JECT: JSC Contracting 6601 Inter Cal W Prescott, AZ 863

DRAWN BY
L.O.


L.O.


CHECKED BY
W.A.K.


DATE
July 31st, 2024

JOB NO.
799

160

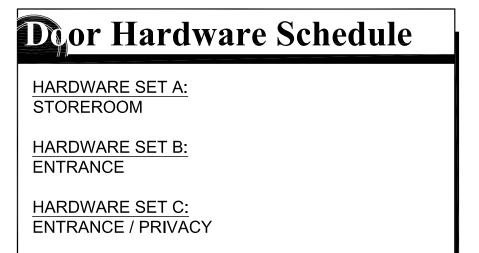

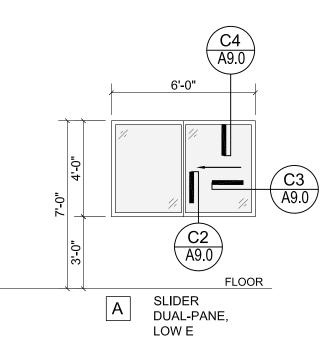

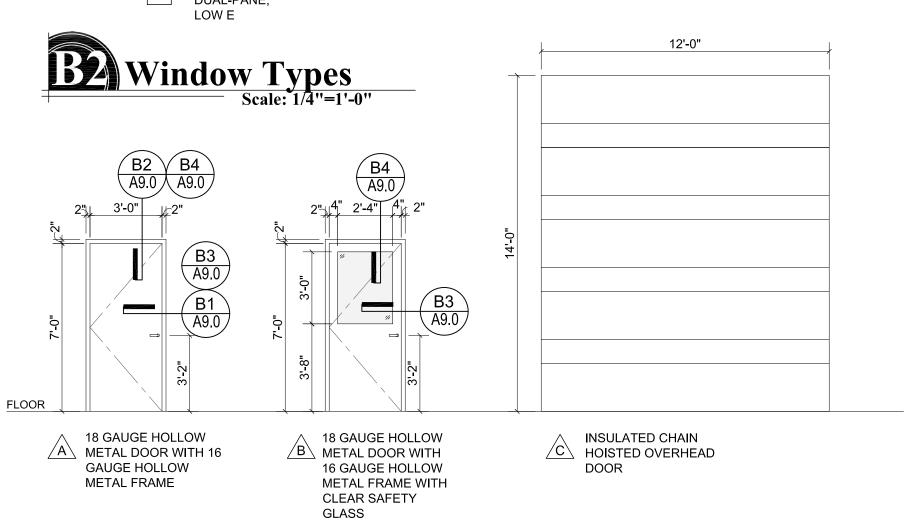



Scale: 1/4"=1'-0"

Dor Schedule

NO.	ROOM NAME	SIZE	TYPE	DOOR MATERIAL	DOOR FINISH	FRAME MATERIAL	FRAME FINISH	HARDWA TYPE
100A	FIRE RISER	3'-0"x7'-0"	Α	НМ	PAINT	НМ	PAINT	А
101A	WAREHOUSE	3'-0"x7'-0"	В	HM / GLASS	PAINT	НМ	PAINT	В
101B	WAREHOUSE	3'-0"x7'-0"	А	НМ	PAINT	НМ	PAINT	В
101C	WAREHOUSE	12'-0"x14'-0"	С	STEEL	PAINT	STEEL	PAINT	-
102A	WAREHOUSE	3'-0"x7'-0"	В	HM / GLASS	PAINT	НМ	PAINT	В
102B	WAREHOUSE	3'-0"x7'-0"	А	НМ	PAINT	НМ	PAINT	В
102C	WAREHOUSE	12'-0"x14'-0"	С	STEEL	PAINT	STEEL	PAINT	-
103A	WAREHOUSE	3'-0"x7'-0"	В	HM / GLASS	PAINT	НМ	PAINT	В
103B	WAREHOUSE	3'-0"x7'-0"	А	НМ	PAINT	НМ	PAINT	В
103C	WAREHOUSE	12'-0"x14'-0"	С	STEEL	PAINT	STEEL	PAINT	-
104A	WAREHOUSE	3'-0"x7'-0"	В	HM / GLASS	PAINT	НМ	PAINT	В
104B	WAREHOUSE	3'-0"x7'-0"	А	НМ	PAINT	НМ	PAINT	В
104C	WAREHOUSE	12'-0"x14'-0"	С	STEEL	PAINT	STEEL	PAINT	-
105A	WAREHOUSE	3'-0"x7'-0"	В	HM / GLASS	PAINT	НМ	PAINT	В
105B	WAREHOUSE	3'-0"x7'-0"	А	НМ	PAINT	НМ	PAINT	В
105C	WAREHOUSE	12'-0"x14'-0"	С	STEEL	PAINT	STEEL	PAINT	-
106A	WAREHOUSE	3'-0"x7'-0"	В	HM / GLASS	PAINT	НМ	PAINT	В
106B	WAREHOUSE	3'-0"x7'-0"	А	НМ	PAINT	НМ	PAINT	В
106C	WAREHOUSE	12'-0"x14'-0"	С	STEEL	PAINT	STEEL	PAINT	-
107A	WAREHOUSE	3'-0"x7'-0"	В	HM / GLASS	PAINT	НМ	PAINT	В
107B	WAREHOUSE	3'-0"x7'-0"	А	НМ	PAINT	НМ	PAINT	В
107C	WAREHOUSE	12'-0"x14'-0"	С	STEEL	PAINT	STEEL	PAINT	-
108A	WAREHOUSE	3'-0"x7'-0"	В	HM / GLASS	PAINT	НМ	PAINT	В
108B	WAREHOUSE	3'-0"x7'-0"	Α	НМ	PAINT	НМ	PAINT	В
108C	WAREHOUSE	12'-0"x14'-0"	С	STEEL	PAINT	STEEL	PAINT	-
109A	RESTROOM	3'-0"x7'-0"	D	HM / GLASS	PAINT	НМ	PAINT	С
110A	RESTROOM	3'-0"x7'-0"	А	НМ	PAINT	НМ	PAINT	С
111A	JANITOR	12'-0"x14'-0"	F	STEEL	PAINT	STEEL	PAINT	Α

NOTES:

- 1. ALL EXIT DOORS & HARDWARE SHALL COMPLY WITH THE 2018 I.B.C. AND I.F.C.
- 2. DOOR THRESHOLDS SHALL HAVE A MAX HEIGHT OF 1/2" FOR H.C. ACCESSIBILITY. THRESHOLD SHALL HAVE A MAXIMUM RISE OF 1/4" AND 1/2" RISE WHEN BEVELED WITH MAXIMUM 1:2 SLOPE.
- 3. ALL GLAZING IN DOORS SHALL BE SAFETY GLAZING.
- 4. ALL INTERIOR DOORS SHALL BE OPERABLE FOR EMERGENCY EXITING PURPOSES WITHOUT THE USE OF A KEY, SPECIAL KNOWLEDGE NOR EFFORT.
- 5. ALL GLAZING WITHIN 24" OF OPENINGS SHALL BE SAFETY GLASS.
- IF A DOOR HAS A CLOSER, THEN THE SWEEP PERIOD OF THE CLOSER SHALL BE ADJUSTED SO THAT FROM AN OPEN POSITION OF 70 DEGREES, THE DOOR WILL TAKE AT LEAST 3 SECONDS TO MOVE TO A POINT 3" FROM THE LATCH, MEASURED TO THE LEADING EDGE OF THE DOOR.
- 7. DOOR HANDLES, PULLS, LATCHES, LOCKS, AND OTHER OPERATING DEVICES ON ACCESSIBLE DOORS SHALL HAVE A SHAPE THAT IS EASY TO GRASP WITH ONE HAND AND DOES NOT REQUIRE TIGHT GRASPING, TIGHT PINCHING, OR TWISTING OF THE WRIST TO OPERATE. HARDWARE REQUIRED FOR DOOR PASSAGE SHALL BE MOUNTED NO HIGHER THAN 48" ABOVE FINISH FLOOR.
- 8. DOOR OPENING FORCE SHALL BE: 5lbf MAX INTERIOR HINGED, SLIDING OR FOLDING DOORS; FIRE DOORS SHALL HAVE THE MINIMUM OPENING FORCE ALLOWABLE BY THE APPROPRIATE ADMINISTRATIVE AUTHORITY.

REVISIONS

These drawings are the property of W. Alan Kenson & Associates P.C.

DRAWN BY L.O. CHECKED BY W.A.K. July 31st, 2024


JOB NO. **799**

Mate	rials schedule XX-#			
CODE	MATERIAL	LOCATION	MANUFACTURER	SPECIFICATION
FRP-1	FIBERGLASS REINFORCED PLASTIC	JANITOR & EXTERIOR ENTRANCE RESTROOMS		GRAY, 4' TALL WAINSCOT
M-1	METAL SIDING PANEL	EXTERIOR	MBCI	PBA PANEL 26 GAUGE, PRE PAINTED, KOKO BROWN (SIGNATURE 200)
M-2	METAL ROOF PANEL	MAIN ROOF	MBCI	24" ULTRADEK, 24 GAUGE, STANDING SEAM, GALVALUME
M-3	METAL ROOF PANEL	AWNING ROOF	MBCI	26 GAUGE LOKSEAM 12" STANDING SEAM, SLATE GRAY (SIGNATURE 300)
M-4	SHEET METAL DOWNSPOUT	EAST EXTERIOR	MBCI	3-1/2" x4" BOX DOWNSPOUT, 26 GAUGE, PRE-PAINTED, KOKO BROWN (SIGNATURE 200)
M-5	SHEET METAL GUTTER	EAST EXTERIOR	MBCI	3"x5" BOX GUTTER, 26 GAUGE, PRE-PAINTED KOKO BROWN (SIGNATURE 200)
M-6	METAL PARAPET CAP	NORTH, SOUTH AND WEST EXTERIOR	MBCI	26 GAUGE, PRE-PAINTED, KOKO BROWN (SIGNATURE 200)
M-7	EXTERIOR METAL PANEL LINER	INTERIOR OF PARAPETS	MBCI	PBR PANEL 26 GAUGE PRE-PAINTED, KOKO BROWN (SIGNATURE 200)
M-8	INTERIOR METAL LINER PANEL	INTERIOR AS SHOWN ON PLAN UP TO 8'-0" A.F.F.	MBCI	PBR PANEL 26 GAUGE, PRE-PAINTED, POLAR WHITE (SIGNATURE 200)
M-9	METAL SOFFIT SYSTEM	AWNING SOFFIT	MBCI	ARTISAN SERIES 12" WIDE 26 GAUGE SLATE GRAY(SIGNATURE 300)
M-10	METAL TRIM	EXTERIOR	MBCI	26 GAUGE PRE-PAINTED KOKO BROWN (SIGNATURE 200)
OD-1	OVERHEAD DOOR	WAREHOUSE BAYS	C.H.I.	INSULATED RIBBED STEEL OVERHEAD DOOR WITH CHAIN HOIST MODEL # 3241
PT-1	PAINT	GPDW WALLS AND CEILINGS	SHERWIN WILLIAMS	PASSIVE SW7064

Room Finish Plan

Ric	m Finish S	chedul	e				
NO.	ROOM NAME	FLOOR	BASE	WALLS	CEILING	HEIGHT	FLOOR:
100	FIRE RISER	F1	B1	W1	C1	VARIES	F1 CONCRETE
101	WAREHOUSE	F1	B1	W1	C1	VARIES	
102	WAREHOUSE	F1	B1	W1	C1	VARIES	BASE:
103	WAREHOUSE	F1	B1	W1	C1	VARIES	B1 NONE
104	WAREHOUSE	F1	B1	W1	C1	VARIES	
105	WAREHOUSE	F1	B1	W1	C1	VARIES	WALLS:
106	WAREHOUSE	F1	B1	W1	C1	VARIES	W1 OPEN TO STRUCTURE /
107	WAREHOUSE	F1	B1	W1	C1	VARIES	METAL LINER PANELS W2 PAINTED GPDW PT-1
108	WAREHOUSE	F1	B1	W1	C1	VARIES	W3 FRP WAINSCOT FRP-1
109	RESTROOM	F1	B1	W2/W3	C2	8'-0"	CEILING:
110	RESTROOM	F1	B1	W2/W3	C2	8'-0"	C1 OPEN TO STRUCTURE
111	JANITOR	F1	B1	W2/W3	C2	8'-0"	C2 PAINTED GPDW PT-1

gend		
4 4 4 4	CONCRETE	

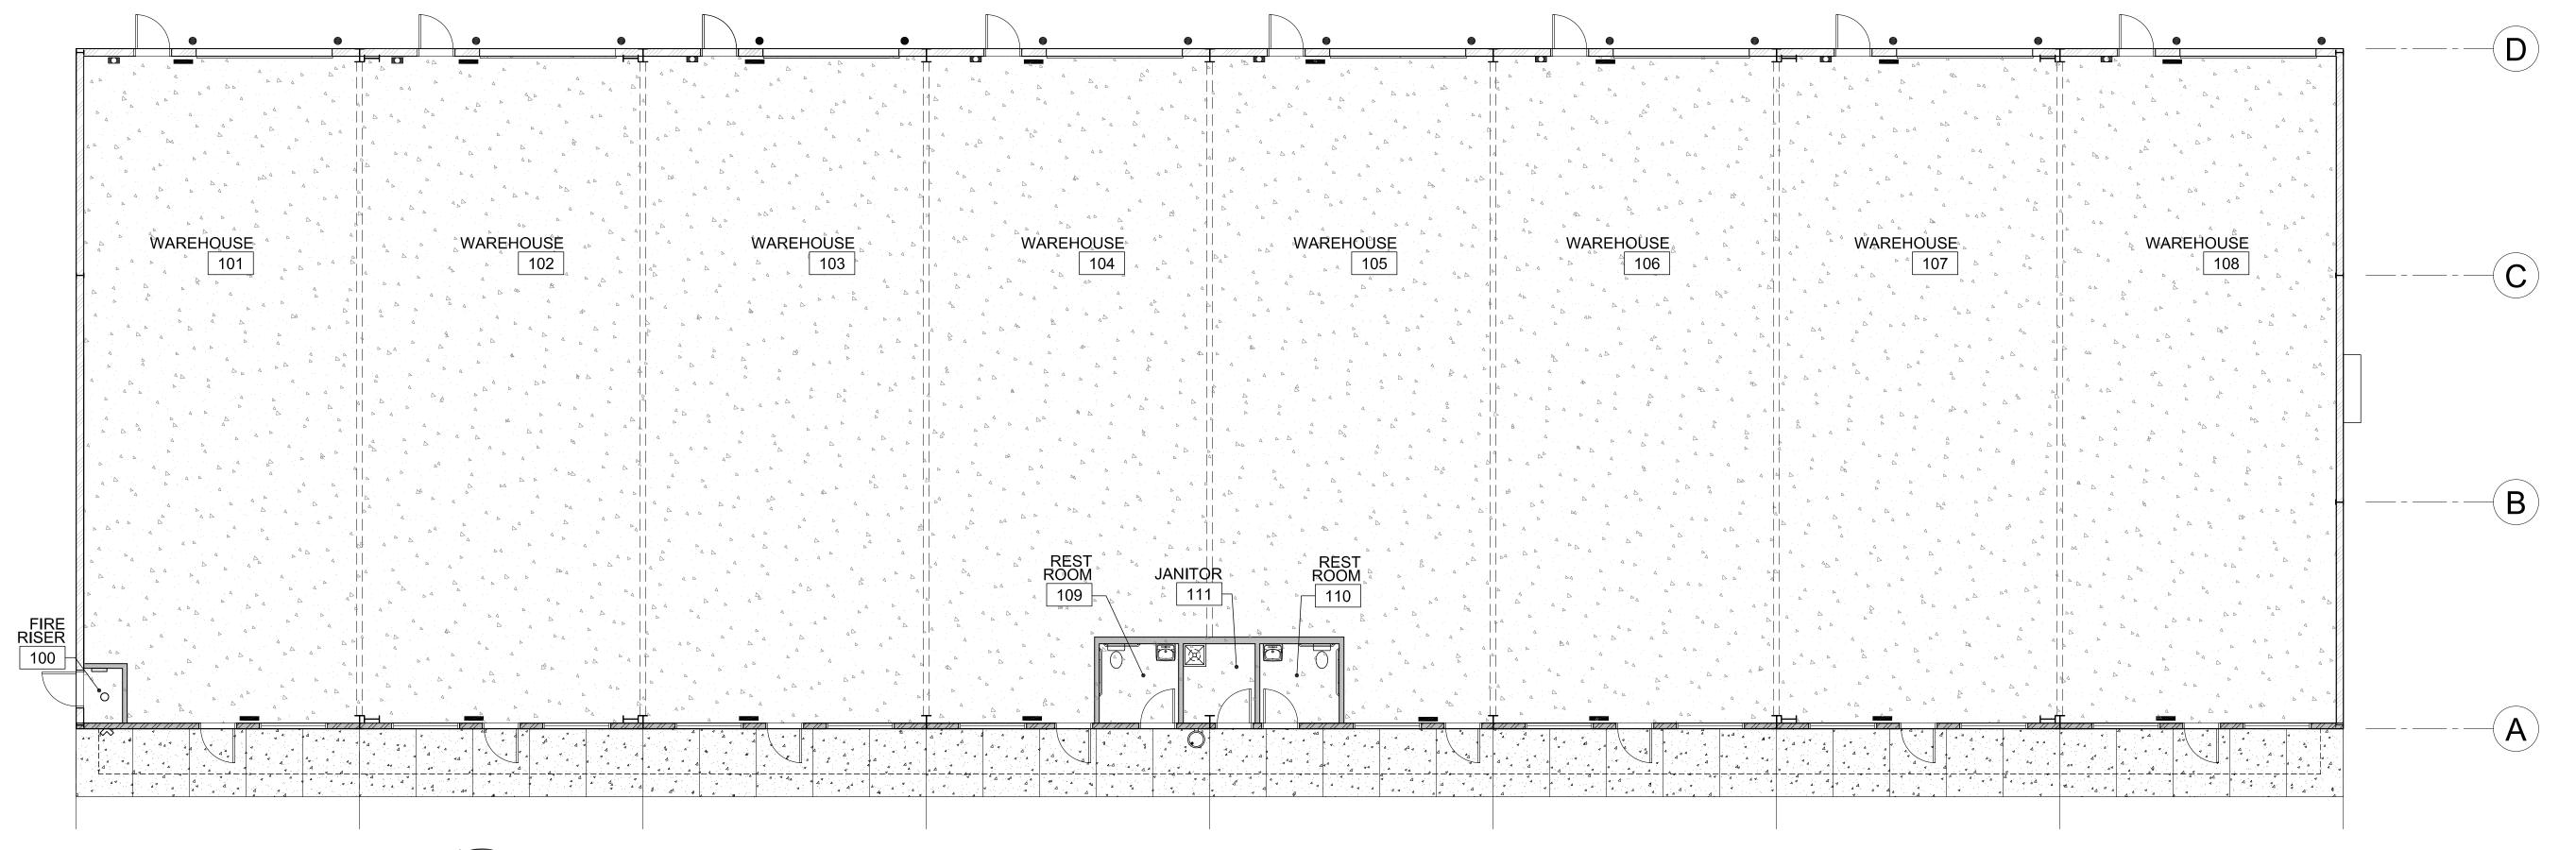


REVISIONS

These drawings are the property of W. Alan Kenson & Associates P.C., and may not be reproduced in any way without the written consent of


DRAWN BY
L.O.
CHECKED BY
W.A.K.

July 31st, 2024 JOB NO. **799** SHEET

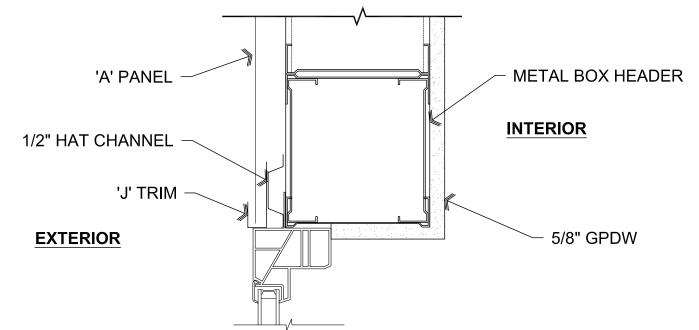


B Door Head

SCALE: 3" = 1'-0"

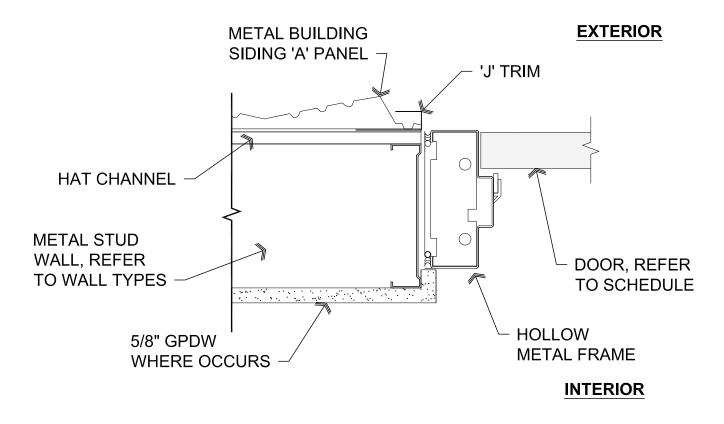




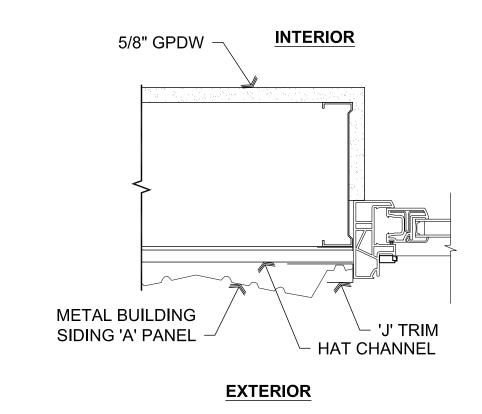


B Door Jamb

SCALE: 3" = 1'-0"

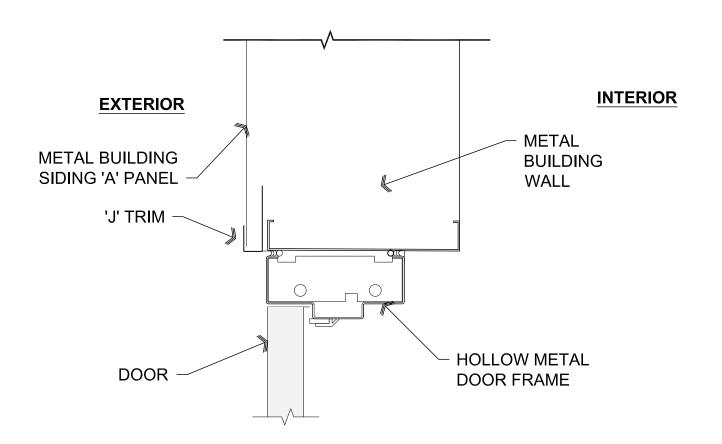



SCALE: 3" = 1'-0"

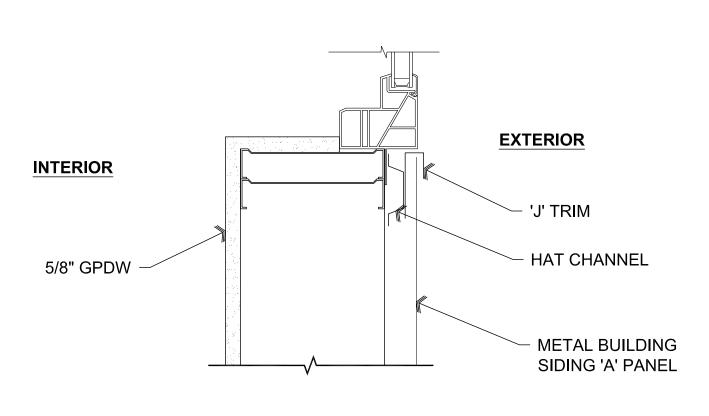




Window Sill

INTERIOR

SCALE: 3" = 1'-0"

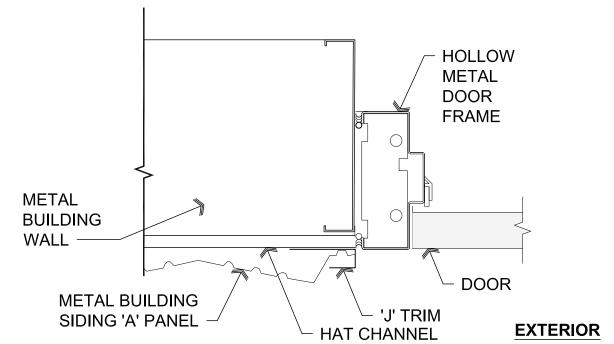



SCALE: 3" = 1'-0"

JOB NO. **799** SHEET

ssociates

REVISIONS

These drawings are the property of

W. Alan Kenson & Associates P.C and may not be reproduced in any way without the written consent of

DRAWING:

103-50-054D LANS_B2407-176

DRAWN BY **L.O.** CHECKED BY W.A.K.

July 31st, 2024

GENERAL REQUIREMENTS:

- 1. THESE DRAWINGS, AND THEIR ASSOCIATED STRUCTURAL CALCULATIONS, HAVE BEEN PERFORMED USING STANDARDS OF PROFESSIONAL CARE AND COMPLETENESS NORMALLY EXERCISED UNDER SIMILAR CIRCUMSTANCES BY REPUTABLE STRUCTURAL ENGINEER'S IN THIS OR SIMILAR LOCALITIES. THEY NECESSARILY ASSUME THAT THE WORK DEPICTED WILL BE PERFORMED BY AN EXPERIENCED CONTRACTOR AND/OR WORKMEN WHO HAVE A WORKING KNOWLEDGE OF THE INTERNATIONAL BUILDING CODE CONVENTIONAL FRAMING REQUIREMENTS AND OF INDUSTRY ACCEPTED STANDARD GOOD PRACTICE. AS NOT EVERY CONDITION OR FRAMING ELEMENT IS (OR CAN BE) EXPLICITLY SHOWN ON THESE DRAWINGS, IT IS UNDERSTOOD THAT THE CONTRACTOR WILL USE INDUSTRY ACCEPTED STANDARD GOOD PRACTICE FOR ALL MISCELLANEOUS WORK NOT EXPLICITLY SHOWN.
- 2. THESE DRAWINGS REPRESENT THE FINISHED STRUCTURE. THEY DO NOT INDICATE THE METHOD OF CONSTRUCTION. THE CONTRACTOR SHALL BE SOLELY RESPONSIBLE FOR CONSTRUCTION MEANS, METHODS, TECHNIQUES, SEQUENCES AND PROCEDURES. CONSTRUCTION MATERIALS SHALL BE SPREAD OUT IF PLACED ON FRAMED CONSTRUCTION SUCH THAT DESIGN LIVE LOAD PER SQUARE FOOT AS STATED HEREIN IS NOT EXCEEDED. OPTIONS ARE FOR CONTRACTOR'S CONVENIENCE. IF AN OPTION IS USED, THE CONTRACTOR SHALL BE RESPONSIBLE FOR ALL NECESSARY CHANGES, AND SHALL
- 3. WHERE DISCREPANCIES OCCUR BETWEEN PLANS, DETAILS, GENERAL STRUCTURAL NOTES AND SPECIFICATIONS, THE GREATER REQUIREMENTS SHALL GOVERN. TYPICAL DETAILS AND NOTES ARE NOT NECESSARILY INDICATED ON THE PLANS, BUT SHALL APPLY SIMILAR WORK ON THE PROJECT. DETAILS MAY SHOW ONLY ONE SIDE OF CONNECTION OR MAY OMIT INFORMATION FOR CLARITY.
- PLUMBING AND ELECTRICAL WITH APPROPRIATE TRADES, DRAWINGS AND SUBCONTRACTORS PRIOR TO CONSTRUCTION. CONTRACTOR SHALL BE RESPONSIBLE FOR VERIFICATION OF ALL DIMENSIONS WITH ARCHITECTURAL DRAWINGS PRIOR TO START OF CONSTRUCTION. RESOLVE ANY DISCREPANCY WITH THE ARCHITECT AND STRUCTURAL FNGINFFR.
- 5. ANY INSPECTIONS, SPECIAL (IBC CHAPTER 17) OR OTHERWISE THAT ARE REQUIRED BY THE BUILDING CODES, LOCAL BUILDING DEPARTMENTS, OR BY THESE PLANS SHALL BE DONE BY AN INDEPENDENT INSPECTION COMPANY OR THE BUILDING DEPARTMENT, SITE VISITS BY THE STRUCTURAL ENGINEER DO NOT CONSTITUTE AN OFFICIAL INSPECTION,
- 6. SHOP DRAWINGS SHALL BE SUBMITTED FOR ALL STRUCTURAL ITEMS IN ADDITION TO ITEMS REQUIRED BY ARCHITECTURAL SPECIFICATIONS, THE CONTRACTOR SHALL REVIEW ALL SHOP DRAWINGS PRIOR TO SUBMITTAL. ITEMS NOT IN ACCORDANCE WITH CONTRACT DRAWINGS SHALL BE FLAGGED UPON HIS REVIEW. VERIFY ALL DIMENSIONS WITH ARCHITECT. ANY CHANGES, SUBSTITUTIONS, OR DEVIATIONS FROM ORIGINAL CONTRACT DRAWINGS SHALL BE CLOUDED. ANY OF THE AFOREMENTIONED WHICH ARE NOT CLOUDED OR FLAGGED BY SUBMITTING PARTIES, SHALL NOT BE CONSIDERED APPROVED AFTER THE STRUCTURAL ENGINEER'S REVIEW, UNLESS NOTED ACCORDINGLY. ANY STRUCTURAL ENGINEERING PROVIDED BY OTHERS AND SUBMITTED FOR REVIEW, SHALL BEAR THE SEAL OF A STRUCTURAL ENGINEER REGISTERED IN THE APPROPRIATE STATE. THE SHOP DRAWINGS DO NOT REPLACE THE ORIGINAL CONTRACT DRAWINGS. ITEMS OMITTED OR SHOWN INCORRECTLY AND ARE NOT FLAGGED BY THE STRUCTURAL ENGINEER ARE NOT TO BE CONSIDERED CHANGES TO ORIGINAL DRAWINGS. THE ADEQUACY OF ENGINEERING DESIGNS AND LAYOUT PERFORMED BY THE OTHERS RESTS WITH THE DESIGNING OR SUBMITTING AUTHORITY. REVIEWING IS INTENDED ONLY AS AN AID TO THE CONTRACTOR IN OBTAINING CORRECT SHOP DRAWINGS. RESPONSIBILITY FOR CORRECTNESS SHALL REST WITH THE CONTRACTOR. ALLOW (5) WORKING DAYS FOR THE STRUCTURAL ENGINEER'S REVIEW. ONE COPY OF EACH SUBMITTAL WILL BE RETAINED FOR THE STRUCTURAL ENGINEER'S RECORDS.

BASIS FOR DESIGN:

AMENDMENTS. RISK CATEGORY = II

ULTIMATE WIND SPEED

INTERNAL PRESSURE COEFFICIENT

COMPONENT AND CLADDING PRESSURE

WIND EXPOSURE

	LOCATION	LIVE / SNOW LOAD	DEAD LOAD			
	ROOF 30 PSF		15 PSF			
3 SEISMIC DESIGN PARAMETERS:						

ANALYSIS PROCEDURE	EQUIVALENT LATERAL FORCE PROCEDURE
IMPORTANCE FACTOR	le = 1.00
SITE CLASS	С
SEISMIC DESIGN CATEGORY	В
SPECTRAL RESPONSE ACCELERATIONS	Sms = 0.532, Sm1 = 0.251
SPECTRAL RESPONSE COEFFICIENTS	Sds = 0.355, Sd1 = 0.167
HORIZONTAL SHEAR TRANSFER ELEMENT	S:
STEEL X-BRACE (S)	R = 3.25 Cs=0.109
VERTICAL SHEAR TRANSFER ELEMENTS:	
INTERMEDIATE STEEL MOMENT FRAMES(S)	R = 4.5 Cs=0.079
STEEL X-BRACE (S)	R = 3.25 Cs=0.109

101 MPH (3 SECOND GUST)

+/-0.18

COMPONENT AND CLADDING PRESSURE VARIES BY COMPONENT

AREA AND LOCATION SEE

STRUCTURAL CALCULATIONS

COORDINATE ALL DETAILS, AT NO ADDITIONAL COST TO OWNER.

NONE-THE-LESS. WHERE NO DETAILS ARE SHOWN, CONSTRUCTION SHALL CONFORM TO

- 4. ESTABLISH AND VERIFY ALL OPENINGS AND INSERTS FOR ARCHITECTURAL, MECHANICAL,
- UNLESS SPECIFICALLY CONTRACTED FOR.

1. BUILDING CODE: 2018 EDITION OF THE IBC WITH CITY/COUNTY

2 VERTICAL LOADS:

 VERTIONE EUROS.		
LOCATION	LIVE / SNOW LOAD	DEAD LOAD

LOCATION		LIVE / SNOW LOAD	DEAD LOAD
ROOF		30 PSF	15 PSF
3.	SEISMIC DESIGN PARA	AMETERS:	

ANALYSIS PROCEDURE	PROCEDURE			
IMPORTANCE FACTOR	le = 1.00			
SITE CLASS	С			
SEISMIC DESIGN CATEGORY	В			
SPECTRAL RESPONSE ACCELERATIONS	Sms = 0.532, Sm1 = 0.251			
SPECTRAL RESPONSE COEFFICIENTS	Sds = 0.355, Sd1 = 0.167			
HORIZONTAL SHEAR TRANSFER ELEMENTS:				
STEEL X-BRACE (S)	R = 3.25 Cs=0.109			
VERTICAL SHEAR TRANSFER ELEMENTS:				
INTERMEDIATE STEEL MOMENT FRAMES(S)	R = 4.5 Cs=0.079			
STEEL X-BRACE (S)	R = 3.25 Cs=0.109			
4. WIND DESIGN PARAMETERS (STRENGTH):				

ENGI	NEERING 1	TESTING	CONS	ULTANTS,
AND	UPDATED	DECEME	3ER 2	0, 2022.

FOUNDATION NOTES:

- 1. FOUNDATIONS DESIGNED IN CONFORMANCE WITH RECOMMENDATIONS BY: INC. REPORT NO. 6270 DATED FEBRUARY 5, 2007
- 2. SITE PREPARATION AND GRADING REQUIREMENTS OF THE SOIL REPORT AND ANY ADDENDUM'S SHALL BE COMPLETED PRIOR TO CONSTRUCTION OF FOUNDATIONS. ANY TESTS OR INSPECTIONS REQUIRED BY THE SOIL REPORT SHALL BE PERFORMED PRIOR TO PLACEMENT OF FOUNDATION REINFORCING STEEL OR CONCRETE. ALTERATIONS TO SITE PREPARATION OR GRADING SHALL BE REPORTED TO THE GEOTECHNICAL ENGINEER PRIOR TO FOUNDATION CONSTRUCTION.
- THE SOIL DESIGN VALUES FOR THE FOUNDATION ARE:

ALLOWABLE BEARING PRESSURE	2000 PSF
ALLOWABLE LATERAL PASSIVE PRESSURE	400 PSF/FT
ALLOWABLE LATERAL SLIDING COEFFICIENT	0.45
LATERAL BACKFILL PRESSURE (UNRESTRAINED)	35 PSF/FT
LATERAL BACKFILL PRESSURE (RESTRAINED)	55 PSF/FT
SITE CLASS	С

3. A ONE-THIRD INCREASE IN BEARING PRESSURES IS ALLOWED WITH SEISMIC OR WIND LOAD COMBINATIONS. LATERAL BEARING AND LATERAL SLIDING RESISTANCE MAY BE COMBINED.

FOUNDATION BEARING DEPTH

18" BELOW FINISHED GRADE

- 4. ALL FOUNDATIONS SHALL BEAR ON UNDISTURBED NATURAL SOIL OR COMPACTED ENGINEERED FILL 18 INCHES MINIMUM BELOW FINISH GRADE PER TABLE ABOVE. GRADE IS DEFINED AS TOP OF SLAB FOR INTERIOR FOOTINGS AND LOWEST ADJACENT GRADE WITHIN 5 FEET OF THE BUILDING FOR PERIMETER FOOTINGS. WHERE EXTERIOR PAVING OR CONCRETE IS DIRECTLY ADJACENT TO BUILDING, GRADE IS DEFINED AS TOP OF EXTERIOR PAVING AT LEAST 5 FEET FROM BUILDING. CONCRETE FOOTING EXCAVATIONS SHALL BE CLEAN AND FREE OF LOOSE DEBRIS OR UN-COMPACTED MATERIAL AT TIME OF CONCRETE PLACEMENT.
- 5. CONCRETE SLABS ON GRADE SHALL BE SUPPORTED ON A 14 INCH LAYER OF SELECT FILL MATERIAL ACCORDING TO THE SPECIFICATIONS OF THE SOIL REPORT. FILL MATERIAL SHOULD BE MOISTENED, BUT NOT SATURATED JUST PRIOR TO PLACING CONCRETE.

GENERAL STRUCTURAL NOTES

(APPLY UNLESS NOTED OTHERWISE ON PLANS/DETAILS)

CONCRETE:

1. MINIMUM 28 DAY CONCRETE STRENGTH SHALL BE AS FOLLOWS:

USE:	CONCRETE STRENGTH:	REMARKS:
FOUNDATIONS	3000 PSI	DESIGNED FOR 2500 PSI
CONCRETE SLABS ON GRADE	3000 PSI	W/O INSPECTION

- 2. ALL NORMAL WEIGHT CONCRETE SHALL BE REGULAR WEIGHT OF 150 POUNDS PER CUBIC FOOT USING HARD-ROCK AGGREGATES. AGGREGATE USED IN CONCRETE SHALL CONFORM TO ASTM C67 FOR 3/4", ASTM C57 FOR 1" AND ASTM C467 FOR 1½" AGGREGATE.
- 3. TENSION LAP SPLICES OF REINFORCING STEEL IN CONCRETE SHALL BE AS FOLLOW:

REBAR SIZE	STANDARD LAP
#3	20"
#4	32"
#5	39"
#6	47"

LAP SPLICES FOR BEAMS AND FLOOR SLABS SHALL BE ACCORDING TO CHAPTER 12 OF ACI 318 OR LAP SCHEDULE ON THESE DRAWINGS.

NO TACK WELDING OF REINFORCING BARS ALLOWED WITHOUT PRIOR REVIEW OF PROCEDURE WITH THE STRUCTURAL ENGINEER. LATEST ACI CODE AND DETAILING MANUAL APPLY, PROVIDE BENT CORNER BARS TO MATCH AND LAP WITH HORIZONTAL BARS AT ALL CORNERS AND INTERSECTIONS PER TYPICAL DETAILS. VERTICAL WALL BARS SHALL BE SPLICED AT OR NEAR FLOOR LINES.

4. ALL DIMENSIONS SHOWING THE LOCATION OF REINFORCING STEEL NOT NOTED AS "CLEAR" OR "CLR" ARE TO CENTER OF STEEL. MINIMUM COVER FOR NON-PRESTRESSED CONCRETE REINFORCING SHALL BE AS FOLLOWS:

LOCATION:	MINIMUM COVER	TOLERANCE
CAST AGAINST EARTH (FOOTINGS)	3"	± 3/8"
SLABS ON GRADE	1½"	± 1/4"
EXPOSED TO EARTH OR WEATHER — #5 AND SMALLER	1½"	± 3/8"
EXPOSED TO EARTH OR WEATHER - #6 AND LARGER	2"	± ¾"

- 5. MAXIMUM SLUMP FOR ALL CONCRETE SHALL BE 4". SLUMP FOR EXTERIOR SLABS SHALL BE 6". PORTLAND CEMENT SHALL CONFORM TO ASTM C150. TYPE V CEMENT SHALL BE USED FOR CONCRETE IN CONTACT WITH ALKALINE SOIL, AND TYPE II ELSEWHERE.
- 6. NO MORE THAN 90 MINUTES SHALL ELAPSE BETWEEN CONCRETE BATCHING AND CONCRETE PLACEMENT UNLESS APPROVED BY THE TESTING AGENCY.
- 7. CONCRETE PLACEMENT AND QUALITY SHALL BE PER RECOMMENDATIONS IN ACI 614, ACI 301 AND ACI 318. MECHANICALLY VIBRATE ALL CONCRETE WHEN PLACED, EXCEPT THAT SLABS ON GRADE NEED BE VIBRATED ONLY AROUND AND UNDER FLOOR DUCTS, ETC. CAST CLOSURE POUR, WHERE SHOWN ON PLANS AROUND COLUMNS AFTER COLUMN DEAD LOAD IS APPLIED. REMOVE ALL DEBRIS FROM FORMS BEFORE PLACING CONCRETE.

ALL ITEMS TO BE CAST IN CONCRETE SUCH AS REINFORCING, DOWELS, BOLTS, ANCHORS, PIPES, SLEEVES, ETC., SHALL BE SECURELY POSITIONED IN THE FORMS BEFORE PLACING THE CONCRETE.

8. ALL CONCRETE SLABS ON GRADE SHALL BE DIVIDED INTO AREAS BY CONTROL JOINTS (KEYED OR SAW CUT) SUCH THAT ONE SLAB AREA DOES NOT EXCEED 250 SQUARE FEET, OR BE MORE THAN TWO TIMES LONGER THAN THE SLAB AREA WIDTH. THE FOUNDATION PLAN SHOWS A SUGGESTED MFTHOD OF CONTROL JOINT LAYOUT. IT IS RECOMMENDED THAT SAW CUTS BE MADE WITHIN 16 HOURS OF CONCRETE BATCHING.

KEYED CONTROL JOINTS NEED ONLY OCCUR AT EXPOSED EDGES DURING POURING, ALL OTHER JOINTS MAY BE SAW CUT.

- 9. FLY ASH MAY BE USED ONLY IF PERMITTED BY ARCHITECTURAL SPECIFICATIONS AND SHALL BE LIMITED TO 18 PERCENT OF CEMENTITIOUS MATERIALS AND SHALL HAVE A REPLACEMENT FACTOR OF 1.2 RELATIVE TO CEMENT REPLACED. NO FLY ASH ADDITIVES SHALL BE USED IN FLATWORK OR ARCHITECTURALLY EXPOSED CONCRETE.
- 10. COLD/HOT WEATHER CONCRETE CONSTRUCTION: PROTECT CONCRETE FROM DAMAGE OR REDUCED STRENGTH IN COMPLIANCE WITH ACI 305 AND 306.

REINFORCING STEEL:

- 1. ASTM A615 GRADE 60 (FY = 60 KSI) DEFORMED BARS GRADE 60 DEFORMED BARS SHALL BE USED FOR CONCRETE WALLS, BEAMS, ELEVATED SLABS AND COLUMN
- 2. WELDING OF REINFORCING BARS SHALL BE MADE ONLY TO ASTM A706 GRADE 60 BARS AND ONLY USING E90 SERIES RODS. WELDING OF REINFORCING BARS SHALL BE MADE ONLY AT LOCATIONS SHOWN ON PLANS OR DETAILS.
- 3. REINFORCING BAR SPACING GIVEN ARE MAXIMUM ON CENTERS. ALL BARS PER CRSI SPECIFICATIONS AND HANDBOOK. DOWEL ALL VERTICAL REINFORCING TO FOUNDATION. SECURELY TIE ALL BARS IN LOCATION BEFORE PLACING CONCRETE.

STEEL:

- 1. MATERIALS: ROLLED W SHAPES, SHALL CONFORM TO ASTM A992 (FY=50 KSI). ALL OTHER STRUCTURAL STEEL SHAPES, ROLLED SECTIONS, BARS AND PLATES SHALL CONFORM TO ASTM A36 (FY = 36 KSI). ALL PIPE STEEL SHALL BE ASTM A501 (FY = 36 KSI) OR ASTM A53, TYPE E OR S, GRADE B (FY = 35 KSI). ALL TUBULAR STEEL SHALL BE ASTM A500 (FY = 46 KSI).
- 2. ALL STUDS AND WOOD TO STEEL BOLTS SHALL BE ASTM A307, UNLESS NOTED OTHERWISE. ALL EXPANSION BOLTS TO HAVE CURRENT ICBO RATING FOR MATERIAL INTO WHICH INSTALLATION TAKES PLACE. HEADED STUDS SHALL CONFORM TO ALL REQUIREMENTS OF THE LATEST EDITION OF THE "RECOMMENDED PRACTICES FOR STUD WELDING" AND THE "STRUCTURAL WELDING CODE" PUBLISHED BY AWS. ALL BOLTS, ANCHOR BOLTS, EXPANSION BOLTS, ETC. SHALL BE INSTALLED WITH STEEL WASHERS AT FACE OF WOOD OR AT SLOTTED HOLES IN STEEL SECTIONS.
- 3. ALL STRUCTURAL AND MISCELLANEOUS STEEL SHALL BE FABRICATED AND ERECTED IN ACCORDANCE WITH AISC SPECIFICATIONS FOR THE DESIGN, FABRICATION AND ERECTION OF STRUCTURAL STEEL FOR BUILDINGS, LATEST EDITION.
- 4. WELDING SHALL BE BY WELDERS HOLDING VALID CERTIFICATES AND HAVING CURRENT EXPERIENCE IN THE TYPE OF WELD SHOWN ON THE DRAWINGS OR NOTES. ALL WELDING SHALL USE E70 SERIES LOW HYDROGEN RODS UNLESS NOTED OTHERWISE. ALL WELDING PER LATEST AMERICAN WELDING SOCIETY STANDARDS. ALL WELDS ON DRAWINGS ARE SHOWN AS SHOP WELDS. CONTRACTOR MAY SHOP WELD OR FIELD WELD AT HIS DISCRETION. ALL FULL PENETRATION WELDS SHALL BE TESTED AND CERTIFIED BY AN INDEPENDENT TESTING LABORATORY.
- 5. STEEL TO STEEL BOLTED CONNECTIONS: HIGH STRENGTH BOLTS SHALL BE ASTM A325N AND SHALL BE INSTALLED AS BEARING-TYPE CONNECTIONS WITH THREADS INCLUDED IN SHEAR PLANE (TYPE "N" CONNECTION). BOLTS MAY BE TIGHTENED USING ANY AISC
- 6. DRYPACK SHALL BE 5,000 PSI FIVE STAR NON-SHRINK GROUT OR EQUIVALENT. INSTALL DRYPACK UNDER BEARING PLATES BEFORE FRAMING MEMBER IS INSTALLED. AT COLUMNS, INSTALL DRYPACK UNDER BASE PLATES AFTER COLUMN HAS BEEN PLUMBED BUT PRIOR TO FLOOR OR ROOF INSTALLATION.

COLD FORMED STEEL (ICBO ER 4943P):

- 1. MATERIALS: STANDARD COLD-FORMED STEEL STUDS, JOISTS, TRACK, BRIDGING AND STRAPS SHALL CONFORM TO AISI NAS-01 WITH 2004 SUPPLEMENT (FY = 33 KSI). STEEL FOR PURLINS AND GIRTS SHALL CONFORM TO (FY = 55 KSI). STEEL SHALL BE GALVANIZED AT EXTERIOR WALLS AND FRAMING.
- 2. FRAMING SHALL BE FABRICATED AND ERECTED IN ACCORDANCE WITH MANUFACTURER'S RECOMMENDATIONS AND IN ACCORDANCE WITH THE LATEST EDITION OF "SPECIFICATIONS FOR THE DESIGN OF COLD-FORMED STEEL STRUCTURAL MEMBERS" BY THE AMERICAN IRON AND STEEL INSTITUTE(AISI).
- 3. ALL STUDS SHALL BE SECURELY SEATED FOR FULL END BEARING ON TOP AND BOTTOM TRACK. UNLESS NOTED OTHERWISE, PROVIDE DOUBLE STUDS AT ALL JAMBS, CORNERS, INTERSECTIONS, BEAM BEARINGS AND JOIST BEARINGS.
- 4. ALL WELDING SHALL BE PERFORMED BY WELDERS EXPERIENCED IN LIGHT GAGE STRUCTURAL STEEL FRAMING WORK. MEMBERS SHALL HAVE THE FOLLOWING MINIMUM EFFECTIVE PROPERTIES PER STEEL STUD MANUFACTURERS ASSOCIATION(SSMA):

TYPE/STYLE	MEMBER	MILS(GA)	FY
3%"X20GA. STUD	362S162-33	33(20)	33KSI
3%"X20GA. TRACK	362T162-33	33(20)	33KSI
6"X18GA. STUD	600S162-43	43(18)	33KSI
6"X18GA. TRACK	600T162-43	43(18)	33KSI
6"X18GA. TRACK	600T162-43	43(18)	33KSI

SPECIAL INSPECTION ITEMS:

1. THE OWNER SHALL EMPLOY A SPECIAL INSPECTOR DURING CONSTRUCTION OF CERTAIN TYPES OF WORK. PER IBC SECTION 1704 AND THE STRUCTURAL ENGINEER OF RECORD, SPECIAL INSPECTION IS (IS NOT) REQUIRED AS FOLLOWS:

TYPE OF WORK:	REQUIRED:	REMARKS:
SOIL BEARING SUBGRADE	YES	PER GEOTECHNICAL ENGINEER
CONCRETE SLAB ON GRADE	NO	DESIGN BASED ON f'c=2500 PSI
CONCRETE FOUNDATIONS	NO	DESIGN BASED ON f'c=2500 PSI
REINFORCING STEEL FOR ALL CONCRETE/ MASONRY THAT REQUIRES INSPECTION	YES	PRIOR TO PLACEMENT OF CONCRETE OR GROUT
BOLTS, ANCHORS CAST IN CONCRETE	YES	DURING PLACEMENT OF CONCRETE
STEEL TO STEEL BOLTED CONNECTIONS	YES	AFTER WORK IS COMPLETE

SPECIAL INSPECTIONS NOT LISTED ABOVE ARE NOT REQUIRED BY FSE HOWEVER, ADDITIONAL SPECIAL INSPECTIONS MAY BE REQUIRED BY THE BUILDING OFFICIAL

- 2. DESIGNATION OF SPECIAL INSPECTOR: A SPECIAL INSPECTION CERTIFICATE - CORRESPONDING TO THE REQUIREMENTS IN THE TABLE ABOVE HAS BEEN PROVIDED WITH THESE DRAWINGS BY FSE FOR PERMITTING PURPOSES.
- A. ACCORDING TO THE SI CERTIFICATE, THE SPECIAL INSPECTOR SHALL BE, OR WORK UNDER THE DIRECT SUPERVISION OF THE STRUCTURAL ENGINEER OF RECORD -FROST STRUCTURAL ENGINEERING(FSE) (928)776-4757. FSE IS NOT RESPONSIBLE FOR SPECIAL INSPECTIONS IF WE ARE NOT CONTACTED OR CONTRACTED TO DO
- B. TO SCHEDULE ANY SPECIAL INSPECTION, THE CONTRACTOR SHALL BE RESPONSIBLE FOR CONTACTING THE SPECIAL INSPECTOR AT LEAST ONE DAY IN ADVANCE.
- C. AN ALTERNATE SPECIAL INSPECTOR MAY BE USED BY OBTAINING A NEW SI CERTIFICATE, AND MAKE THE NECESSARY NOTIFICATIONS TO ALL PARTIES INVOLVED. THE ALTERNATE SPECIAL INSPECTOR SHALL BE AN ARIZONA LICENSED CIVIL OR STRUCTURAL ENGINEER OR AN ICC CERTIFIED SPECIAL INSPECTOR.
- D. FOR GEOTECHNICAL ITEMS LISTED ABOVE, THE SPECIAL INSPECTOR SHALL BE, OR WORK UNDER THE DIRECT SUPERVISION OF A GEOTECHNICAL ENGINEER OR THE BUILDING OFFICIAL.
- 3. QUALITY ASSURANCE PROGRAM:
- A. THE SPECIAL INSPECTOR SHALL OBSERVE THE WORK ASSIGNED TO BE CERTAIN IT CONFORMS WITH THE APPROVED DESIGN DRAWINGS AND SPECIFICATIONS.
- B. THE SPECIAL INSPECTOR SHALL FURNISH INSPECTION REPORTS TO THE BUILDING OFFICIAL, AND TO THE STRUCTURAL ENGINEER OF RECORD. ALL DISCREPANCIES SHALL BE BROUGHT TO THE IMMEDIATE ATTENTION OF THE CONTRACTOR FOR CORRECTION, THEN, IF UNCORRECTED, TO THE DESIGN AUTHORITY AND THE BUILDING OFFICIAL.
- C. UPON COMPLETION OF THE ASSIGNED WORK THE STRUCTURAL ENGINEER SHALL COMPLETE AND SIGN THE APPROPRIATE FORMS CERTIFYING THAT TO THE BEST OF HIS KNOWLEDGE THE WORK IS IN CONFORMANCE WITH THE APPROVED PLANS AND SPECIFICATIONS, AND THE APPLICABLE WORKMANSHIP PROVISIONS OF THE INTERNATIONAL BUILDING CODE.

DRAWING INDEX SHEET DESCRIPTION DETAILS GENERAL STRUCTURAL NOTES ____ S1.1 TYPICAL DETAILS T-SERIES S1.2 T-SERIES TYPICAL DETAILS FOUNDATION PLAN ___ S3 ROOF FRAMING PLAN ---S3.1 STRUCTURAL FRAMING ELEVATIONS ____ \$4 FOUNDATION DETAILS 100-SERIES S5 FRAMING DETAILS 200-SERIES

This drawing is the property of FROST Structural Engineering, Inc. Legally, the drawing can NOT be copied in whole or in pieces. It is only to be used for the project and site specifically identified hereon and is not to be used on any other t. Contractor shall carefully review all dimensions, details, and conditions and report at once any error, inconsistency or omission discovered before construction. The contractor assumes full liability for deviations from the intent of these plans.

JOB NO.: 2024-076 PROJECT MANAGER: RKF

Prescott, Arizona 86305

FROST STRUCTURAL ENGINEERING

1678 Oaklawn Drive, Suite C phone: 928.776.4757 info@frost-structural.com www.frost-structural.com

CAD OPERATOR: IMC

REVISIONS

These drawings are the property of W. Alan Kenson & Associates P.C. and may not be reproduced in any way without the written consent of W. Alan Kenson & Associates, P.C.







4

SSOC

DRAWN B' IMC CHECKED BY RKF 6/17/24 JOB NO. 2024-076

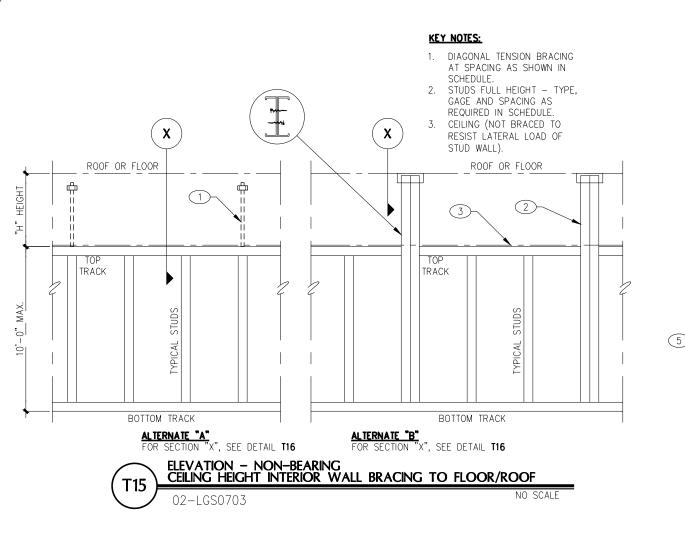


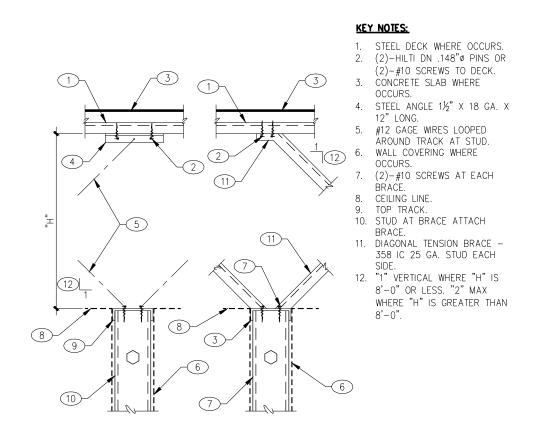


NON-BEARING TOP TRACK SUPPORT DETAIL - TOP CONNECTION 02-LGS0704


KEY NOTES: 1. METAL WALL PANEL PER


- 2. METAL ROOF PANEL PER 3. #12 X 1.25" SELF-TAPPING
- TEKS SCREWS AT 12" O.C. 4. #12 X 1.25" SELF-TAPPING TEKS SCREWS WITH
- NEOPRENE WASHERS AT 12"
- 5. WALL PANEL STITCH SCREW:
- #14 X %" SELF-TAPPING TEKS SCREWS AT 18" O.C
- 6. ROOF PANEL STITCH SCREW: #14 X 1/8" SELF-TAPPING

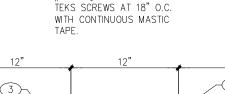


WALL PANELS - ATTACHMENT AT PANEL ENDS

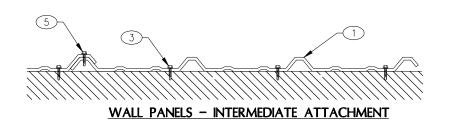

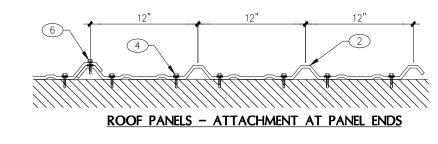

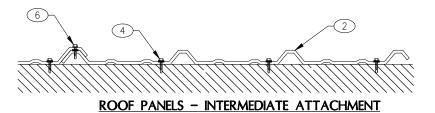

(T17) TYPICAL "PBR" PANEL ROOFING/SIDING ATTACHMENT

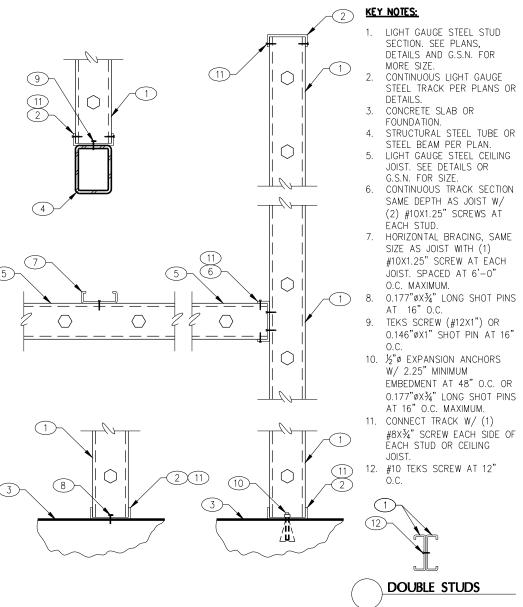

TYPICAL LIGHT GAUGE STEEL CONNECTIONS

GENERAL STRUCTURAL NOTES:

- 1. ALL COLD-FORMED STEEL FRAMING SHALL BE FABRICATED AND ACCORDANCE WITH MANUFACTURER'S RECOMMENDATIONS AND IN ACCORDANCE WITH THE LATEST EDITION OF "SPECIFICATIONS FOR THE DESIGN OF COLD-FORMED STEEL STRUCTURAL MEMBERS" BY THE AMERICAN IRON AND STEEL INSTITUTE AND METAL STUD MANUFACTURER'S
- ASSOCIATION ICBO #4943.

 2. STEEL FOR ALL STUDS AND FOR ALL GAGES OF TRACK, ACCESSORIES AND BRIDGING SHALL HAVE A MINIMUM YIELD STRENGTH OF 33 KSI.

 3. ALL STUDS SHALL BE SECURELY SEATED FOR FULL END BEARING ON TOP AND BOTTOM TRACK. UNLESS NOTED OTHERWISE, PROVIDE DOUBLE STUDS AT ALL JAMBS, CORNERS, AND INTERSECTIONS. BRIDGING SHALL BE INSTALLED PER MANUFACTURER'S RECOMMENDATIONS AT MID HEIGHT OF WALL FOR WALLS LESS THAN 10'-0" HIGH, AND AT 5'-0" FOR WALLS GREATER THAN 10'-0" HIGH.


ALLOWABLE WALL HEIGHTS FOR FULL HEIGHT INTERIOR WALL PARTITIONS					BRACE SPACING	
CTUD	CLZE	TDACK	CLZE	STUD S	WHERE OCCURS	
STUD	SIZE	TRACK	SIZE	16" O.C.	24" O.C.	
600 XC	20GA	600 MT	20GA	32'-3" A.F.F.	28'-4" A.F.F.	10'-0" O.C.
358 XC	20GA	358 MT	20GA	21'-11" A.F.F.	19'-2" A.F.F.	10'-0" O.C.
358 XC	20GA	358 MT	20GA	14'-3" A.F.F.	11'-7" A.F.F.	8'-0" O.C.
250 XC	20GA	250 MT	20GA	16'-6" A.F.F.	14'-5" A.F.F.	8'-0" O.C.
250 XC	20GA	250 MT	20GA	11'-6" A.F.F.	9'-6" A.F.F.	8'-0" O.C.


VALUES BASED ON NO AXIAL LOAD, 5 PSF LATERAL LOAD, AND A DEFLECTION LIMIT OF H/120 (VERIFY WITH ARCHITECTURAL SPECIFICATIONS FOR SPECIAL REQUIREMENT). BRACING DESIGN BASED ON MAXIMUM HEIGHT (TO CEILING) OF 10'-0".


INSTALLATION OPTIONS:

- 1. STEEL STUDS WALLS THAT SPAN FULL HEIGHT TO UNDERSIDE OF STRUCTURE MAY BE INSTALLED UN-BRACED PER SCHEDULE ABOVE. 2. STEEL STUD WALLS PER SCHEDULE ABOVE MAT BE INSTALLED WHEN BRACED PER DETAIL 34 OR 35.
- 3. PLANS AND DETAILS OF OPTIONAL METHODS SHALL BE PROVIDED TO THE ENGINEER FOR REVIEW PRIOR TO INSTALLATION. 4. FOR ADDITIONAL INFORMATION, SEE DETAILS T9 THRU T16.
- 5. BOTTOM TRACK SHALL BE ATTACHED TO CONCRETE FLOORS USING 1/2" Ø EXPANSION ANCHORS AT 48" O.C. (2 MIN PER TRACK) WITH 4" EMBEDMENT.




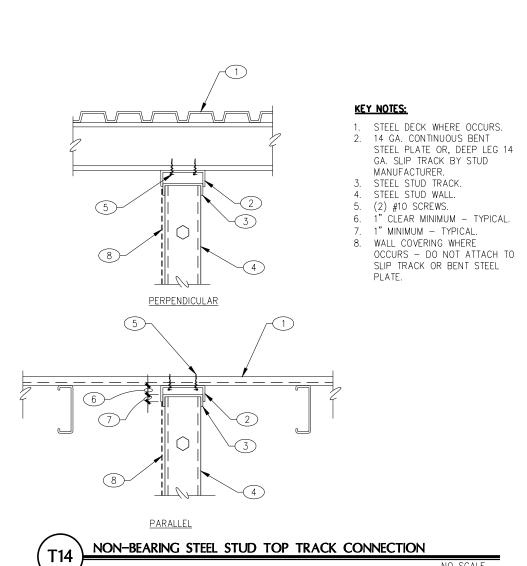

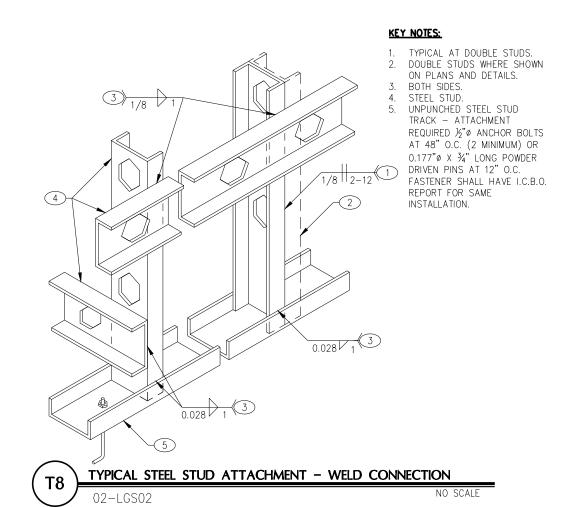


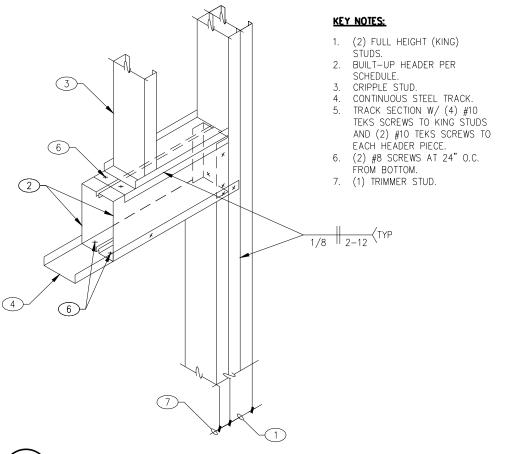



LIGHT GUAGE STEEL BOX-BEAM HEADER

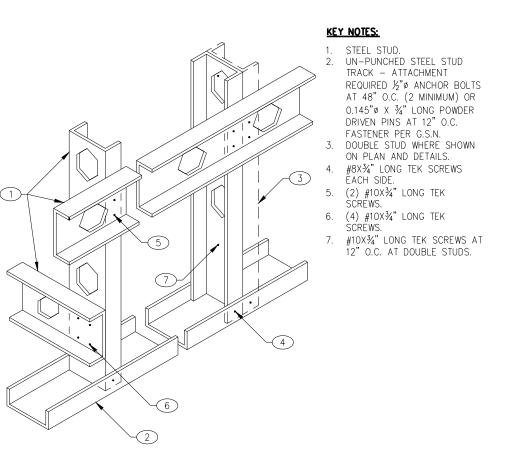


TYPICAL STEEL STUD ATTACHMENT - SCREW CONNECTION

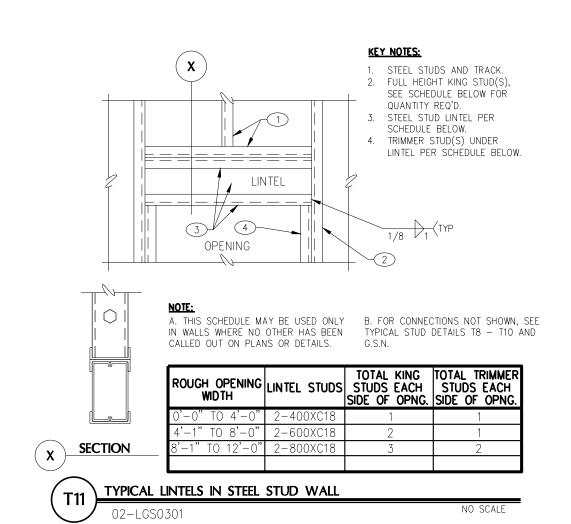

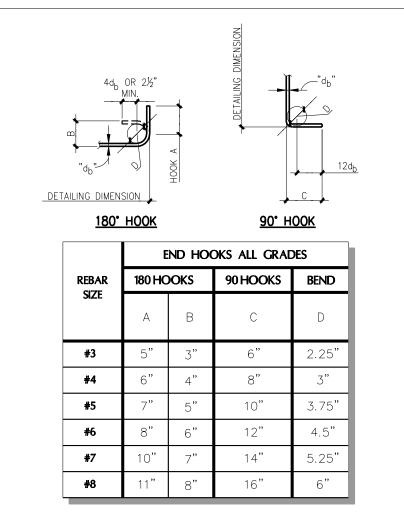

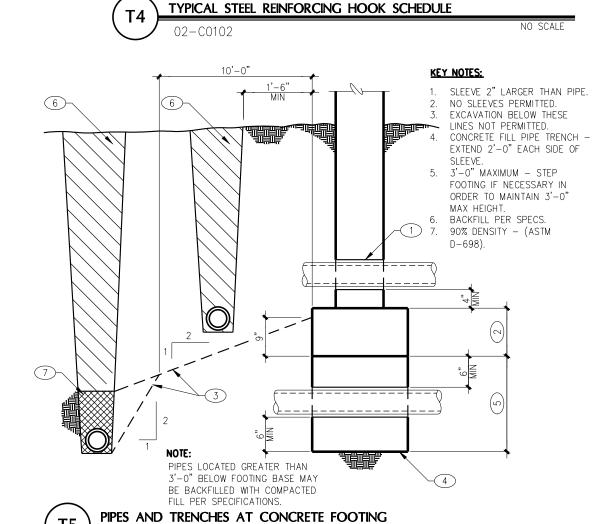


BOLT	CAST I EMBEDMEN	CAST IN PLACE EMBEDMENT(MINIMUM)		N ANCHOR
SIZE	VERTICAL	HORIZONTAL	VERTICAL	HORIZONTAL
1/4"ø	4"	4"	2"	1.125"
3/8"ø	5"	4"	3"	1.5"
1/2 " ø	7"	4"	4"	2"
5/8 " ø	8"	5"	5"	2.5"
3/4 " ø	9"	6"	6"	3"
7/8 " ø	10"	7"	7"	3.5"
1 " ø	11"	8"	9"	4"

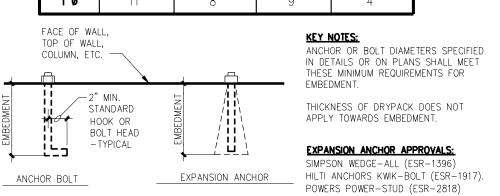



TYPICAL ANCHOR BOLT, AND EXPANSION BOLT SCHEDULE

ALL THREAD SIZE	REBAR SIZE	SPACING OR EDGE DISTANCE	EMBEDMENT DEPTH	SPACING OR EDGE DISTANCE	EMBEDMENT DEPTH
3/8"ø	#3	2" TO 6"	8"	6" MIN.	6"
1/2 " ø	#4	2" TO 6"	11"	6" MIN.	6"
5/8"ø	# 5	2" TO 7.5"	12"	7.5" MIN.	7"
3/4"ø	#6	2" TO 9"	14"	9" MIN.	9"
7/8"ø	# 7	3" TO 10.5"	16"	10.5" MIN.	11"
1"ø	#8	3" TO 12"	20"	12" MIN.	14"

1. CONCRETE: USE HILTI HIT-RE 500-SD ADHESIVE (ESR-2322) OR SIMPSON SET-XP (ESR-2508). MASONRY: USE SIMPSON "SET" ADHESIVE (ESR-1772). 2. INSTALL ALL SYSTEMS ACCORDING TO MANUFACTURERS RECOMMENDATIONS. 3. DO NOT PLACE ALL—THREAD ROD WITHIN MINIMUM EDGE DISTANCE TO FREE

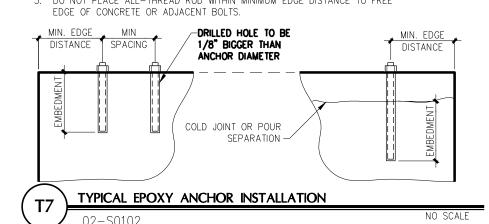

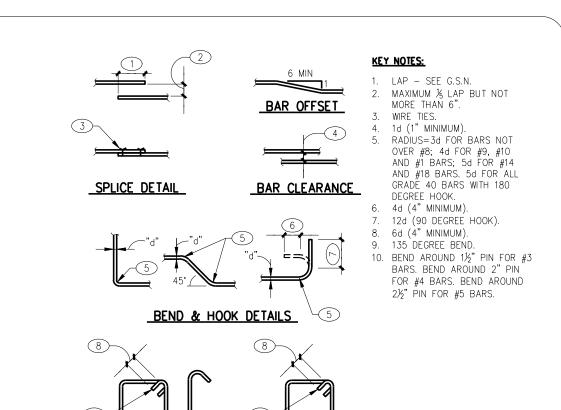

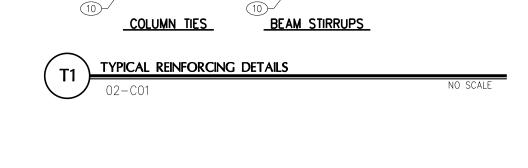


	CLASS B TENSION SPLICE LENGTHS						COMP. BARS	
REBAR	f′c=3,00	O PSI	f'c=4,000	O PSI	f'c=5,00	o psi	f'o	= ≥ 3,000
SIZE (METRIC)	REGULAR	TOP	REGULAR	TOP	REGULAR	TOP	STD. LAP	ENCLOSED W/ SPIRAL TIES
#3	24"	31"	19"	24"	17"	22"	12"	12"
#4 (13)	32"	41"	25"	32"	22"	29"	15"	12"
#5 (16)	39"	51"	31"	40"	28"	36"	19"	14"
#6 (19)	47"	61"	37"	48"	33"	43"	23"	17"
#7 (22)	69"	89"	54"	70"	49"	63"	26"	20"
#8 (25)	78"	102"	62"	80"	55"	72"	30"	23"
#9	88"	115"	70"	91"	63"	81"	34"	25"
#10	99"	129"	79"	102"	70"	91"	38"	28"
#11	110"	143"	87"	113"	78"	101"	42"	31"

NOTES:

SO THAT MORE THAN 12" OF FRESH CONCRETE IS CAST IN THE MEMBER BELOW THE REINFORCEMENT. 2. UNLESS NOTED OTHERWISE, LAP SPLICES IN CONCRETE BEAMS, SLABS AND WALLS SHALL BE CLASS "B" TENSION LAP SPLICES AND LAP SPLICES IN CONCRETE COLUMNS



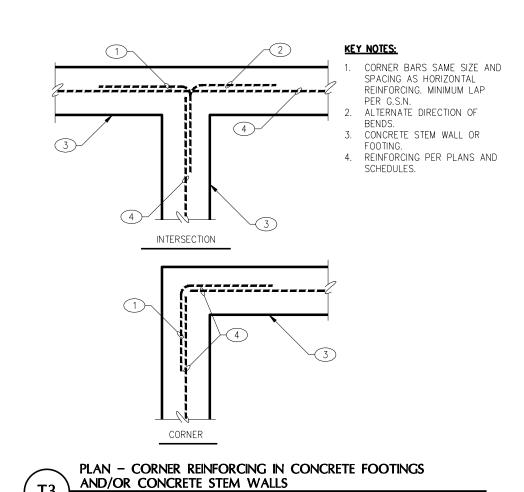

This drawing is	the property of FROS	Structural En	gineering, Inc. Legall	y, the
drawing can N	OT be copied in whole	or in pieces. It	is only to be used	for the
project and si	te specifically identified	hereon and is	not to be used on	any other
project. Contr	actor shall carefully revi	ew all dimensic	ns, details, and con	iditions and
	any error, inconsistenc			
The contractor	assumes full liability f	or deviations fr	om the intent of th	iese plans.

JOB NO.: 2024-076 PROJECT MANAGER: RKF FROST STRUCTURAL ENGINEERING

1678 Oaklawn Drive, Suite C phone: 928.776.4757 info@frost-structural.com Prescott, Arizona 86305 www.frost-structural.com

REVISIONS

These drawings are the property of

W. Alan Kenson & Associates P.C.

and may not be reproduced in any


way without the written consent of


W. Alan Kenson & Associates, P.C.


te

DR

DRAWN BY IMC CHECKED BY RKF 6/17/24 JOB NO. 2024-076

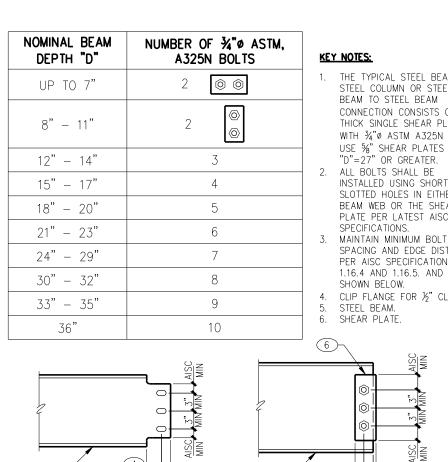

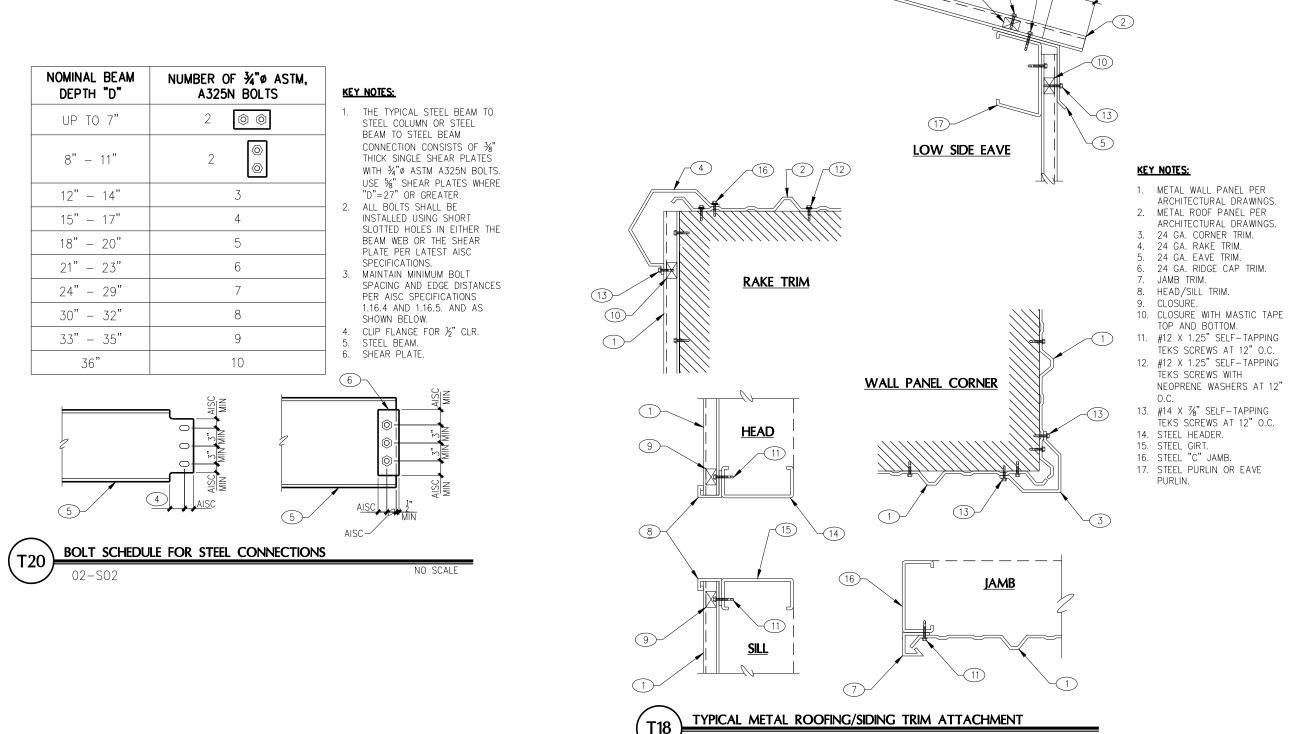

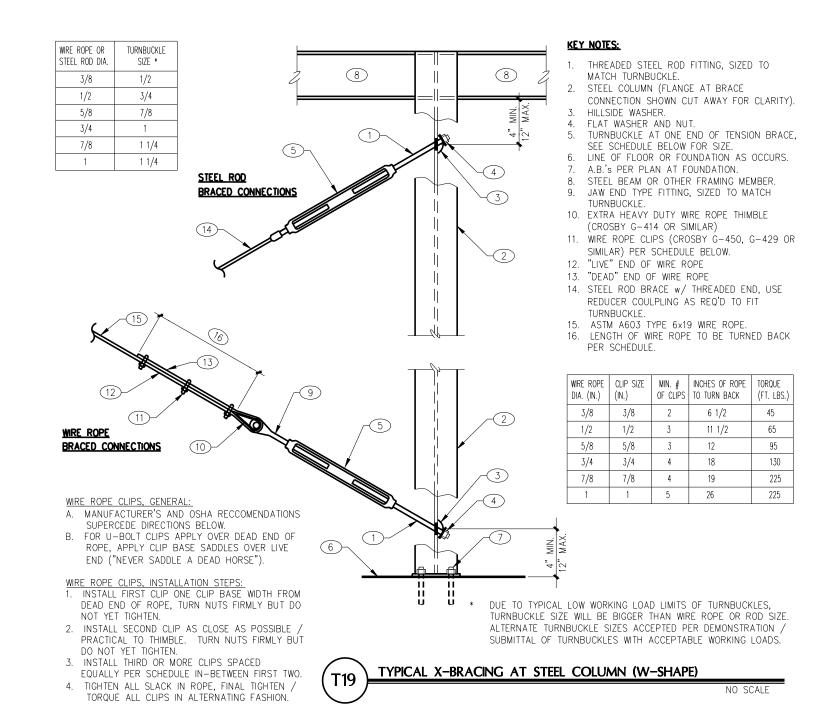

This drawing is the property of FROST Structural Engineering, Inc. Legally, the drawing can NOT be copied in whole or in pieces. It is only to be used for the project and site specifically identified hereon and is not to be used on any other project. Contractor shall carefully review all dimensions, details, and conditions and report at once any error, inconsistency or omission discovered before construction. The contractor assumes full liability for deviations from the intent of these plans.

1678 Oaklawn Drive, Suite C phone: 928.776.4757
Prescott, Arizona 86305 info@frost-structural.com www.frost-structural.com

JOB NO.: 2024-076 PROJECT MANAGER: RKF CAD OPERATOR: IMC FROST STRUCTURAL ENGINEERING

REVISIONS

These drawings are the property of W. Alan Kenson & Associates P.C., and may not be reproduced in any way without the written consent of W. Alan Kenson & Associates, P.C.




ates

SSOCI

DRAWN BY IMC CHECKED BY RKF 6/17/24 JOB NO.

DR

2024-076 SHEET

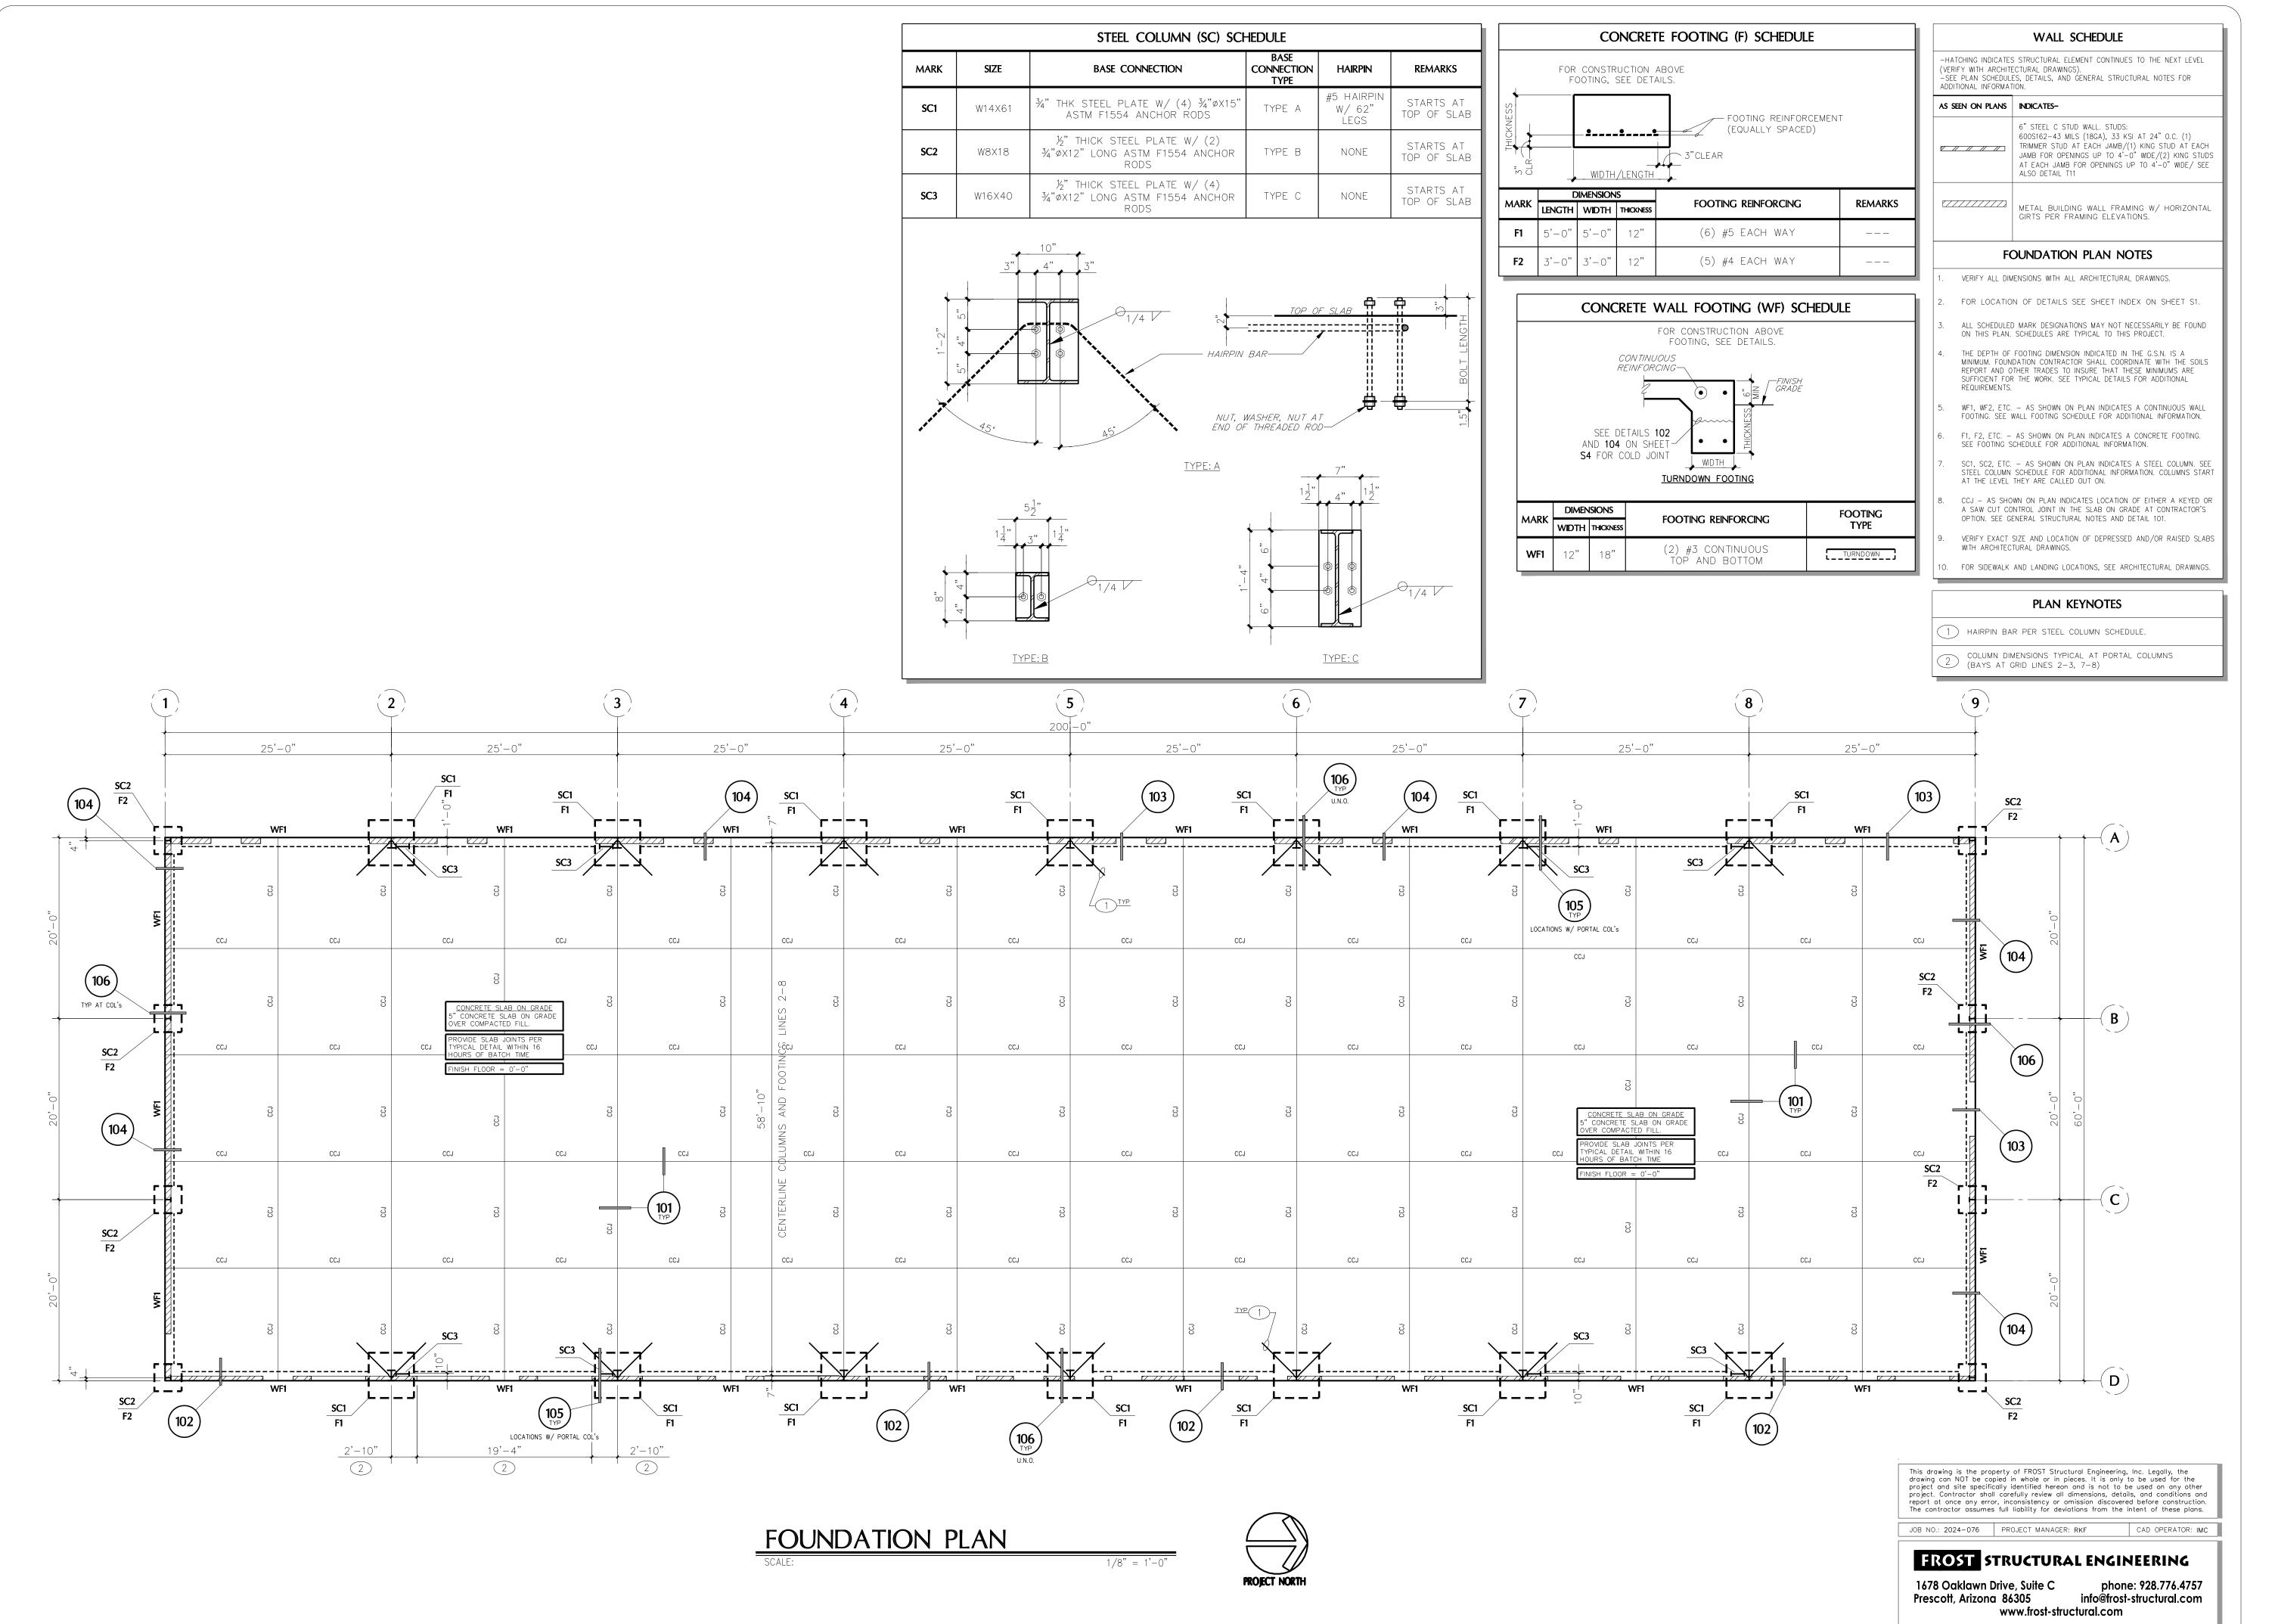

REVISIONS

These drawings are the property of W. Alan Kenson & Associates P.C., and may not be reproduced in any way without the written consent of



W. Alan Kenson & Associates, P.C.

SSOC

DRAWN BY IMC CHECKED BY RKF 6/17/24

> JOB NO. 2024-076

STEEL BEAM (B) SCHEDULE					
MARK	SIZE	CAMBER			
B1	W24X62	STANDARD			
B2	W8X18	STANDARD			
В3	W12X19	STANDARD			
B4	W16X40				

STEEL PURLIN (SP) SCHEDULE					
MARK	SIZE	REMARKS			
SP1	8"X2.5"X12GA. 'Z' PURLIN AT 5'-0" O.C.				

	EAVE STRUT (S) SCHEDULE
MARK	SIZE
S1	8"x5"x5", 14GA.

	STEEL BEAM (B) S			WALL SCHEDUL	
ιK	SIZE	CAMBER	NOTE:		CHEDULES, DETAILS AND GENE
	W24X62	STANDARD	AS SEEN	ON PLANS	INDICATES-
	W8X18	STANDARD	710 02211	011127210	STRUCTURAL WALL BELOW (
	W12X19	STANDARD		=====	OR EXTERIOR WALL).
	W16X40		==	===	NON-STRUCTURAL WALL BE
					PARAPET WALL.

	STEEL PURLIN (SP) SCHEDI	JLE
MARK	SIZE	REMARKS
SP1	8"X2.5"X12GA. 'Z' PURLIN AT 5'-0" O.C.	

	EAVE STRUT (S) SCHEDULE
MARK	SIZE
S1	8"x5"x5", 14GA.

			WALL SCHEDULE					
	NOTE:		CHEDULES, DETAILS AND GENERAL STRUCTURAL NOTES NAL INFORMATION.					
-	AS SEEN	ON PLANS	INDICATES-					
\dashv	c===	=====	STRUCTURAL WALL BELOW (BEARING WALL, SHEARWA OR EXTERIOR WALL).					
		===	NON-STRUCTURAL WALL BELOW.					
			PARAPET WALL.					

ROOF FRAMING PLAN NOTES


VERIFY ALL DIMENSIONS WITH ALL ARCHITECTURAL DRAWINGS. FOR LOCATION OF DETAILS SEE SHEET INDEX ON SHEET S1.
ALL SCHEDULED MARK DESIGNATIONS MAY NOT NECESSARILY BE FOUND ON THIS PLAN. SCHEDULES ARE TYPICAL TO THIS PROJECT. B1, B2, ETC. — AS SHOWN ON PLAN INDICATES A STEEL BEAM. SEE STEEI BEAM SCHEDULE FOR ADDITIONAL INFORMATION. SP1, SP2, ETC. — AS SHOWN ON PLAN INDICATES STEEL PURLINS. SEE STEEL PURLIN SCHEDULE FOR ADDITIONAL INFORMATION. S1, S2, ETC. — AS SHOWN ON PLAN INDICATES EAVE STRUTS SEE EAVE STRUT SCHEDULE FOR ADDITIONAL INFORMATION. FOR CLARITY, DETAILS MAY SHOW ONLY ONE SIDE OF FRAMING CONDITION

FOR CLARITY, ALL ROOF OPENINGS MAY NOT BE SHOWN ON THE ROOF FRAMING PLAN. FOR EXACT SIZE, NUMBER AND LOCATION OF OPENINGS, SEE ARCHITECTURAL, MECHANICAL, PLUMBING, AND ELECTRICAL DRAWINGS. FOR FRAMING AT OPENINGS, SEE TYPICAL DETAILS. VERIFY EXACT SIZE AND WEIGHT OF EQUIPMENT ON ROOF WITH MECHANICAL CONTRACTOR.

PLAN KEYNOTES

L2X½X2½X¼ BRACES AT EVERY OTHER PURLIN AS SHOWN SEIDETAIL 201.

2 X-BRACING, SEE SHEET **S3.1**.

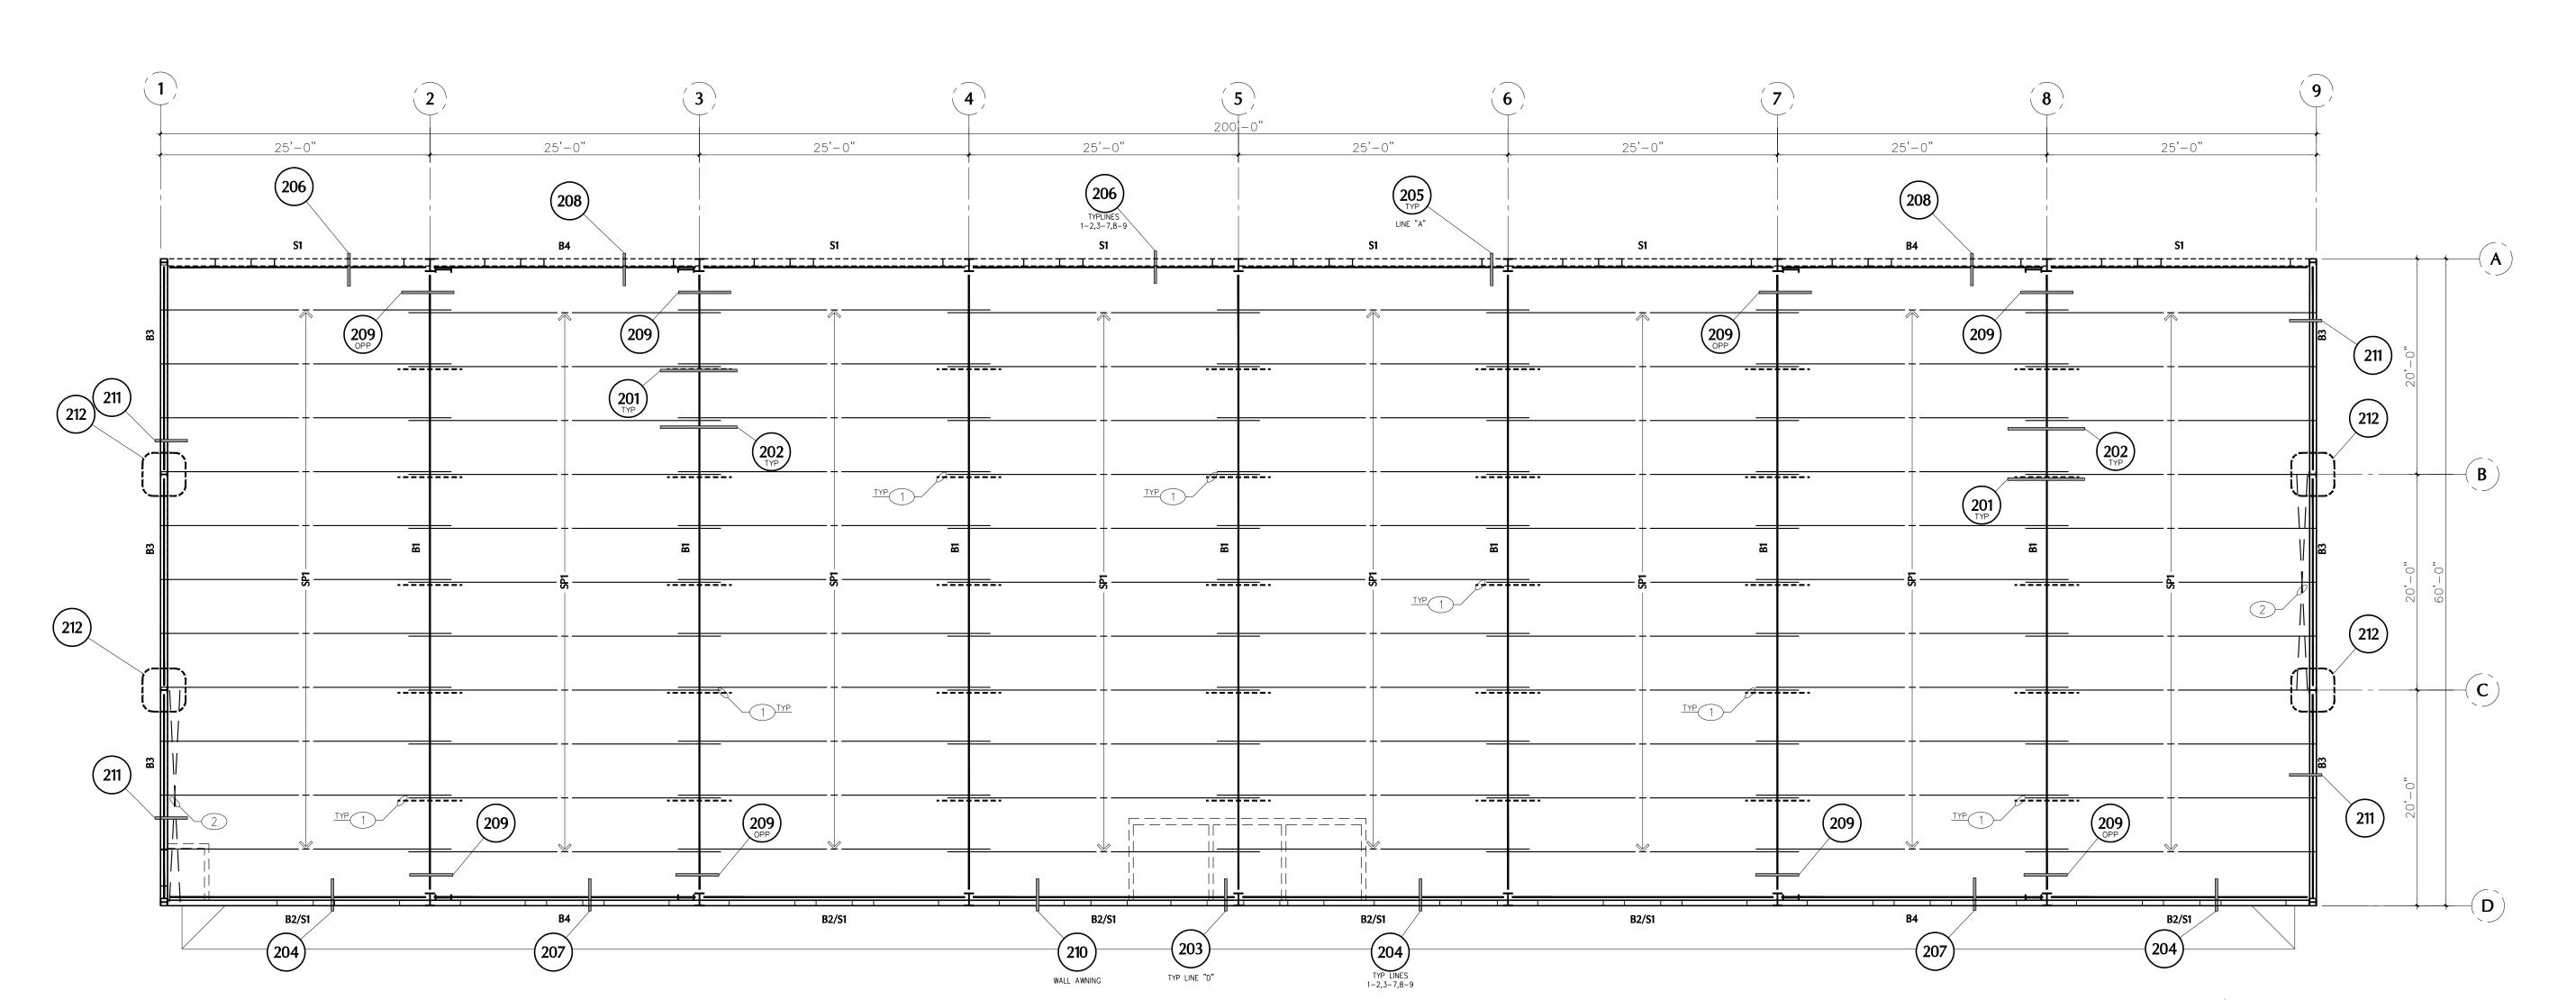

ROOF FRAMING PLAN

SCALE:



This drawing is the property of FROST Structural Engineering, Inc. Legally, the drawing can NOT be copied in whole or in pieces. It is only to be used for the project and site specifically identified hereon and is not to be used on any other project. Contractor shall carefully review all dimensions, details, and conditions and report at once any error, inconsistency or omission discovered before construction. The contractor assumes full liability for deviations from the intent of these plans.

JOB NO.: 2024-076 PROJECT MANAGER: RKF

FROST STRUCTURAL ENGINEERING

1678 Oaklawn Drive, Suite C phone: 928.776.4757
Prescott, Arizona 86305 info@frost-structural.com www.frost-structural.com


REVISIONS


These drawings are the property of W. Alan Kenson & Associates P.C., and may not be reproduced in any way without the written consent of W. Alan Kenson & Associates, P.C.

DRAWN BY IMC CHECKED BY RKF 6/17/24

JOB NO.

2024-076 SHEET

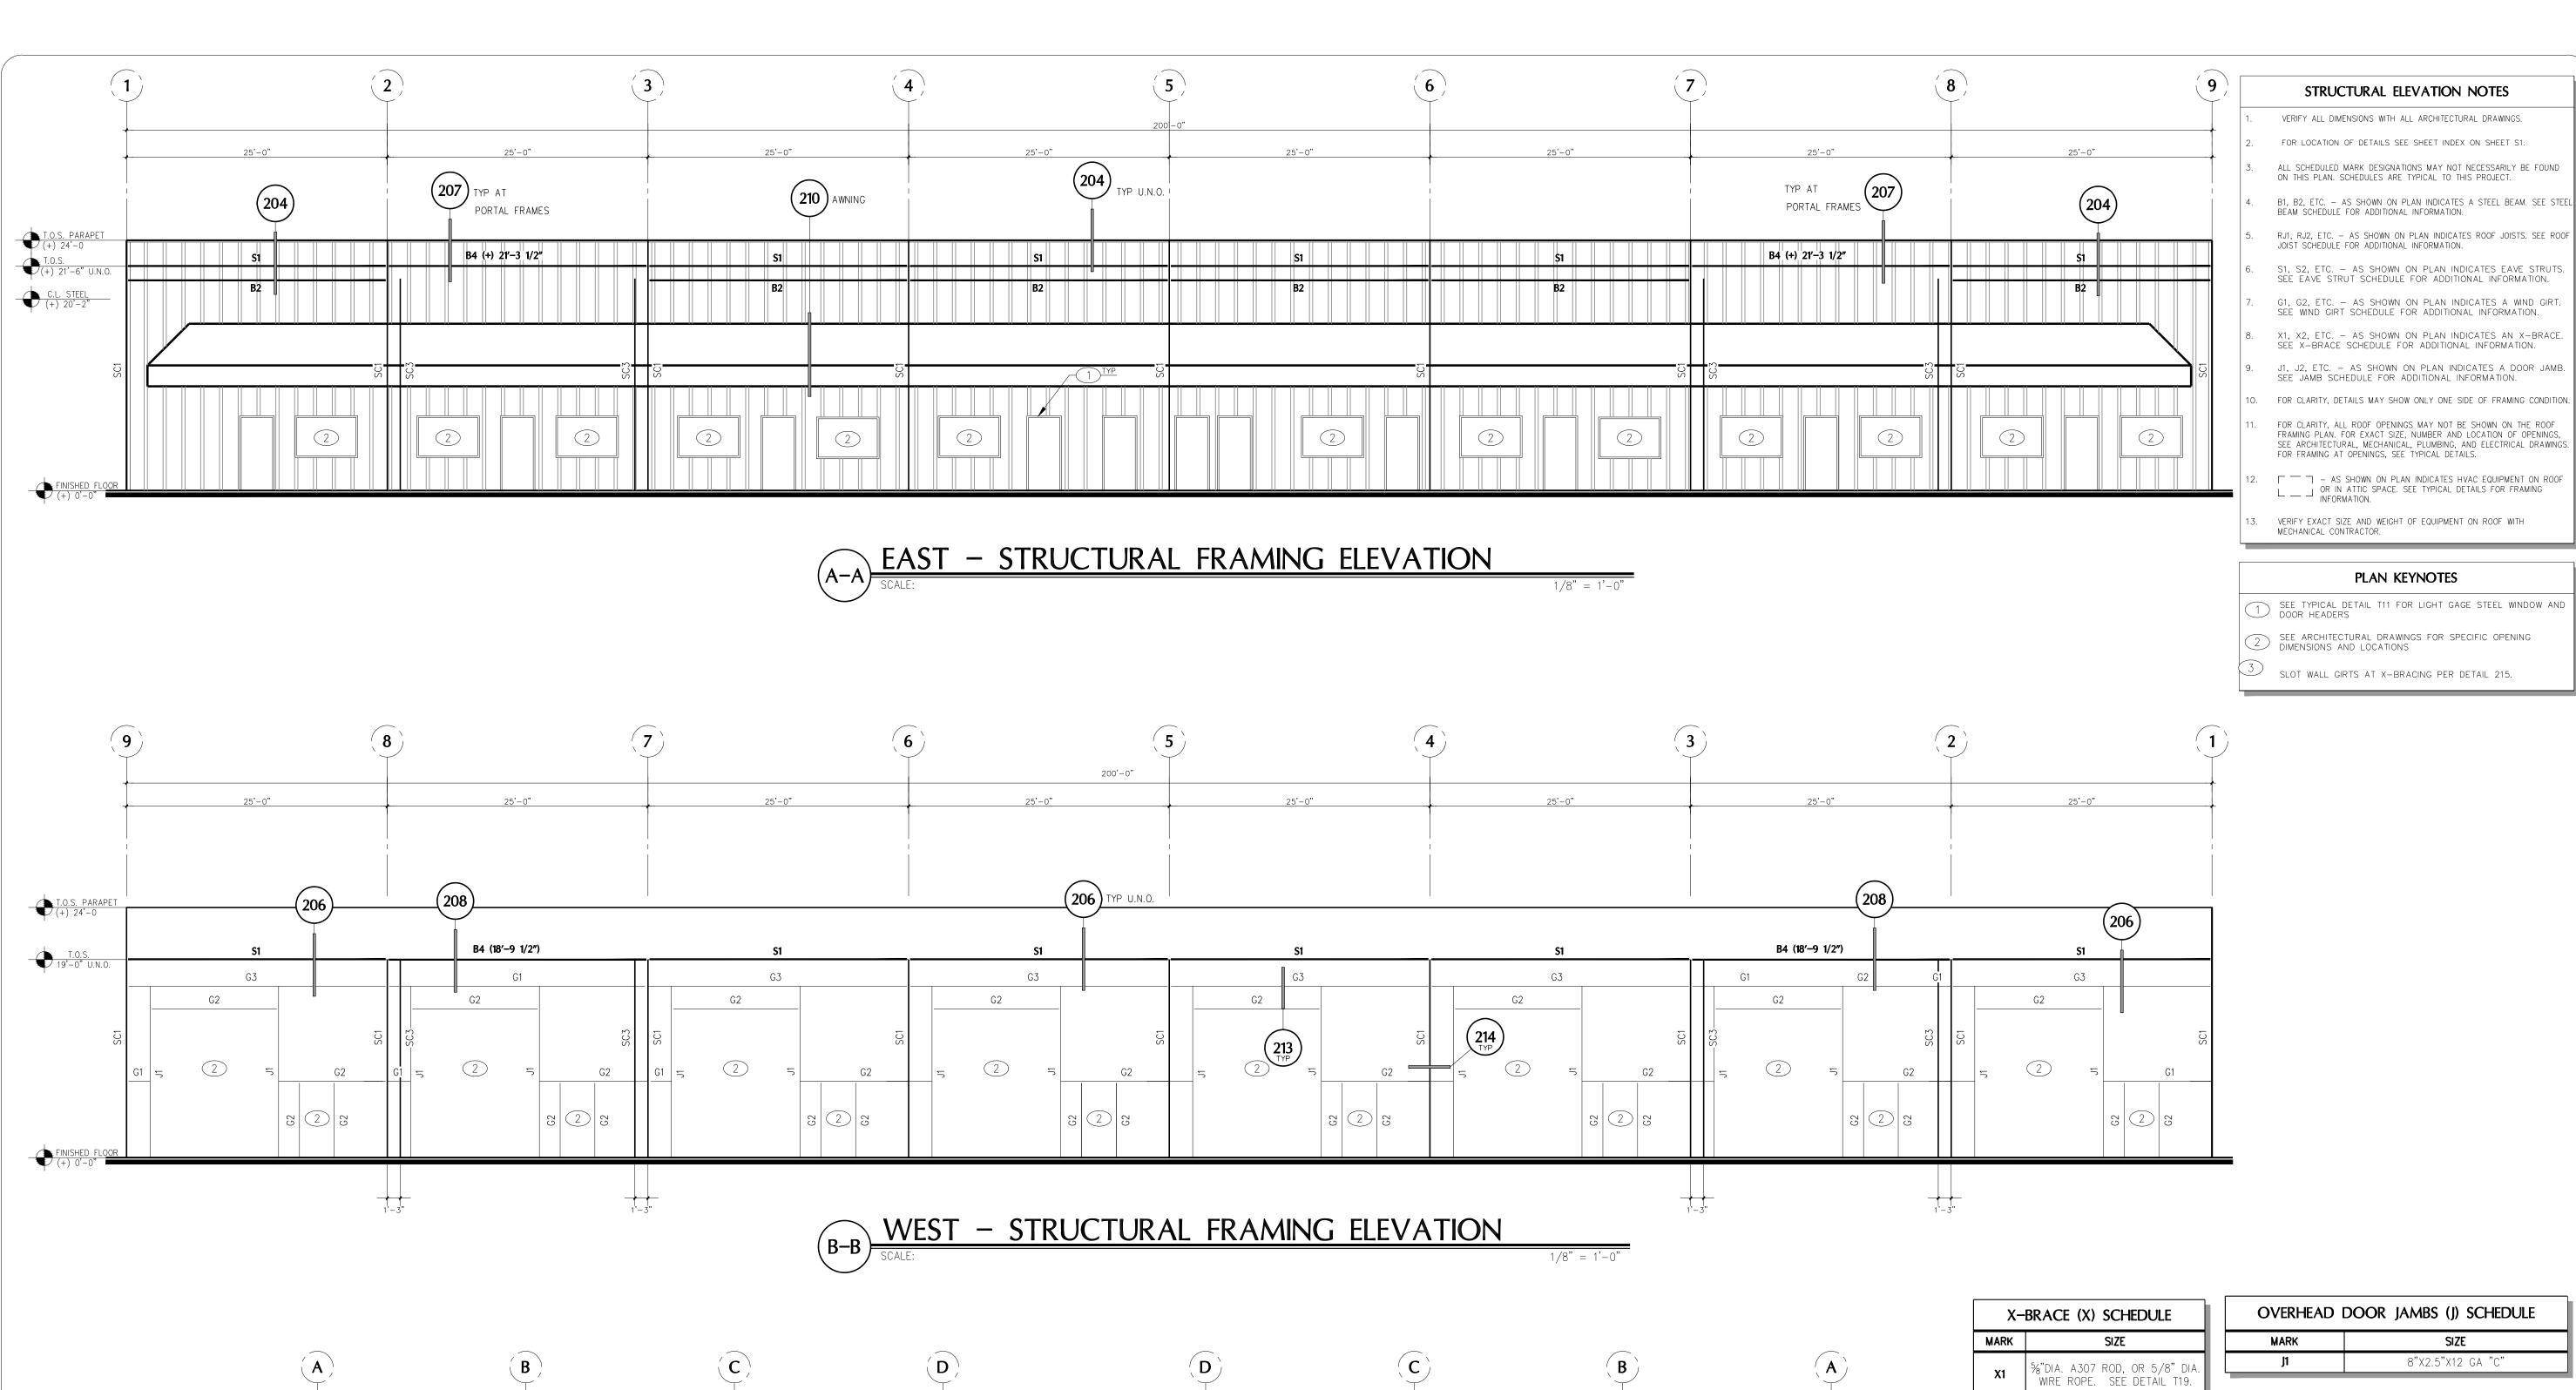

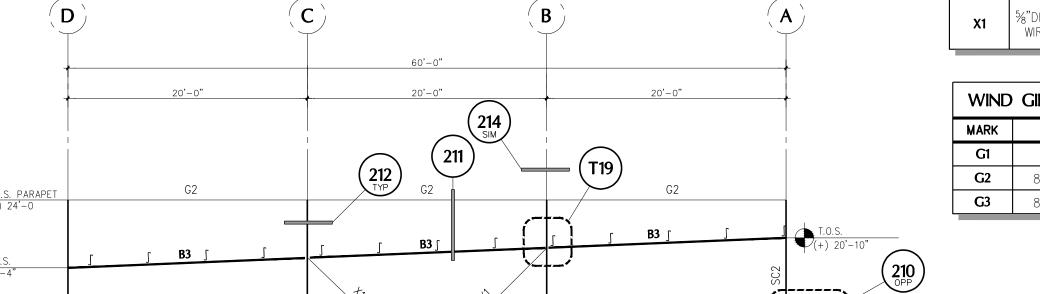

RT (G) SCHEDULE	STEEL BEAM (B) SCHEDULE						
SIZE	MARK	SIZE	CAMBER				
8"X2.5"X14 GA. 'Z'	B1	W24X62	STANDARD				
" X 2.5" X 14 GA. 'C'	B2	W8X18	STANDARD				
" X 2.5" X 12 GA. 'C'	В3	W12X19	STANDARD				
	B4	W16X40					

B4	W16X40	
	EAVE STRUT (S) SCHEDU	LE
MARK	SIZE	
S1	8"x5"x5", 14GA.	

8"X2.5"X12 GA "C

This drawing is the property of FROST Structural Engineering, Inc. Legally, the drawing can NOT be copied in whole or in pieces. It is only to be used for the project and site specifically identified hereon and is not to be used on any other project. Contractor shall carefully review all dimensions, details, and conditions and report at once any error, inconsistency or omission discovered before construction. The contractor assumes full liability for deviations from the intent of these plans.

FROST STRUCTURAL ENGINEERING

1678 Oaklawn Drive, Suite C Prescott, Arizona 86305 phone: 928.776.4757 info@frost-structural.com www.frost-structural.com

C-C SOUTH - STRUCTURAL FRAMING ELEVATION

SCALE: 1/8" = 1'-0"

REVISIONS

These drawings are the property of W. Alan Kenson & Associates P.C., and may not be reproduced in any way without the written consent of W. Alan Kenson & Associates, P.C.



SSOCi

SEE TYPICAL DETAIL T11 FOR LIGHT GAGE STEEL WINDOW AND DOOR HEADERS

DRAWN BY IMC CHECKED BY **RKF** DATE 6/17/24


2024-076


210

2 8

D-D NORTH - STRUCTURAL FRAMING ELEVATION

SCALE:

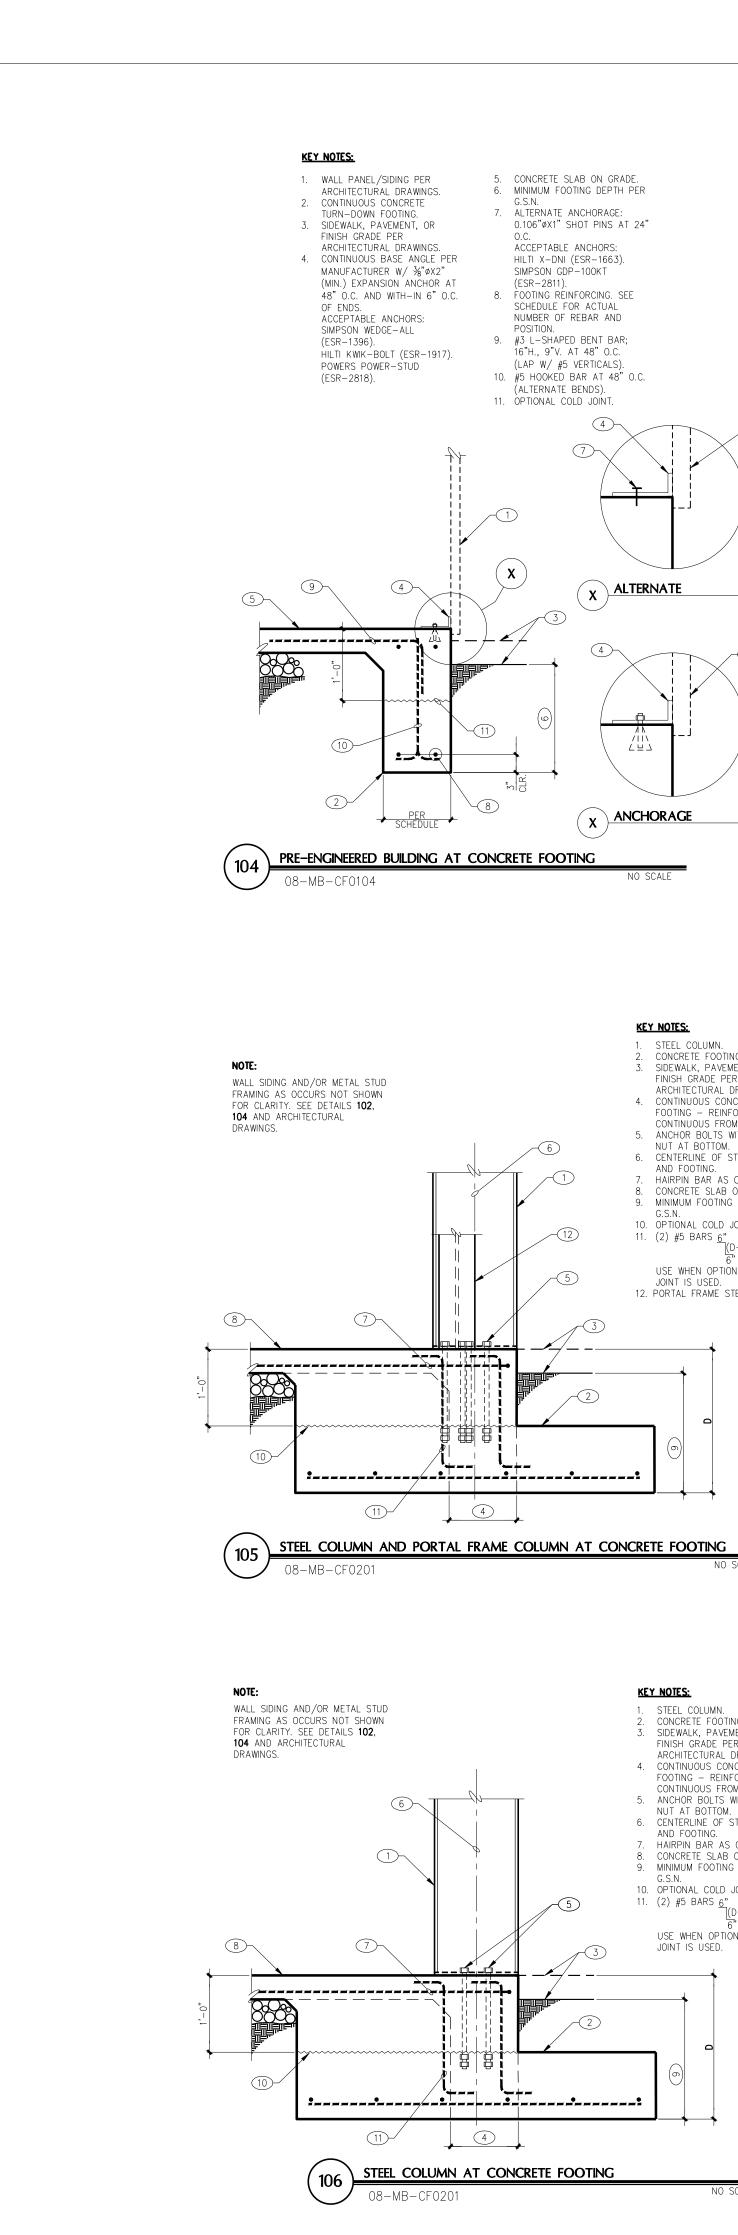

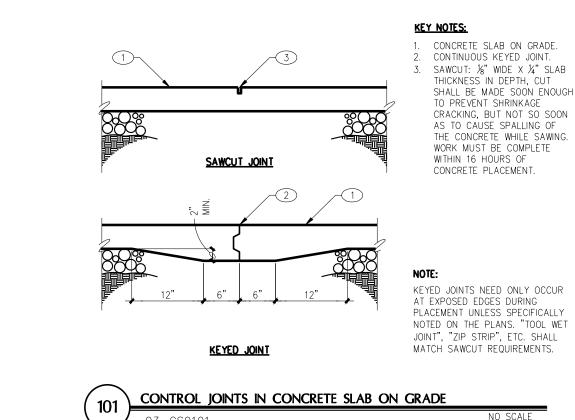

CONCRETE SLAB ON GRADE.
 MINIMUM FOOTING DEPTH PER

0.106"øX1" SHOT PINS AT 24"

G.S.N. 7. ALTERNATE ANCHORAGE:

ACCEPTABLE ANCHORS:

SIMPSON GDP-100KT (ESR-2811). 8. FOOTING REINFORCING. SEE

SCHEDULE FOR ACTUAL NUMBER OF REBAR AND

16"H., 9"V. AT 48" O.C.

(LAP W/ #5 VERTICALS).

10. #5 HOOKED BAR AT 48" O.C. (ALTERNATE BENDS).

X ALTERNATE

X ANCHORAGE

KEY NOTES: 1. STEEL COLUMN.

. SIDEWALK, PAVEMENT, OR

FINISH GRADE PER ARCHITECTURAL DRAWINGS.

CONTINUOUS FROM BEYOND. 5. ANCHOR BOLTS WITH DOUBLE NUT AT BOTTOM.

6. CENTERLINE OF STEEL COLUMN AND FOOTING.

7. HAIRPIN BAR AS OCCURS.

8. CONCRETE SLAB ON GRADE. 9. MINIMUM FOOTING DEPTH PER G.S.N.
10. OPTIONAL COLD JOINT.

""
""

11. (2) #5 BARS <u>6</u>" AT 16"

USE WHEN OPTIONAL COLD JOINT IS USED. 12. PORTAL FRAME STEEL COLUMN.

KEY NOTES:

STEEL COLUMN.
 CONCRETE FOOTING.

3. SIDEWALK, PAVEMENT, OR

ARCHITECTURAL DRAWINGS. 4. CONTINUOUS CONCRETE FOOTING — REINFORCING

CONTINUOUS FROM BEYOND. 5. ANCHOR BOLTS WITH DOUBLE NUT AT BOTTOM.

CENTERLINE OF STEEL COLUMN
 AND FOOTING.
 HAIRPIN BAR AS OCCURS.

9. MINIMUM FOOTING DEPTH PER

USE WHEN OPTIONAL COLD

10. OPTIONAL COLD JOINT. 11. (2) #5 BARS <u>6</u>" AT 16"

JOINT IS USED.

FINISH GRADE PER

4


4


4. CONTINUOUS CONCRETE FOOTING - REINFORCING

9. #3 L-SHAPED BENT BAR;

11. OPTIONAL COLD JOINT.

HILTI X-DNI (ESR-1663).

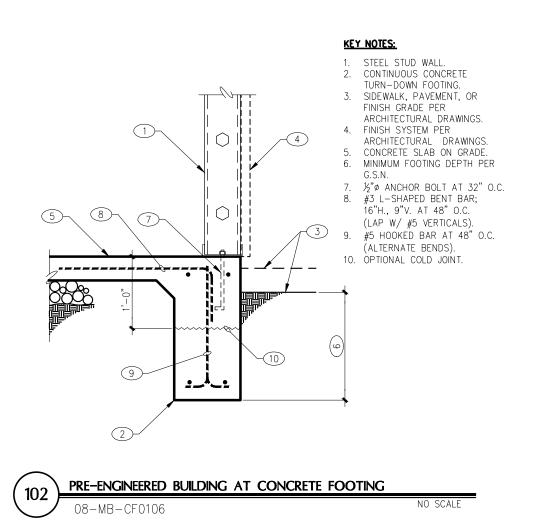

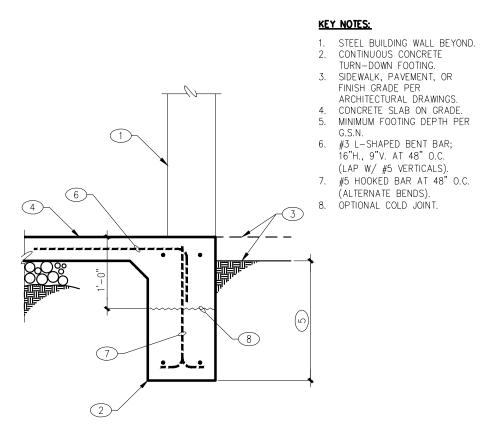



This drawing is the property of FROST Structural Engineering, Inc. Legally, the drawing can NOT be copied in whole or in pieces. It is only to be used for the project and site specifically identified hereon and is not to be used on any other project. Contractor shall carefully review all dimensions, details, and conditions and report at once any error, inconsistency or omission discovered before construction. The contractor assumes full liability for deviations from the intent of these plans. JOB NO.: 2024-076 PROJECT MANAGER: RKF CAD OPERATOR: IMC

FROST STRUCTURAL ENGINEERING

1678 Oaklawn Drive, Suite C phone: 928.776.4757 Prescott, Arizona 86305 info@frost-structural.com www.frost-structural.com

2024-076 SHEET

JOB NO.

တ

REVISIONS

These drawings are the property of

W. Alan Kenson & Associates P.C.,

and may not be reproduced in any

way without the written consent of


W. Alan Kenson & Associates, P.C.

ates

SSOCi


tracting Bui r Cal Way AZ 86301

DRAWING: DRAWN BY IMC CHECKED BY RKF 6/17/24

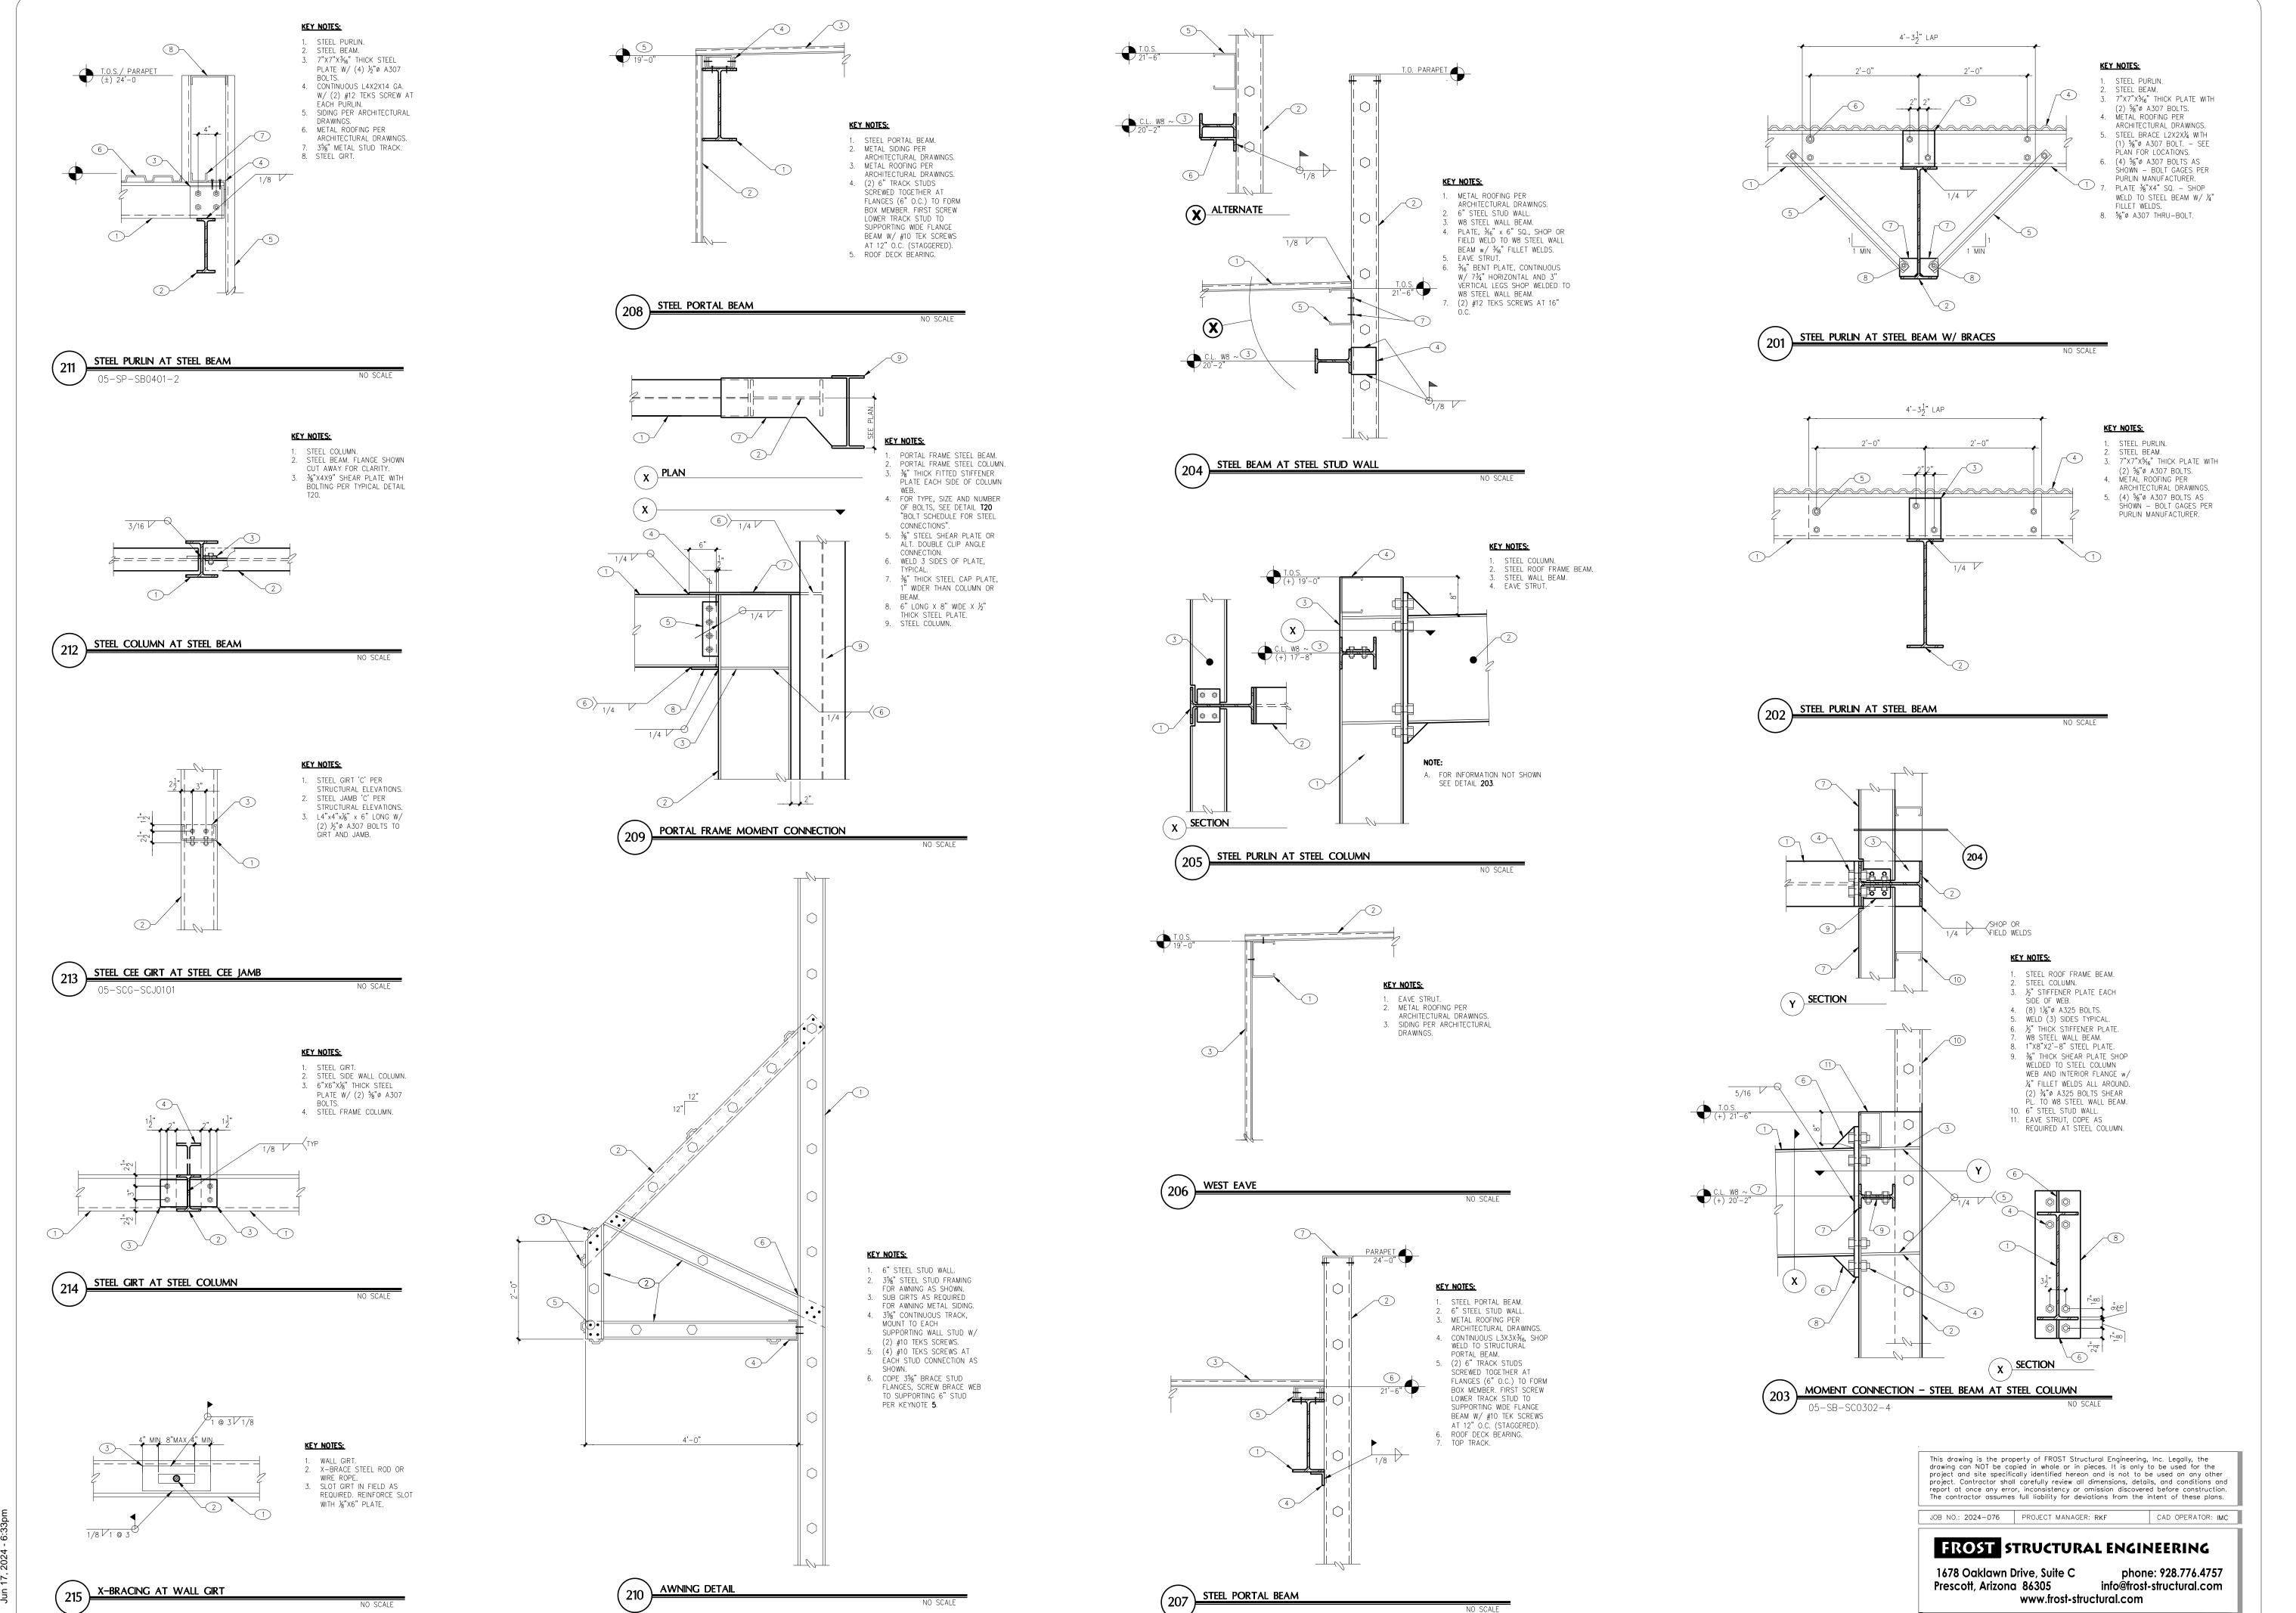

REVISIONS


These drawings are the property of W. Alan Kenson & Associates P.C. and may not be reproduced in any

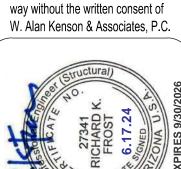

ssociates

DRAWN BY IMC CHECKED BY RKF 6/17/24 JOB NO. 2024-076

DR

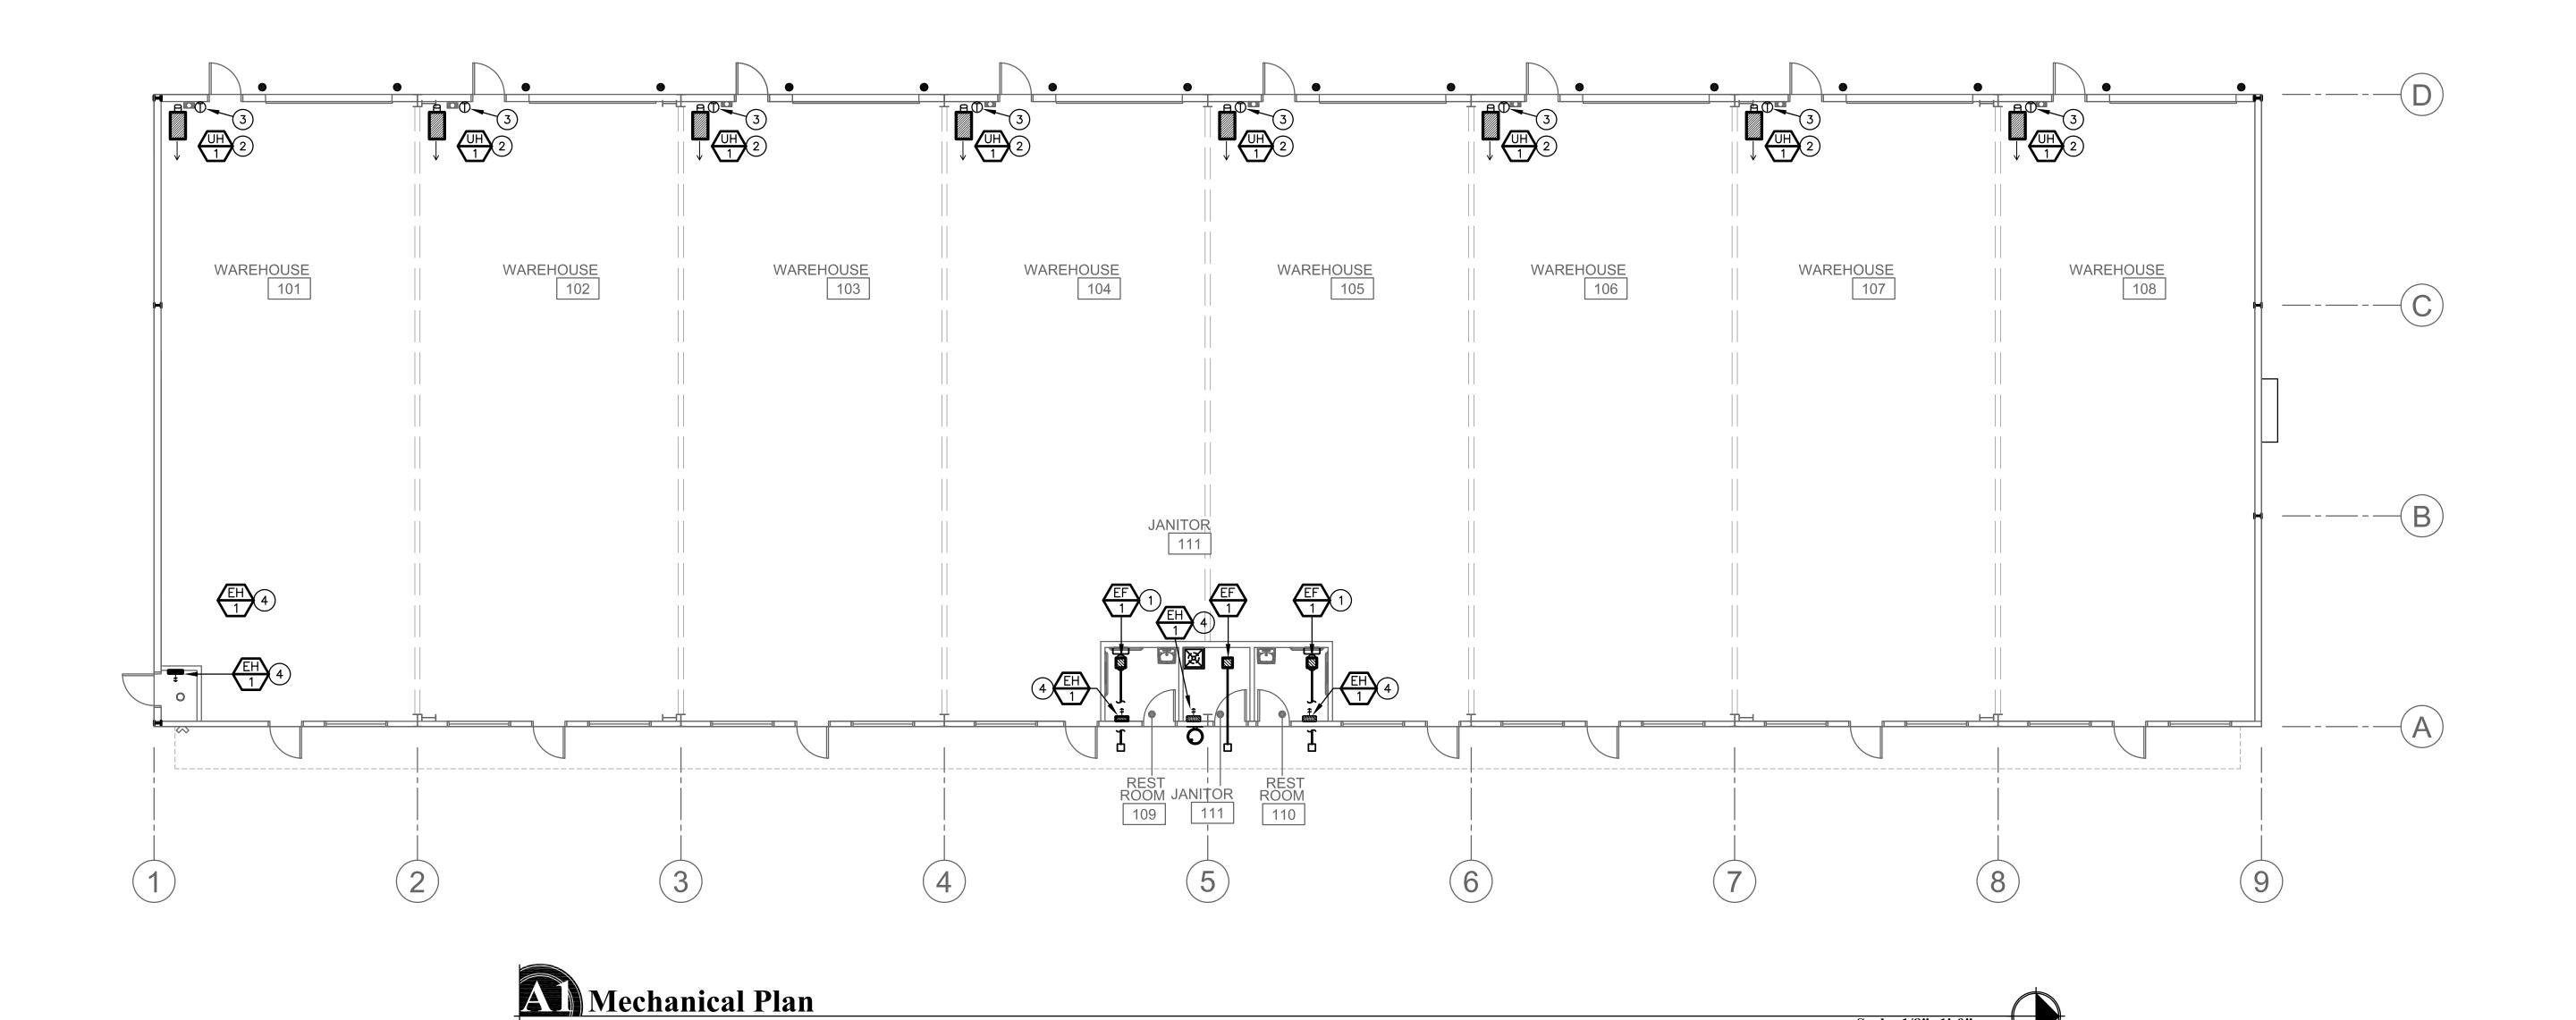

KEYNOTES


1 CEILING MOUNTED EXHAUST FAN WITH BACKDRAFT DAMPER. TRANSITION EXHAUST DUCT FROM UNIT DISCHARGE AND ROUTE TO MANUFACTURER'S SOFFIT DISCHARGE. MAINTAIN A MINIMUM 10' CLEARANCE FROM ALL OUTSIDE AIR INTAKES.

- GAS-FIRED UNIT HEATER SUPPORTED FROM STRUCTURE, WITH TYPE "B" FLUE UP THROUGH ROOF. COORDINATE UNIT HEATER MOUNTING HEIGHT.
- 3 PROVIDE UNIT HEATER WITH LOW VOLTAGE THERMOSTAT WITH INSULATED SUB-BASE.
- 4) ELECTRIC HEATER WITH INTEGRAL THERMOSTAT.



REVISIONS

These drawings are the property of W. Alan Kenson & Associates P.C., and may not be reproduced in any way without the written consent of W. Alan Kenson & Associates, P.C.

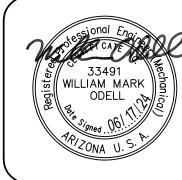

ssociates,

PROJECT:

DRAWN BY CHECKED BY

DATE March 6th, 2024 **JOB NO.** 799

MECHANICAL SPECIFICATIONS

DRAWINGS ARE GENERALLY DIAGRAMMATIC AND ARE INTENDED TO CONVEY SCOPE OF WORK AND TO INDICATE GENERAL ARRANGEMENT OF EQUIPMENT. THEY ARE NOT INTENDED TO SHOW EVERY OFFSET OR FITTINGS OR EVERY STRUCTURAL DIFFICULTY THAT MAY BE ENCOUNTERED DURING INSTALLATION OF THE WORK. LOCATION OF ALL ITEMS NOT DEFINITELY FIXED BY DIMENSIONS ARE APPROXIMATE ONLY. EXACT LOCATIONS NECESSARY TO SECURE BEST CONDITIONS AND RESULTS MUST BE DETERMINED AT PROJECT AND SHALL HAVE APPROVAL OF ARCHITECT BEFORE BEING INSTALLED. DO NOT SCALE DRAWINGS. IF SO DIRECTED BY ARCHITECT, WITHOUT EXTRA CHARGE, MAKE REASONABLE MODIFICATIONS IN LAYOUT AS NEEDED TO PREVENT CONFLICT WITH WORK OF OTHER TRADES OR FOR PROPER EXECUTION OF WORK. INCLUDE MINOR DETAILS NOT USUALLY SHOWN OR SPECIFIED, BUT NECESSARY FOR PROPER INSTALLATION AND OPERATION

CODES INCLUDE IN WORK, WITHOUT EXTRA COST TO OWNER, LABOR, MATERIALS, SERVICES, APPARATUS, DRAWINGS (IN ADDITION TO CONTRACT DRAWINGS AND DOCUMENTS) REQUIRED TO COMPLY WITH APPLICABLE LAWS, ORDINANCES, RULES AND REGULATIONS. DRAWINGS AND SPECIFICATIONS TAKE PRECEDENCE WHEN THEY ARE MORE STRINGENT THAN CODES, ORDINANCES, STANDARDS AND STATUTES. CODES, ORDINANCES, STANDARDS AND STATUES TAKE PRECEDENCE WHEN THEY ARE MORE STRINGENT OR CONFLICT WITH DRAWINGS OR SPECIFICATIONS. FOLLOWING INDUSTRY STANDARDS, SPECIFICATIONS AND CODES ARE MINIMUM REQUIREMENTS:

OF A SYSTEM OR PIECE OF EQUIPMENT.

A. APPLICABLE CITY, COUNTY, AND STATE MECHANICAL, ELECTRICAL, GAS, PLUMBING, HEALTH AND SANITARY CODES, LAWS AND ORDINANCES.

B. UNDERWRITER'S LABORATORIES, INC. STANDARDS. C. 2018 INTERNATIONAL RESIDENTIAL CODE WITH LOCAL AMENDMENTS. D 2018 INTERNATIONAL PLUMBING CODE WITH STATE

AMENDMENTS. E. 2018 INTERNATIONAL MECHANICAL CODE WITH STATE AMENDMENTS.

F. 2017 NEC G. 2018 INTERNATIONAL FUEL GAS CODE WITH STATE AMENDMENTS.

GENERAL
THE WORK INCLUDED UNDER THIS SECTION CONSISTS OF FURNISHING ALL LABOR, MATERIALS, AND EQUIPMENT TO PROVIDE A COMPLETE FUNCTIONING HVAC SYSTEM AS SHOWN ON THE DRAWINGS AND SPECIFIED HEREIN. THE SYSTEM SHALL INCLUDE REQUIRED UNITS, DUCTWORK, FANS AND ALL APPURTENANCES AS REQUIRED. INSTALL MATERIAL AND EQUIPMENT IN ACCORDANCE WITH MANUFACTURER'S RECOMMENDATIONS.

INSTRUCT THE OWNER AS TO PROPER OPERATION AND CARE OF THE EQUIPMENT AFTER START-UP AND CHECK-OUT. PROVIDE THE OWNER WITH ALL WARRANTY AND OPERATING INSTRUCTIONS AT THE COMPLETION OF THE PROJECT.

EACH COMPLETE SYSTEM GUARANTEED BY CONTRACTOR FOR A PERIOD OF ONE YEAR, FROM DATE OF ACCEPTANCE OF WORK BY OWNER IN WRITING, TO BE FREE OF DEFECTS OF MATERIALS AND WORKMANSHIP, AND TO PERFORM SATISFACTORILY UNDER ALL CONDITIONS OF LOAD OR SERVICE. THE GUARANTEES PROVIDE THAT ANY ADDITIONAL CONTROLS, PROTECTIVE DEVICES, OR EQUIPMENT BE PROVIDED AS NECESSARY TO MAKE THE SYSTEM OF EQUIPMENT OPERATE SATISFACTORILY, AND THAT ANY FAULTY MATERIALS OR WORKMANSHIP BE REPLACED OR REPAIRED.

REGULATIONS, PERMITS & INSPECTIONS COMPLY WITH ALL APPLICABLE CODES, RULES AND REGULATIONS. ALL MATERIALS, EQUIPMENT AND WORK MUST CONFORM TO THE INTERNATIONAL RESIDENTIAL CODE. OBTAIN AND PAY FOR ALL REQUIRED PERMITS AND LICENSES. WHEN REQUIRED BY CODE, ALL WORK MUST BE INSPECTED AND APPROVED BY LOCAL

<u>DUCTWORK</u>
ALL DUCTWORK TO BE GALVANIZED LOCK FORMING SHEET METAL. SIZES SHOWN ARE CLEAR INSIDE DIMENSIONS. CONSTRUCT ALL DUCTWORK AND FITTINGS TO PROVIDE MINIMUM RESISTANCE AND NOISE LEVELS. DUCTWORK SHALL BE FABRICATED AND INSTALLED BY SKILLED MECHANICS IN A WORKMANLIKE MANNER USING THE LATEST EDITION OF THE "SMACNA" MANUAL AS A GUIDELINE. SEAL ALL SUPPLY AIR DUCTWORK AND RETURN AIR PLATFORMS/PLENUMS AIRTIGHT WITH APPROVED DUCT SEALER. TURNING VANES SHALL BE INSTALLED IN ALL MITERED ELBOWS.

ACCEPTABLE MANUFACTURERS ARE TITUS, ANEMOSTAT, KRUEGER. CARNES, BARBERCOMAN, AGITAIR, E.A.P.C., METAL—AIR OR HART AND COOLEY. CONFIRM FINISHED AND COLOR WITH ARCHITECT. ALL GRILLES AND DIFFUSERS SHALL BE SUBMITTED TO ARCHITECT FOR FINAL APPROVAL.

FURNISH AND INSTALL EXHAUST FANS AS REQUIRED BY ARCHITECTURAL DRAWINGS. PROVIDE FANS WITH FACTORY ROOF OR WALL CAPS AS SHOWN. PROVIDE ALL EXHAUST FANS WITH BACKDRAFT DAMPER. MAXIMUM NOISE RATING 4.0 SONES. ACCEPTABLE MANUFACTURER'S ARE "BROAN", "NUTONE" OR "GREENHECK" OR AS APPROVED BY ARCHITECT.

INSTRUCTIONS/O&M MANUAL

THE CONTRACTOR SHALL INSTRUCT THE OWNER IN THE PROPER OPERATION AND MAINTENANCE OF ALL INSTALLED HVAC EQUIPMENT. THE CONTRACTOR SHALL PROVIDE A MINIMUM OF TWO (2) BOUND OPERATING AND MAINTENANCE MANUALS TO THE OWNER AT THE COMPLETION OF THE PROJECT. THE MANUAL SHALL INCLUDE: CONTROL AND OR INTERLOCK WIRING DIAGRAMS, SEQUENCE OF OPERATION, PREVENTATIVE MAINTENANCE ITEMS, AND A PARTS LIST WITH THE NOMENCLATURE, MAINTENANCE SCHEDULE, AND NAME, ADDRESS AND PHONE NUMBER OF THE LOCAL PRODUCT

UNIT HEATER SCHEDULE

)														
FOLIID			ı	BLOWER	1	МО	TOR		HEATER					
EQUIP. NO.	MANUFACTURER	MODEL NO.	CFM	ESP	MIN. THROW	HP	VOLTS/ PHASE	FUEL	EFF.	MAX. INPUT MBH	MIN. OUTPUT MBH	FLUE (DIA.)	WT. (LBS)	REMARKS
1	REZNOR	UDX-75	961	0	×	0.06	120/1	NAT. GAS	83%	60,000	49,800	4" RD	76	(1) (2) (3) (4)

(1) PROVIDE UNIT HEATER WITH LOW VOLTAGE THERMOSTAT WITH INSULATED SUB-BASE, W/ LOCKING COVER.


(2) PROVIDE UNIT WITH ELECTRONIC SPARK IGNITION.

3 PROVIDE UNIT WITH OPTIONAL HANGER KIT.

(4) INPUT RATINGS SHOWN HAVE BEEN DERATED FOR 5,000 FT ELEVATION. INPUT RATE CHANGES FROM STANDARD CAN BE MADE BY ADJUSTING MANIFOLD PRESSURE (MIN 3.0 - MAX 3.7) OR BY CHANGING ORIFICE.


(EF)	EXHAU	ST FAI	N SCHED	ULE							
MADK	SERVES		MODEL	СҒМ		MOTOR		DDIVE	SONES	WEIGHT	DEMARKS
MARK	SERVES	MANUF.	MODEL			HP OR WATTS	V/PH	DRIVE	SONES	WEIGHT LBS	REMARKS
1	RESTROOM	GREENHECK	SP-B90	75	.125	54 WATTS	120/1	DIRECT	2.0	10	12
(1) UNIT TO	O OPERATE VIA WALL	SWITCH.	2 PROVIDE #EL-10	0x3 SOFFI	T DISCHAR	GE PER PLANS					

				HEDUL		T	<u> </u>	ı	T
EQUIP. NO.	MANUFACTURER	MODEL NO.	TYPE	SERVICE/ LOCATION	BLOWER CFM	HEATER KW	VOLTS/ PHASE	AMPS	REMARK
1	QMARK	GFR1500F	WALL HEATER	RISER ROOM	150	0.50	120/1	12.5	(1)(2)

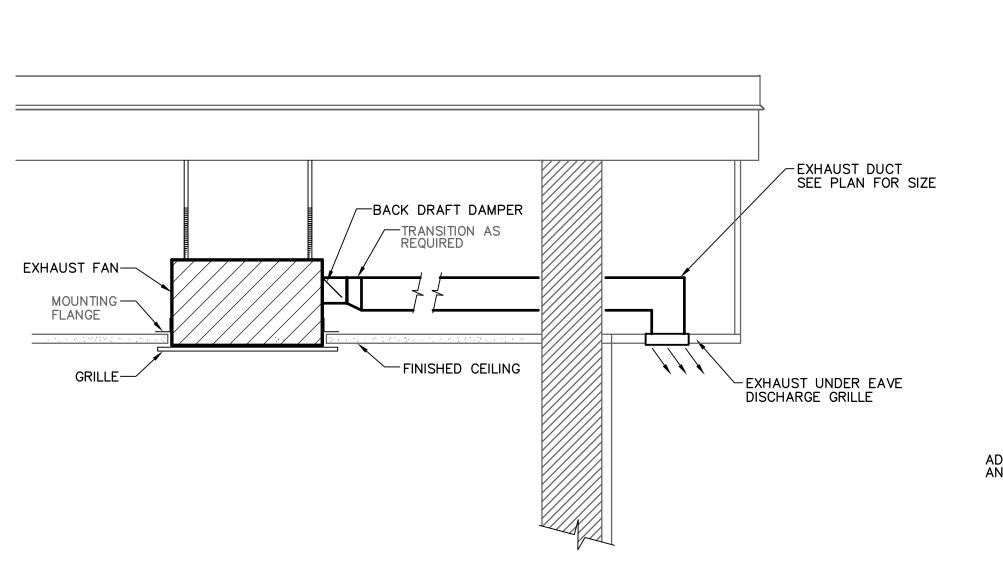

CEILING EXHAUST FAN DETAIL




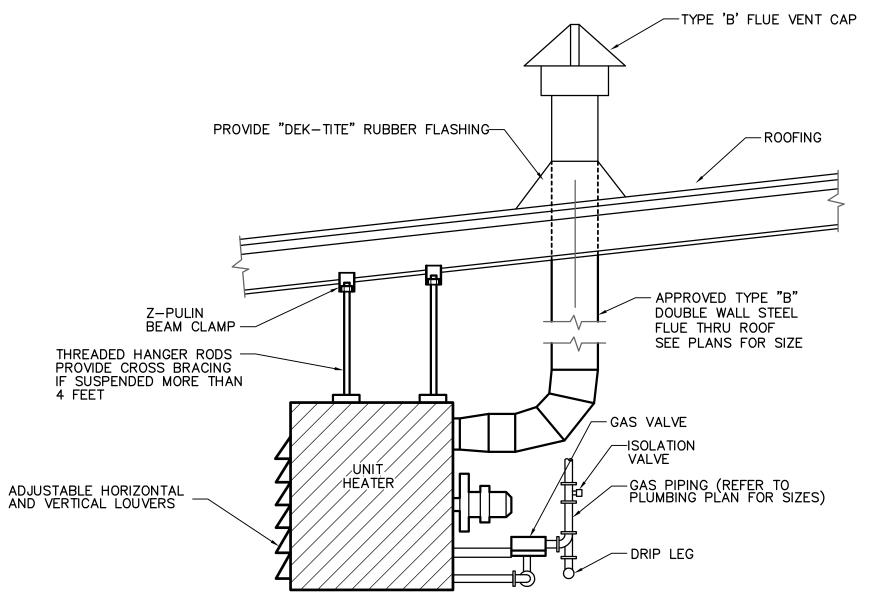

GAS FIRED UNIT HEATER

Consulting Engineers REVISIONS

These drawings are the property of W. Alan Kenson & Associates P.C., and may not be reproduced in any way without the written consent of W. Alan Kenson & Associates, P.C.

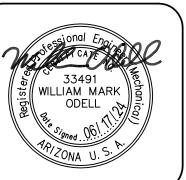

()


()

()

(

PROJEC

DRAWN BY CHECKED BY **DATE** March 6th, 2024 **JOB NO.** 799 SHEET

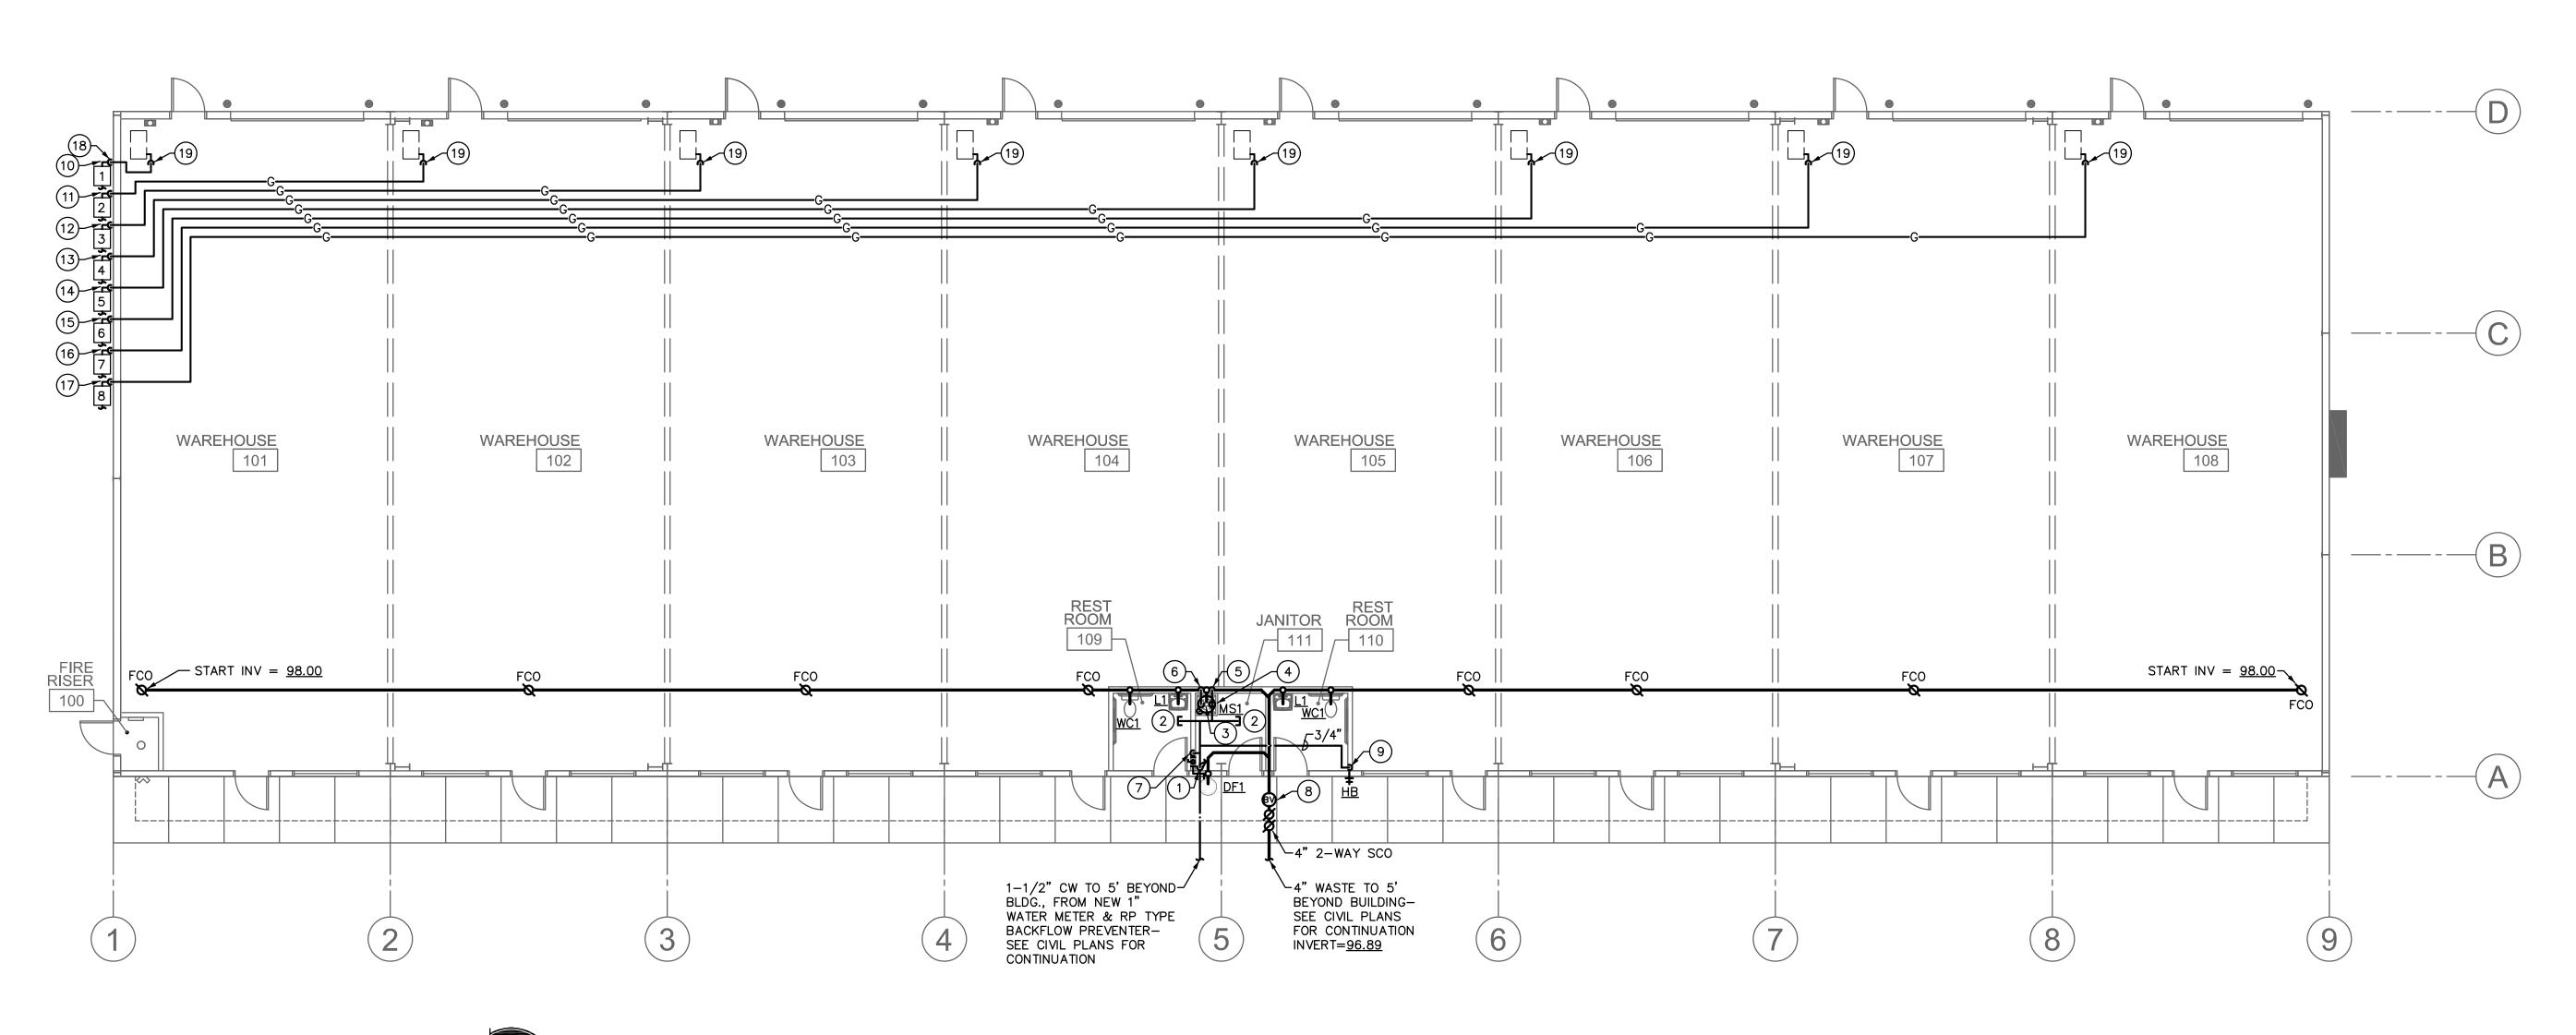

NOTE: SLOPE ALL HORIZONTAL WASTE PIPING AS FOLLOWS:

FOR PIPE SIZES UP THROUGH 3", SLOPE AT 1/4" PER FT. FOR PIPE SIZES 4" & ABOVE,


SLOPE AT 1/8" PER FT.

Plumbing Plan

KEYNOTES:

- 1-1/2" CW RISE FROM BELOW GRADE TO ROUTE AT CEILING. PROVIDE BALL VALVE (BUILDING SHUTOFF) ON RISER AT +6" A.F.F.; PROVIDE PRESSURE REDUCING VALVE (PRV) SET AT 80 PSI ON RISER AT +12" A.F.F.
- 2 PROVIDE 1-1/4" CAPPED CW LINE ABOVE CEILING FOR FUTURE TENANT IMPROVEMENTS.
- 3 3/4" H & CW DOWN TO WATER HEATER.
- ELECTRIC WATER HEATER MOUNTED ON SHELF ABOVE MOP SINK- SEE DETAIL & SCHEDULE, SHEET P2.0. PROVIDE FULL SIZE P & T RELIEF DRAIN LINE, TERMINATE AT +2" ABOVE MOP SINK RIM WITH 90° ELBOW DOWN.
- 1" CW DOWN TO 1" HEADER, WITH 1/2" TO MOP SINK, 1/2" TO EACH LAV & 1/2" TO EACH WC.
- 6 3/4" HW DOWN TO 3/4" HEADER, WITH 1/2" TO MOP SINK & 1/2" TO EACH LAV.
- 7 1/2" CW DOWN TO DRAIN-DOWN SYSTEM IN WALL WITH ACCESS PANEL, WITH 1/2" CW OUT OF DRAIN-DOWN TO DRINKING FOUNTAIN. SEE DETAIL, THIS SHEET.
- PROVIDE BACKWATER VALVE TO COMPLY WITH CITY OF PRESCOTT REQUIREMENTS. PROVIDE TRAFFIC RATED COVER.
- 9 3/4" CW DOWN TO NON FREEZE HOSE BIBB.
- GAS METER #1 BY GAS CO. (60 CFH, 24' TOTAL DEV. LENGTH. SERVES SPACE 101. SEE 1/P3.2 FOR DIAGRAM.
- GAS METER #2 BY GAS CO. (60 CFH, 48' TOTAL DEV. LENGTH. SERVES SPACE 102. SEE 2/P3.2 FOR DIAGRAM.

- GAS METER #3 BY GAS CO. (60 CFH, 76' TOTAL DEV. LENGTH. SERVES SPACE 103. SEE 3/P3.2 FOR DIAGRAM.
- GAS METER #4 BY GAS CO. (60 CFH, 104' TOTAL DEV. LENGTH. SERVES SPACE 104. SEE 4/P3.2 FOR DIAGRAM.
- GAS METER #5 BY GAS CO. (60 CFH, 132'
 TOTAL DEV. LENGTH. SERVES SPACE 105. SEE
 5/P3.2 FOR DIAGRAM.
- GAS METER #6 BY GAS CO. (60 CFH, 160' TOTAL DEV. LENGTH. SERVES SPACE 106. SEE 6/P3.2 FOR DIAGRAM.
- GAS METER #7 BY GAS CO. (60 CFH, 188' TOTAL DEV. LENGTH. SERVES SPACE 107. SEE 7/P3.2 FOR DIAGRAM.
- GAS METER #8 BY GAS CO. (60 CFH, 216' TOTAL DEV. LENGTH. SERVES SPACE 108. SEE 8/P3.2 FOR DIAGRAM.
- (18) GAS OUT OF METER, RISE ALONG EXTERIOR WALL TO ENTER BUILDING AT CEILING (TYPICAL
- (19) GAS DOWN TO VALVED CONNECTION TO UNIT HEATER. PROVIDE LUB. GAS COCK & 5" DIRT LEG AT UNIT CONNECTION.

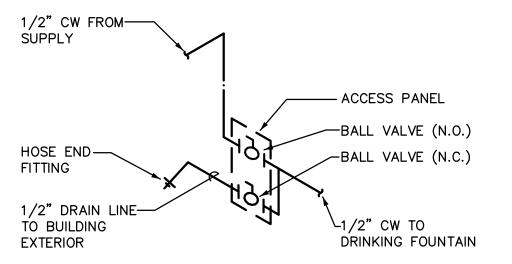

DRAIN DOWN SYSTEM DETAIL FOR DRINKING FOUNTAIN

- SEE WASTE & VENT SCHEMATICS, SHEET P3.0 FOR COMPLETE WASTE & VENT PIPE SIZING. SEE GAS PIPING DIAGRAMS, SHEET P3.0 FOR COMPLETE GAS PIPE SIZING.
- PLUMBING NOTES:
- 1. WATER PIPING LOCATED IN EXTERIOR WALLS SHALL BE INSTALLED ON THE BUILDING INTERIOR SIDE OF THE BLDG. INSULATION.
- 2. EXTERIOR WATER PIPING SHALL BE INSTALLED BELOW FROST LINE.

PLUI	MBIN	G LEGEND				
SYMBOL	ABBR.	DESCRIPTION				
	W	DRAIN OR WASTE PIPING				
	٧	VENT PIPING				
·	CW	COLD WATER PIPING				
	HW	HOT WATER PIPING				
<u>— G—</u>	G	NATURAL GAS PIPING BALL VALVE				
ιδι	BV					
Ø	FCO	FLOOR CLEANOUT				
Ø	SCO	SURFACE CLEANOUT				
 —i	WCO	WALL CLEANOUT				
ال	VTR	VENT THRU ROOF				

0	S	E
<u>Design</u> consulti	Grou	p, LLC
Consultí	ng E	ngineers
611 West Delano Ave Prescott, AZ 86301 (602) 499.0001	<u>Project</u> #24027	10922 N. 153rd Ln. Surprise, AZ 85379 (623) 444-6143

REVISIONS

These drawings are the property of W. Alan Kenson & Associates P.C., and may not be reproduced in any way without the written consent of

W. Alan Kenson & Associates, P.C. WILLIAM MARK

SSOC

PRO.

DRAWN BY CHECKED BY DATE March 6th, 2024 JOB NO. 799 SHEET

- GENERAL
- 1..1 Scope: Work under this section includes coordinating and furnishing all labor and material necessary to install a complete plumbing system as shown and specified and in accordance with the codes. Contractor shall pay for all permits, meters, fees, city inspections, legal notices, etc.,
- 1...2 Submittals: Within 15 days after award of contract, submit 8 copies of all items.
- 1..3 Record Drawings: Provide a set to the Architect at completion of project.
- 1..4 Instructions: Provide maintenance manual and instruct Owner in the proper operation and maintenance of the equipment.
- 1..5 Guarantee: One year on labor, material and equipment.
- PRODUCTS
- 2..1 Piping:
- 2..1.1 Water Lines:
- 2..1.1.1 Copper: Type "L" hard drawn, conforming to ASTM B88, for all water pipe not set under concrete or in the ground.
- 2..1.1.2 Copper: Type "K" soft drawn, conforming to ASTM B88, for water pipe set in or under concrete or in the ground. Wrap lines below concrete floors with 20 mils of polykon tape.
- 2..1.1.3 Fittings: Wrought copper conforming to ANSI B16.22.
- 2..1.1.4 Plastic: If permitted by Administrative Authority, IAPMO approved, NSF-61 listed, crosslinked polyethylene (PEX) tubing, equal to Wirsbo "AQUAPEX" system is acceptable for potable water piping.
- 2..1.2 Sanitary Waste and Vent Lines:
- 2..1.2.1 Cast Iron conforming to CISPI Standard 301-95 and ASTM A-888 for all no-hub pipe and fittings installed above and below grade.
- 2..1.2.2 Galvanized Iron: Standard weight, Schedule 40 galvanized iron conforming to ASTM A-120 for all vent lines 2-1/2" or smaller.
- 2..1.2.3 Fittings (Waste and Vent System, no-hub cast iron): No-hub cast iron drainage pattern fittings conforming to CISPI #301-95.
- 2..1.2.4 Fittings (Waste and Vent, galvanized steel): Threaded cast iron fittings conforming to ANSI B16.4.
- 2..1.2.5 Couplings (Waste and Vent, above and below grade): Double band, stainless steel couplings conforming to CISPI 310-95, with neoprene gasket conforming to ASTM Standard
- C564 (NOTE: Screened stainless shield is not approved). 2..1.2.6 Plastic: Subject to Owner approval, PVC piping conforming to ASTM D-2665-88 is acceptable for sanitary waste piping installed below grade or slab. Fittings: Drainage fittings
- 2..1.3 Gas Piping:

to match pipe.

- 2..1.3.1 Gas Piping, interior above slab: Schedule 40 black steel conforming to ASTM A53. Fittings shall conform to the following:
- 2..1.3.1.1 Pipe 1-1/2" and Smaller: 150 psi, black malleable iron, conforming to ANSI B16.3, 150
- 2..1.3.1.2 Pipe 2" and Larger: Black steel seamless welding fittings conforming to ANSI B16.9 and USAS B16.25, 150 psi SWP.
- 2..1.3.1.3 Unions: Black malleable iron screwed connections, ground iron-to-bronze seat, conforming to ASTM A47, 250 psi SWP.
- 2..1.3.1.4 Flanges: Black forged steel with weld neck flanges conforming to ANSI B16.5, 150 psi SWP. 2..1.3.2 Gas Piping, above grade or slab, exterior: Schedule 40 galvanized steel, conforming to ASTM A53. Fittings: 150# galvanized steel screwed fittings.
- 2..2 Pipe Hangers and Supports: Fee & Mason Figure 103 clevis hanger for insulated pipe and Figure 104 clevis hanger for cast iron pipe. Install #500 Trisolators on uninsulated copper lines at all hangers and wall penetrations.
- 2...3 Pipe Insulation: Use fiberglass premolded insulation with all—service jacket, minimum density of 3.5 pcf. Provide an additional 8-ounce canvas jacket with Arabol finish around all exposed pipe insulation. Cover fittings and valves (except unions) with insulation cement worked on in two lphapplications to a smooth, hard surface, flush with pipe covering. Provide 8" long, 20 gauge, galvanized iron metal insulation guards at locations of hanger rods and supports. Provide 12" long rigid insulation blocks on bottom half of pipe 1" and larger at hangers. Insulation wall thickness shall conform to the following schedule:
- Domestic Hot Water and Hot Water Recirculating Lines:
- Mains and horizontal branches 1" thickness. Drops in walls and partitions -1/2" thickness.
- 2..4.1 Gate Valves: Milwaukee 115, 125#, bronze body, solder type gate valve with nonrising stem for all lines up through 3" size.
- 2..4.2 Check Valves: Milwaukee #1509, 125#, bronze body, solder joint check valve with horizontal bronze disc for all valves up to 2" size. Milwaukee #F2974, 125#, iron body, bronze trimmed, flanged horizontal check valve for all valves larger than 2" size.
- 2..4.3 Shutoff Valve: Milwaukee BB1-350 bronze body, solder joint valve for all lines up through 2..4.4 Gas Valves, 3/4" and Smaller: Milwaukee BB-1-102.
- 2..4.5 Gas Valves, 1" to 1-1/2": Rockwell-Nordstrom #142 with #555 lubricant for natural gas
- 2..4.6 Gas Valves, 2" and Larger: Rockwell-Nordstrom #143 with #555 lubricant for natural gas service.
- 2...5 Cleanouts:
- 2..5.1 Concrete and Tile Floors: J.R. Smith 4023, with scoriated nickel-bronze top.
- 2..5.2 Cleanouts (exposed vertical piping): J.R. Smith 4512 cast iron branch cleanout tee with bronze plug.
- 2..5.3 Interior Finished Walls: J.R. Smith 4532.
- 2..5.4 Exterior Surface Cleanouts: J.R. Smith 4253. Provide 18" x 18" x 6" concrete pad at landscape areas; provide concrete ring below grade at asphalt areas.
- 2..5.5 Provide all cleanouts with heavy threaded bronze plugs.
- 2..6 Acceptable Manufacturers: The following is a list of manufacturers whose equipment is acceptable as to manufacturer, subject to conformance with all drawings, specifications and addenda items:
- Plumbing Fixtures: American Standard, Kohler, Eljer.
- Stainless Steel Sinks: Just, Elkay, Moen.
- Mop Sinks: Fiat, Swan, Mustee
- Electric Water Heaters: Rheem, A.O. Smith, American Mor-Flo.
- Valves: Crane, Kennedy, Stockham, Grinnell, Milwaukee, Wolverine.
- Hose Bibbs: Acorn, Chicago, Woodford.
- P-Traps: Crane. Kohler, Eljer, Frost, McGuire.
- Supply Fittings: Chicago, American Standard, Eljer, Speakman, Kohler.
- Supply Stops: Eastman, Kohler, Eljer, Brasscraft, McGuire.
- Closet Seats: Sperzel, Olsonite, Beneke, Bemis.
- Drains and Cleanouts: J. R. Smith, Zurn, Josam, Wade, Western.
- Hangers: Grinnell, Fee & Mason, Elcen, Kin-Line, F & S, B-Line, Michigan.

- 2.7 Plumbing Fixtures: Use polished chrome-plated, adjustable brass P-traps with wall escutcheons at all exposed locations. Use polished chrome-plated faucets with removable trim, brass body and brass handles. Fixtures and supply fitting shall be of one manufacturer. Provide diaphraam type, polished chromeplated flush valves with integral vacuum breakers and screwdriver stops. Provide fixture stops or valves ahead of all equipment or fixtures. After fixtures are set in place and secured to walls, caulk all around between fixtures and wall with either Dow Corning #780 or G.E. Construction Sealant white silicone caulking compound. See Plumbing Fixture Specification Schedule for complete fixture specifications.
- EXECUTION
- 3..1 Tests and Inspections:
- 3..1.1 All work to be tested and approved before covering as directed by Architect. Remake all
- 3..1.2 Water System: 125 psi hydrostatic pressure held for four hours.
- 3..1.3 Sanitary Waste and Vent System: Fill with water to highest point in the system and let
- 3..1.4 Gas System: Hold at 50 psi pneumatic for four hours with no pressure loss.
- 3..1.5 Sterilization (Domestic Water System): After tests have been completed, the entire domestic water distribution system shall be thoroughly flushed with water until all entrained dirt and mud have been removed, and shall be sterilized with solutions of either liquid chlorine conforming to Federal Specification BB-B-120 or hypochlorite conforming to Fed. Spec. O-C-114, Type II, Grade G, or Fed. Spec. O-S-602, Grade A or B. The chlorinating material shall provide a dosage of not less than 50 parts per million and shall be introduced into the system in an approved manner, and retained in the system for 8 hours before flushing.
- 3..2 Flashing, Sleeves and Escutcheon Plates:
- 3..2.1 Flashing: Supply flashing for all vent pipe and other types of piping through roof to be installed with roofing. Flash vents with Stoneman S1300-4 or with sheet lead weighing not less than 4 pounds per square foot or equal. Extend flashing into roofing at least 10" from vent and turn flashing over and down into vent opening.
- 3..2.2 Sleeves: Use 20 gauge galvanized steel sleeves around pipes passing through masonry walls and concrete slabs.
- 3..2.3 Escutcheon Plates: Install cast brass split ring with setscrew at all locations where exposed pipes pass through walls, floors and/or ceilings. Provide polished chrome-plated escutcheons in finished rooms, all others polished brass.
- 3...3 Electrical: Wiring by Electrical Contractor.

	PLUMBING FIXTURE SPECIFICATIONS
	DESCRIPTION
WC1	WATER CLOSET (ADA COMPLIANT): FIXTURE: AMERICAN STANDARD 2386.012, 1.6 GALLONS PER FLUSH, 16-1/2" HIGH RIM, FLOOR MOUNT, VITREOUS CHINA, ELONGATED BOWL. SEAT: CHURCH 9500 WHITE OPEN FRONT SEAT WITH CONCEALED CHECK HINGE & WITHOUT COVER. SUPPLIES: EASTMAN C5CR-20-LK, 1/2" x 3/8" ANGLE STOP WITH FLEXIBLE TUBE RISER.
<u>L1</u>	LAVATORY (WALL HUNG- ADA COMPLIANT): FIXTURE: AMERICAN STANDARD, MODEL No. 0355.012, WALL HUNG, 20" x 18" VITREOUS CHINA, FRONT OVERFLOW. PROVIDE CAST-IRON WALL HANGER BOLTED TO WALL. FAUCET: MOEN 8400 SINGLE LEVER DECK MOUNTED FAUCET WITH BLADE TYPE ADA HANDLE. SUPPLIES: EASTMAN C5RC-15-LK, ANGLE STOPS WITH FLEXIBLE TUBE RISERS. WASTE: McGUIRE 155WC OFFSET WHEELCHAIR LAVATORY STRAINER WITH GRID DRAIN, CAST BRASS ELBOW AND OFFSET TAILPIECE. TRAP: McGUIRE 8902, 1-1/4" x 1-1/2" CAST BRASS P TRAP. INSULATE EXPOSED WATER AND WASTE PIPING WITH TRUEBRO LAV-GUARD INSULATION KIT, MODEL 102, WITH ACCESSORY #105.
<u>MS1</u>	MOP SINK: FIXTURE: FIAT MODEL MSB-2424, 24" x 24" x 10", FLOOR MOUNTED, MOLDED STONE WITH INTEGRAL STAINLESS STEEL STRAINER EXTENSION. FAUCET: CHICAGO FAUCET 897 CHROME-PLATED SUPPLY FITTING WITH INTEGRAL STOPS, VACUUM BREAKER, 3/4" HOSE THREAD, FLEXIBLE 3/4" RUBBER HOSE AND HOSE BRACKET; MOP HANGER; SILICONE SEALANT INSTALLED IN ACCORDANCE WITH MANUFACTURER'S RECOMMENDATIONS. TRAP: PROVIDE 2" TRAP.
<u>S-1</u>	SINK ADA COMPLIANT): FIXTURE: JUST MODEL No. SL-ADA-2125-A-GR, 21" x 25" x 5-1/2" DEEP, 18 GAUGE TYPE 304 STAINLESS STEEL, ADA COMPLIANT SELF RIMMING SINGLE COMPARTMENT SINK WITH 3-HOLE PUNCH. FAUCET: AMERICAN STANDARD "RELIANT+" MODEL 4205.000.F15, POLISHED CHROME PLATED DECK MOUNT SINGLE LEVER FAUCET WITH SWING SPOUT, INTEGRAL HOT LIMIT SAFETY STOP. SUPPLIES: EASTMAN C5RC-20-LK, 1/2" x 3/8" ANGLE STOPS WITH FLEXIBLE TUBE RISERS. STRAINER: JUST J-35 BASKET STRAINER WITH 1-1/2" C.P. TAILPIECE. TRAP: McGUIRE 8912, 1-1/2" x 1-1/2" CAST BRASS P-TRAP WITH CLEANOUT PLUG AND ESCUTCHEON. INSULATE ALL EXPOSED UNDERCOUNTER WATER AND WASTE PIPING WITH PLUMBEREX 2003W "HANDY-SHIELD MAXX" INSULATION COMPLYING WITH ASTM E 84-07/UL 723 CLASS A AND BE LISTED WITH AND MEET UPC/IAPMO. INSULATION MATERIAL SHALL BE U/V INHIBITED WITH ANTIMICROBIAL AND ANTIFUGAL PROPERTIES.
НВ	HOSE BIBB (FREEZE PROOF): WOODFORD MODEL No. MB65, CHROME PLATED FINISH, 3/4" HOSE CONNECTION WITH INTEGRAL VACUUM BREAKER, SELF-DRAINING, LOOSE TEE OPERATOR, ENCLOSED IN A FLUSH MOUNTED 14 GAUGE STAINLESS STEEL WALL BOX WITH LOCKABLE COVER.
<u>WH-1</u>	ELECTRIC WATER HEATER: PPROVIDE UL LISTED ELECTRIC WATER HEATER OF SIZE, CAPACITY AND MAKE AS SCHEDULED. HEATER SHALL BE WARRANTED FOR A MINIMUM OF 5 FULL YEARS AFTER FINAL ACCEPTANCE OF THE BUILDING. FURNISH HEATER WITH THE FOLLOWING ACCESSORIES: 1. ASME COMBINATION TEMPERATURE AND PRESSURE RELIEF VALVE RATED IN EXCESS OF HEATER INPUT. RUN FULL SIZE DRAIN TO TERMINATE AS SHOWN ON DRAWINGS. 2. AUTOMATIC THERMOSTAT ACTUATED CONTROLS WITH 100% SHUTOFF. 3. HIGH—LIMIT CONTROLS. 4. TANK DRAIN. 5. BRASS NIPPLES FOR PIPE CONNECTIONS. 6. HEATER SHALL BE FACTORY INSULATED AND SHEET METAL JACKETED.
<u>DF-1</u>	DRINKING FOUNTAIN (ADA COMPLIANT): FIXTURE: MDF MODEL No. 480EZWMSS, WALL MOUNTED BARRIER FREE DRINKING FOUNTAIN, NON-REFRIGERATED, ONE PIECE TYPE 304 SCHEDULE 10 STAINLESS STEEL, WELDED CONSTRUCTION WITH 18 GAUGE POLISHED STAINLESS STEEL RECEPTOR BOWL, STAINLESS STEEL ANTI-SQUIRT BUBBLER HEAD (MOUNTED WITH LOCK NUT AND WASHER TO PREVENT TAMPERING), STAINLESS STEEL PUSH BAR AND HOUSING. ALL WORKING PARTS ACCESSIBLE THROUGH BOWL OF FOUNTAIN. UNIT FURNISHED WITH WATER SUPPLY (REINFORCED NYLOBRAID TUBING, LEAD-FREE AND NSF-61 CERTIFIED WITH 1/2" MIP THREADED INLET WITH STAINLESS STEEL STRAINER). PROVIDE WITH STAINLESS STEEL FITTINGS AND VALVES. UNIT FURNISHED COMPLETE WITH WALL CARRIER PLATE FOR ANCHORING TO A FINISHED WALL. MOUNT AT WHEELCHAIR HEIGHT- REFER TO ARCHITECTURAL DRAWINGS FOR FIXTURE MOUNTING HEIGHT.
<u>IM</u>	ICE MAKER BOX: SPECIALTY PRODUCTS MODEL P4129, WITH ADJUSTABLE FRAME AND VALVE.

ELECTRIC WATER HEATER SCHEDULE								
MARK	MANUFAC.	MODEL	STORAGE CAPACITY IN GALS.	KW INPUT	VOLTAGE/ PHASE	GALLON PER HR. REC. AT 100° F T.R.	WATER OUTLET TEMP F	REMARKS
WH-1	A.O. Smith	DEL-65	6	1.5	120/1	6.2	140	

FIXTURE CONNECTION SCHEDULE							
MARK	DESCRIPTION	TRAP SIZE	WASTE	VENT	COLD WATER	HOT WATER	REMARKS
WC-1	WATER CLOSET (ADA)	INT.	3"	2"	1/2"	_	FLUSH TANK, 1.6 GPF, FLOOR MTD.
L-1	LAVATORY (ADA)	1-1/4" x 1-1/2"	2"	1-1/2"	1/2"	1/2"	WALL MOUNTED
S-1	SINK (ADA)	1-1/2"	1-1/2"	1-1/2"	1/2"	1/2"	SINGLE COMPARTMENT
MS-1	MOP SINK	2"	2"	1-1/2"	1/2"	1/2"	FLOOR TYPE
DF-1	DRINKING FOUNTAIN (ADA)	1-1/4" x 1-1/2"	1-1/2"	1-1/2"	1/2"	_	NON-REGRIGERATED
HB-1	HOSE BIBB	-	_	_	3/4"	_	NON-FREEZE TYPE W/ VACUUM BREAKER

WATER CALCULATION: FIXTURE UNITS = 86 FU / 40 GPM	
PIPE LENGTH TAP TO METER PIPE LENGTH METER TO LAST FIXTURE VERTICAL PIPE LENGTH TO HIGHEST FIXTURE TOTAL PIPE LENGTH FITTING LOSS (10%)	10 FT. 294 FT. 5 FT. 309 FT. <u>31 FT.</u>
TOTAL DEVELOPED LENGTH	340 FT
WATER PIPE SIZING CRITERIA	
STREET PRESSURE WATER METER LOSS (1") BACKFLOW PREVENTER LOSS (1") STATIC LOSS (5' x 0.43) FIXTURE LOSS	65.00 PSI* 8.50 PSI 12.00 PSI 2.20 PSI <u>20.00 PSI</u>
PRESSURE AVAILABLE FOR PIPING	22.30 PSI
22.30 PSI / 340 FEET x 100 = 6.6 PSI MAXIMUM A PER 100 FEET PIPE	
*ASSUMED WATER PRESSURE— CONTRACTOR SHALL VE	ERIFY ACTUAL WATER

PRESSURE EXCEEDS 80 PSI, A PRESSURE REDUCING VALVE SHALL BE PROVIDED. PIPING VELOCITY NOT TO EXCEED 8 FEET PER SECOND. BRANCH PIPE SIZING CHART FOR 6.6 PSI LOSS

PIPE SIZE

1/2" 3/4"

1-1/4"

PRESSURE PRIOR TO CONSTRUCTION. IF PRESSURE IS LESS THAN 65 PSI,

CONTRACTOR SHALL CONTACT ENGINEER FOR PIPE SIZING EVALUATION. IF


G.P.M.

F.U.(TANK)

23

47

			TZ			
	FIXTURE U	NIT (CALC	ULAT	IONS	3
	DESCRIPTION	OTV	F.U. E		TOTAL F.U.	
		QTY	WASTE	WATER	WASTE	WATER
	WATER CLOSET (F.T.)	2	4	5	8	10
	LAVATORY	2	1	2	2	4
	MOP SINK	1	2	3	2	3
	DRINKING FOUNTAIN	1	1	1	1	1
	FUTURE FIXTURES					68

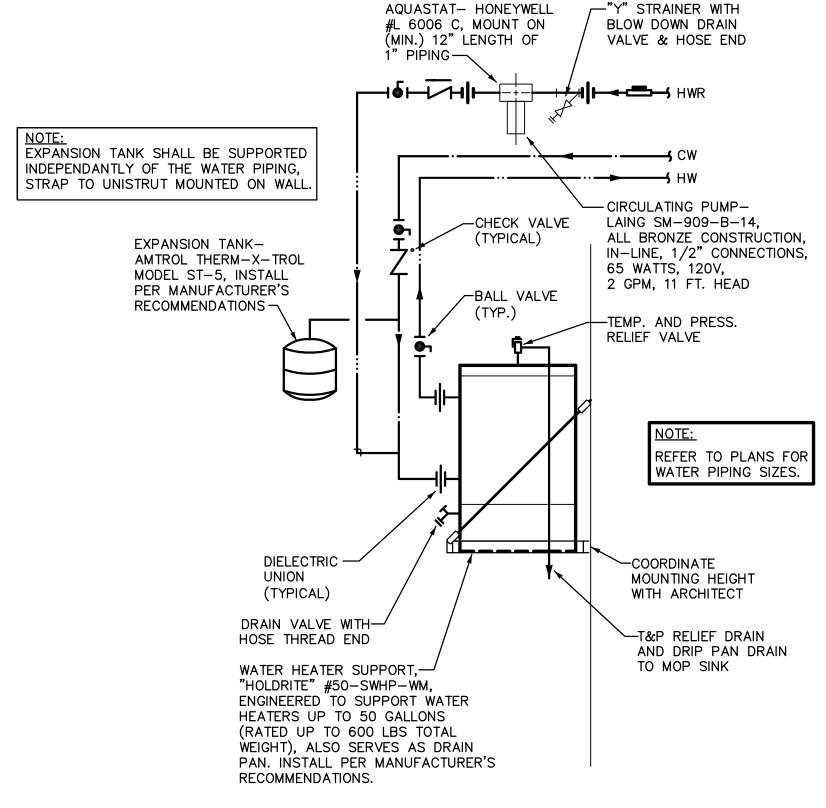


WATER HEATER DETAIL

Design Group, LLC Consulting Engineers 611 West Delano Ave Prescott, AZ 86301 Project Surprise, AZ 85379

(602) 499.0001 #24027 (623) 444-6143

REVISIONS

These drawings are the property of W. Alan Kenson & Associates P.C.. and may not be reproduced in any way without the written consent of W. Alan Kenson & Associates, P.C.

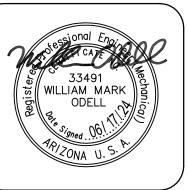


U S

()

(

PRO

DRAWN BY CHECKED BY DATE March 6th, 2024 JOB NO. 799

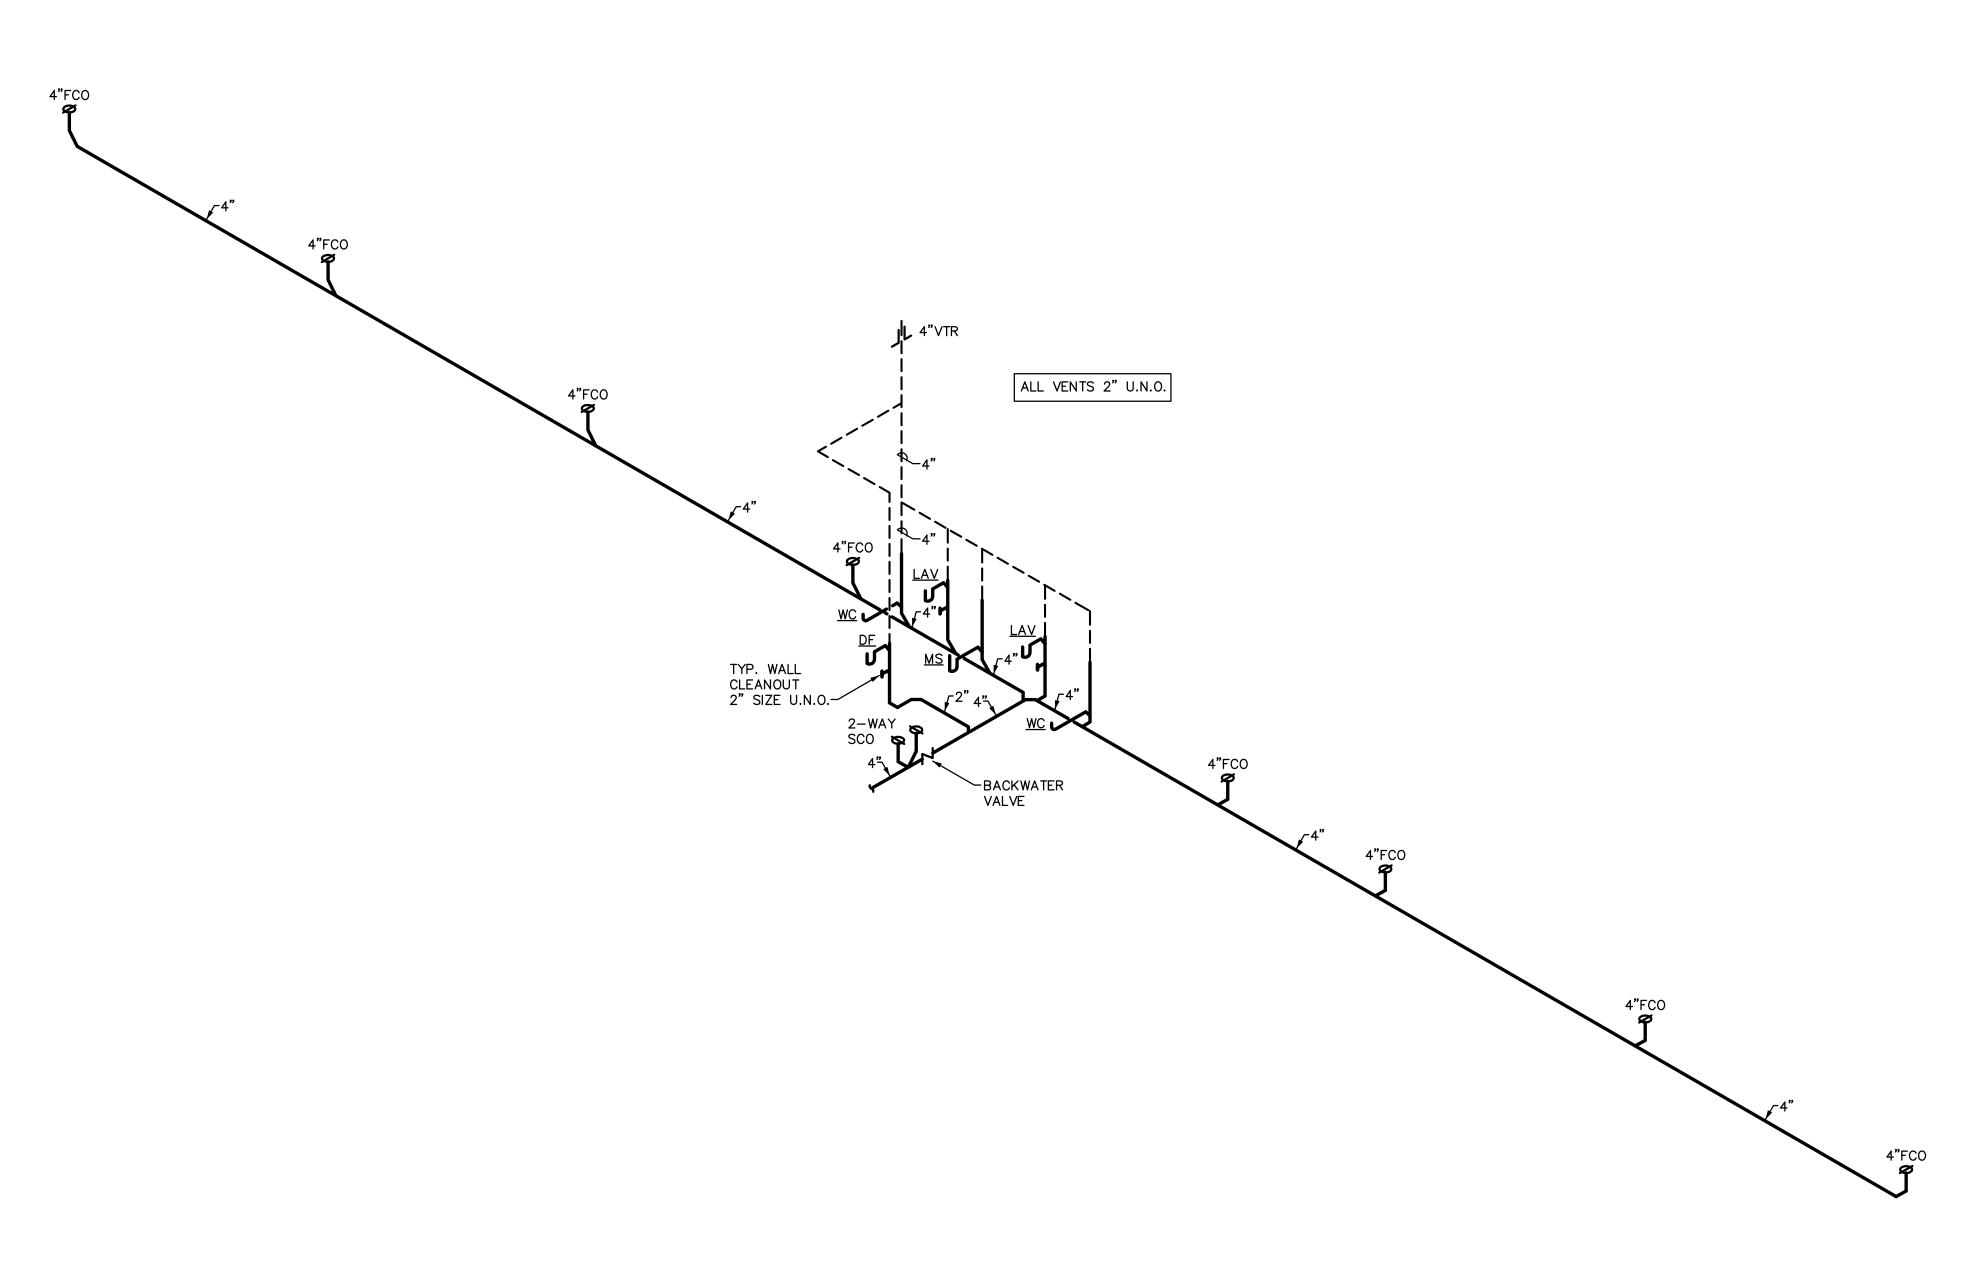

WASTE AND VENT SCHEMATIC




REVISIONS

These drawings are the property of W. Alan Kenson & Associates P.C., and may not be reproduced in any way without the written consent of W. Alan Kenson & Associates, P.C.

CHECKED BY

DATE March 6th, 2024

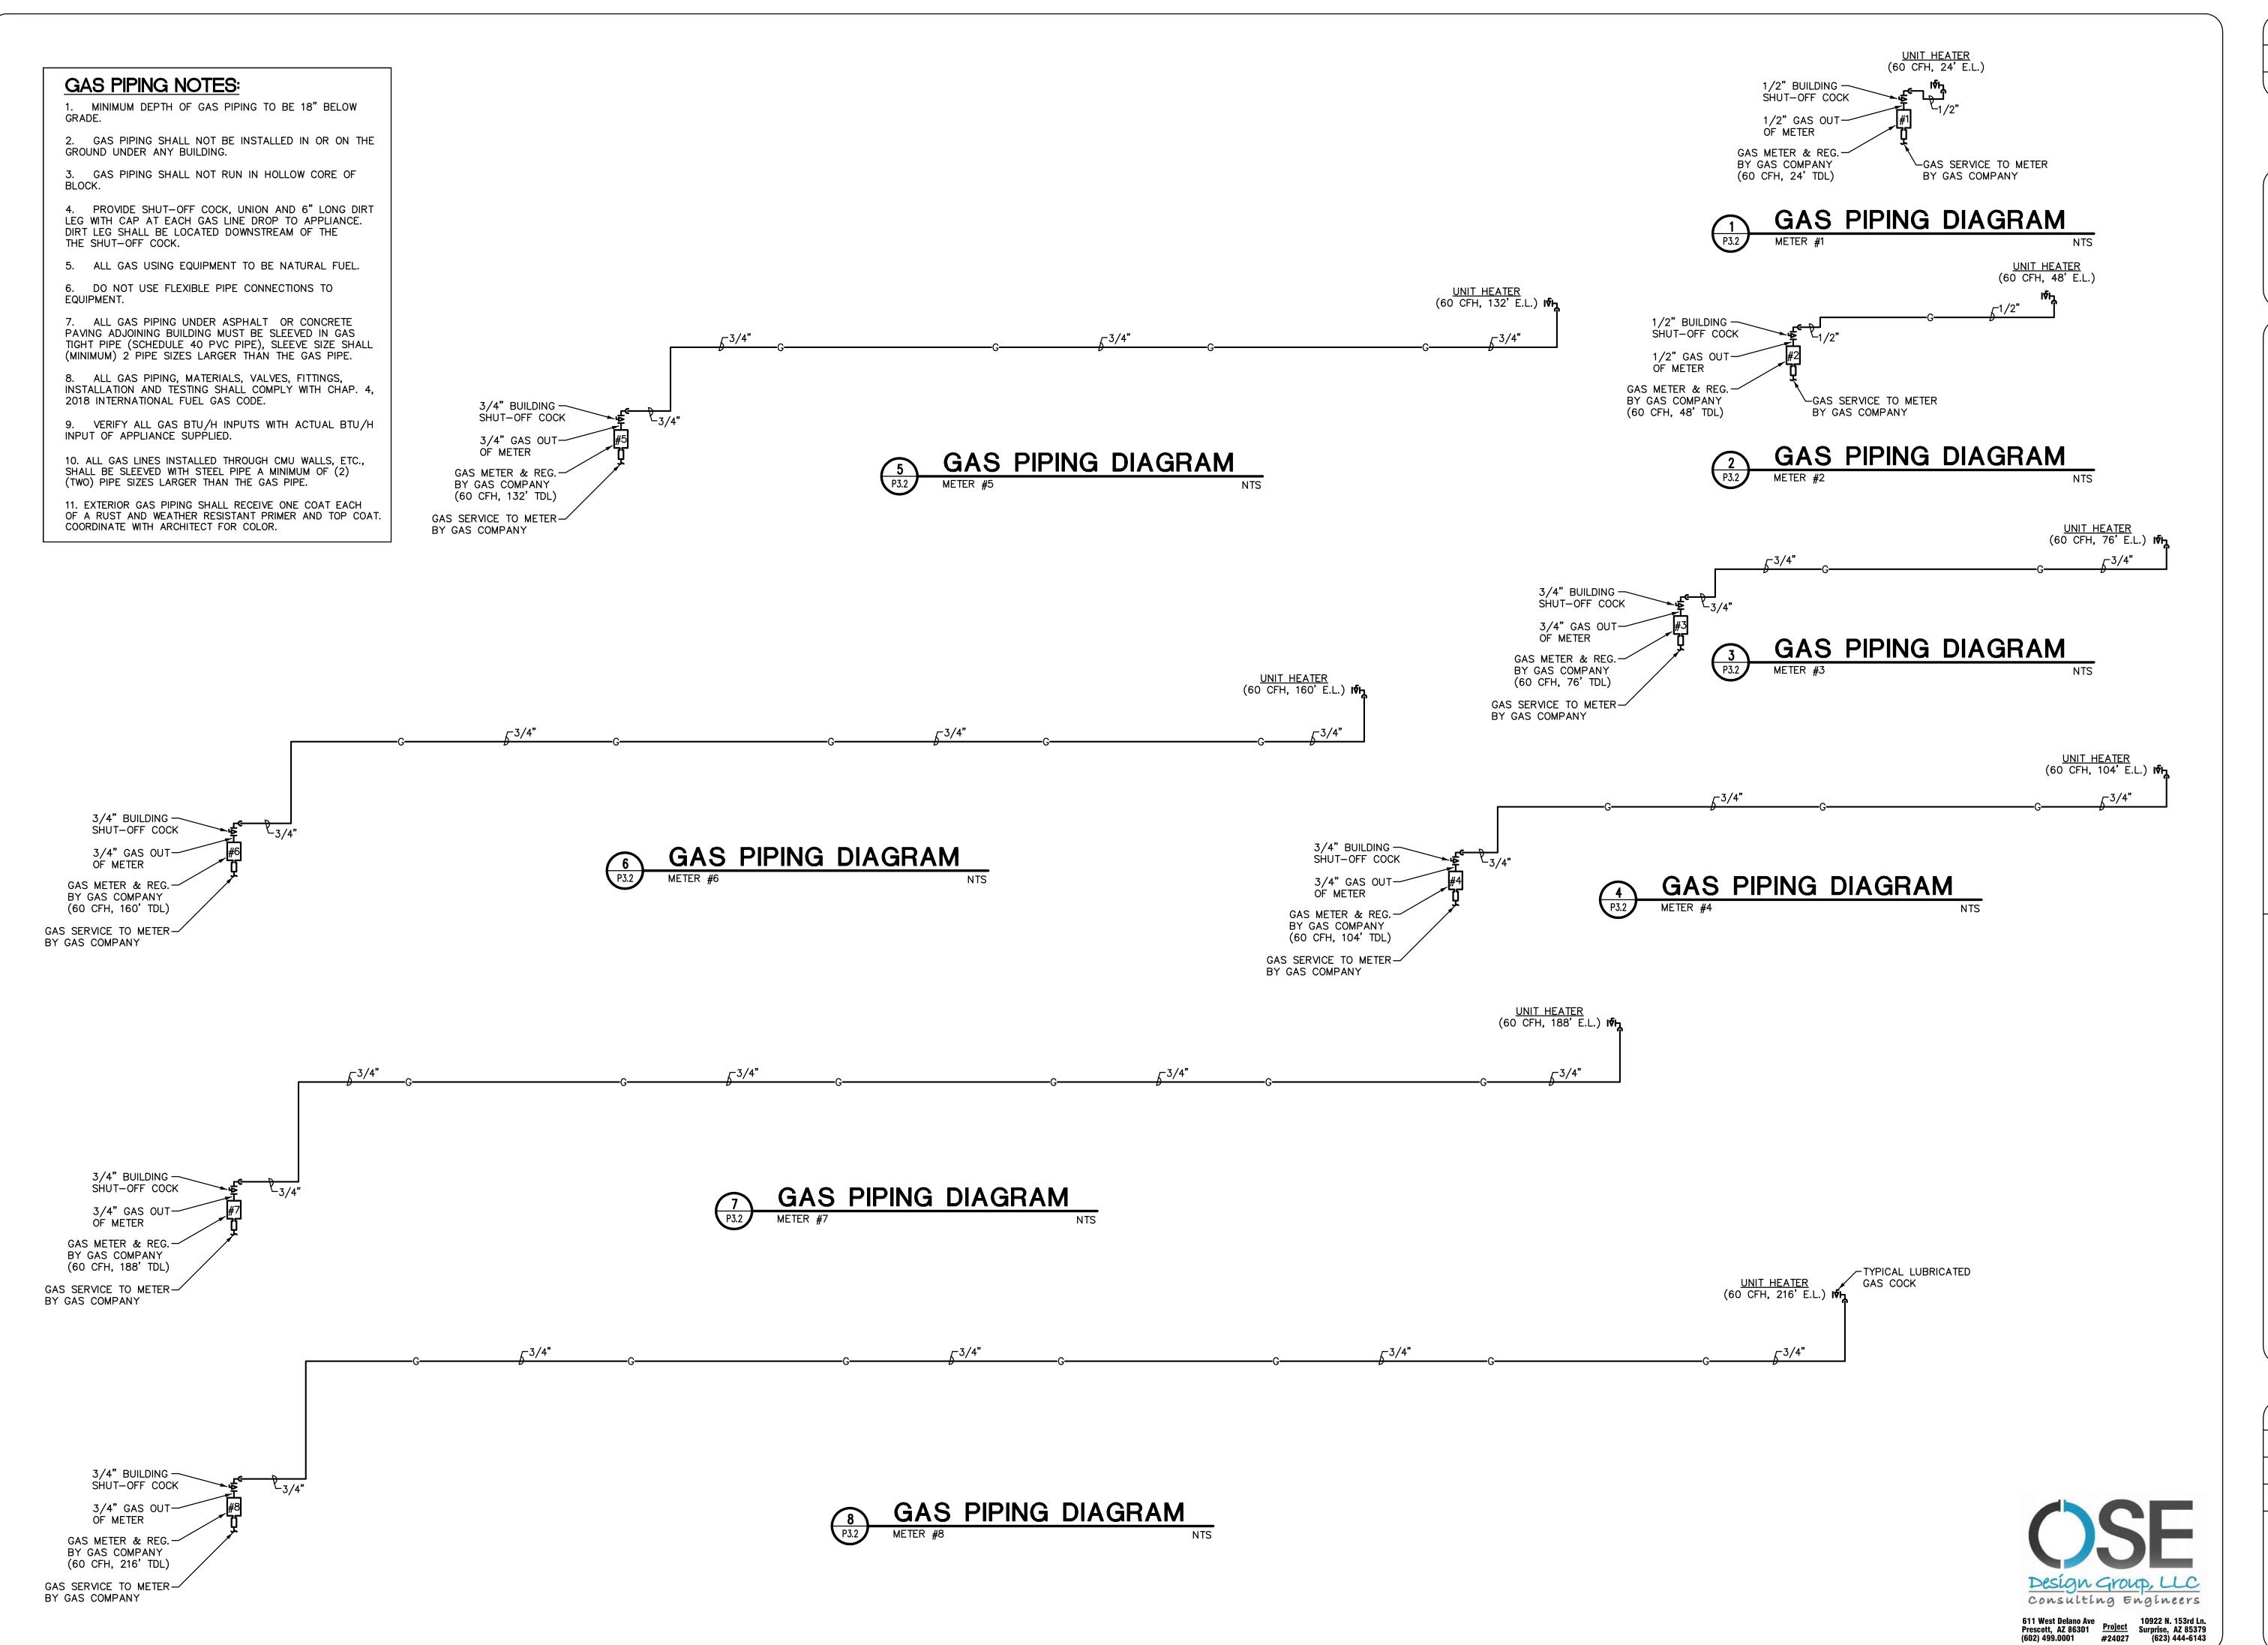

REVISIONS BY

These drawings are the property of W. Alan Kenson & Associates P.C., and may not be reproduced in any way without the written consent of W. Alan Kenson & Associates, P.C.



ARIZONA U.S.

SSociates, P

P.O. Box 11593
Prescott, AZ 86304
sableone.net

Son

8-443-5815 Pro email: waka@cabled www.kenson-associa

P 928-443
F 928-444

JSC Contracting Building B 6601 Inter Cal Way
Prescott, AZ 86301

PROJECT: JSC C

DRAWING:

DRAWN BY

CHECKED BY

DATE

March 6th 202

DATE March 6th, 2024 JOB NO. 799 SHEET

P3.2

||OUTLET MOUNTING HEIGHTS PER AMERICAN DISABILITY ACT

ELECTRICAL CONTRACTOR SHALL COMPLY WITH THE 2010 ADA SAD REQUIREMENTS FOR ALL SWITCHES. RECEPTACLES, TELE./DATA AND SIDE REACH CONTROL SWITCHES ALL WALL CONTROLS, SWITCHES AND THERMOSTATS TO BE MOUNTED WITH TOP OF J-BOX AT 48" A.F.F. ALL ABOVE COUNTER CONTROLS. SWITCHES & OUTLETS TO BE MOUNTED WITH HORIZONTAL ORIENTATION WITH TOP OF J-BOX AT 44" A.F.F.. ALL WALL OUTLETS TO BE MOUNTED AT 15" A.F.F. TO BOTTOM OF J-BOX.

SPECIAL REQUIREMENTS PER: THE FAIR HOUSING ACT.

ALL RECEPTACLES AT RESTROOM LAVATORIES TO BE GFCI TYPE. ALL WALL CONTROLS, SWITCHES AND THERMOSTATS TO BE MOUNTED WITH TOP OF J-BOX AT 48" A.F.F. ALL ABOVE COUNTER CONTROLS. SWITCHES & OUTLETS TO BE MOUNTED WITH HORIZONTAL ORIENTATION WITH TOP OF J-BOX AT 44" A.F.F. ALL WALL OUTLETS TO BE MOUNTED AT 15" A.F.F. TO BOTTOM OF J-BOX.

ELECTRICAL DESIGN & CADD SERVICES INC. 1600 LAMB LANE PRESCOTT, AZ. 86305 PH. (928) 776-4900 FAX (928) 776-7800 E-MAIL: EES@CABLEONE.NET

FIRE WALL/FLOOR PENETRATION

ALL PENETRATIONS OF FIRE RESISTIVE FLOORS OR SHAFT WALLS SHALL BE PROTECTED BY MATERIALS AND INSTALL-ATION DETAIL THAT CONFORM TO UNDERWRITERS LABOR-ATORY'S LISTINGS FOR THROUGH PENETRATION FIRESTOP SYSTEMS. THE CONTRACTOR SHALL SUBMIT SHOP DRAWING DETAILS WHICH SHOW COMPLETE CONFORMANCE WITH THE LISTING TO THE ARCHITECT AND SUCH DRAWINGS SHALL BE AVAILABLE TO THE LOCAL GOVERNING INSPECTORS. THE DRAWINGS SHALL BE SPECIFIC FOR EACH PENETRATION WITH ALL VARIABLES DEFINED.

FIRE ALARM SYSTEM SPECIFICATION

A COMPLETE OPERATIONAL MANUAL/AUTOMATIC FIRE ALARM SYSTEM TO BE MONITORED AS DIRECTED BY OWNER SHALL BE FURNISHED AND INSTALLED AS REQUIRED FOR THIS TYPE OF BUILDING IN ACCORDANCE WITH STATE AND/OR LOCAL CODE AND AS APPROVED BY THE CODE ENFORCING AUTHORITY HAVING JURISDICTION. THE FIRE ALARM CONTROL PANEL SHALL BE LOCATED AS DIRECTED BY THE ENFORCING AUTHORITY. (CONNECT TO CIRCUIT LA-15). FIRE ALARM CONTRACTOR SHALL PROVIDE SPEC'S., DRAWINGS OF DEVICE LOCATIONS AND CUT SHEETS OF DEVICES TO FIRE MARSHALL FOR APPROVAL PRIOR TO INSTALLATION.

ONE LINE GENERAL NOTES

- 1. SYSTEM SHOWN IS A TWO TIER SERIES RATED SYSTEM 65/10K. MANUFACTURER SHALL PROVIDE A UL LISTED SYSTEM TO MATCH THIS RATING.
- 2. MOTOR SHORT CIRCUIT CONTRIBUTION IS LESS THAN 1% OF SYSTEM SHORT CIRCUIT AMPS.
- 3. NO DESIGN CHANGES MAY BE MADE TO THE SYSTEM WITHOUT THE PRIOR APPROVAL OF THE DESIGN ELECTRICAL ENGINEER AND THE ELECTRICAL INSPECTOR

ONE LINE KEYNOTES.

- (1) PROVIDE A PERMANENT LABEL READING "THIS CIRCUIT FUSE IS PART OF A SERIES RATED SYSTEM WITH DOWNSTREAM PANELS 65/10K. 65,000 AMPS AVAILABLE. IDENTIFIED RÉPLACEMENT COMPONENT REQUIRED"
- (2) PROVIDE A PERMANENT LABEL READING "CAUTION-SERIES RATED SYSTEM 65/10K, AMPS AVAILABLE, IDENTIFIED

200/3

ELEC. LOAD CALCULATIONS

		<u>ØA</u>	<u>ØB</u>	<u>ØC</u>
PANEL	'HP' (HOUSE PANEL)	32.5 A	26.6 A	57.5 A
PANEL	'BA' (ESTIMATED)	125.0 A	125.0 A	125.0 A
PANEL	'BB'	125.0 A	125.0 A	125.0 A
PANEL	BC,	125.0 A	125.0 A	125.0 A
PANEL	,BD,	125.0 A	125.0 A	125.0 A
PANEL	'BE'	125.0 A	125.0 A	125.0 A
PANEL	'BF'	125.0 A	125.0 A	125.0 A
PANEL	'BG'	125.0 A	125.0 A	125.0 A
PANEL	'BH'	125.0 A	125.0 A	125.0 A
TOTAL	CODE LOAD =	1032.5 A	1026.6 A	1057.5 A

200/3

200/3

DRAWN B CHECKED BY A.O. DATE March 6th, 2024 JOB NO. **799** SHEET

STUB-OUT -STUB-OUT -STUB-OUT -STUB-OUT ---STUB-OUT ---4#3/0, 1#6 — U.G. 2.5" E.C. GND. IN 2.5" C. 本 AMPS. **FUTURE FUTURE** FUTURE **FUTURE FUTURE FUTURE** FUTURE **FUTURE** PNL. 'HP' PNL. 'BE PNL. 'BF' PNL. 'BA' PNL. 'BB' PNL. 'BC' PNL. 'BD' PNL. 'LG' PNL. 'LH' - #4 BC

200/3

200/3

200/3

BLDG. 'B' ELECTRICAL ONE - LINE DIAGRAM

N.T.S.

UFER

#3/0 CU___

 $^{\prime}$

CW/GAS

-UNDERGROUND SERVICE

SECONDARY. ELECTRICAL

AS DIRECTED BY APS.

CONTRACTOR TO PROVIDE

CONDUIT, TRENCH & BACKFILL

ABBREVIATIONS

ABOVE FINISHED FLOOR (¢ OF OUTLET) ABOVE FINISHED GRADE (¢ OF OUTLET)

NEW UNDERGROUND

SERVICE PRIMARY—

- **EMPTY CONDUIT** GROUND FAULT INTERRUPTER
- **WEATHERPROOF** UNO UNLESS OTHERWISE NOTED
- **NIGHT LIGHT** TYP TYPICAL
- EDF ELECTRIC DRINKING FOUNTAIN
- TELEPHONE MOUNTING BOARD

ate

C

0

()

S

REVISIONS

These drawings are the property of

W. Alan Kenson & Associates P.C.

and may not be reproduced in any

way without the written consent of

W. Alan Kenson & Associates, P.C


ANGELO

OSSANNA.

EXPIRES 12/30/2024

0 **(**)

a

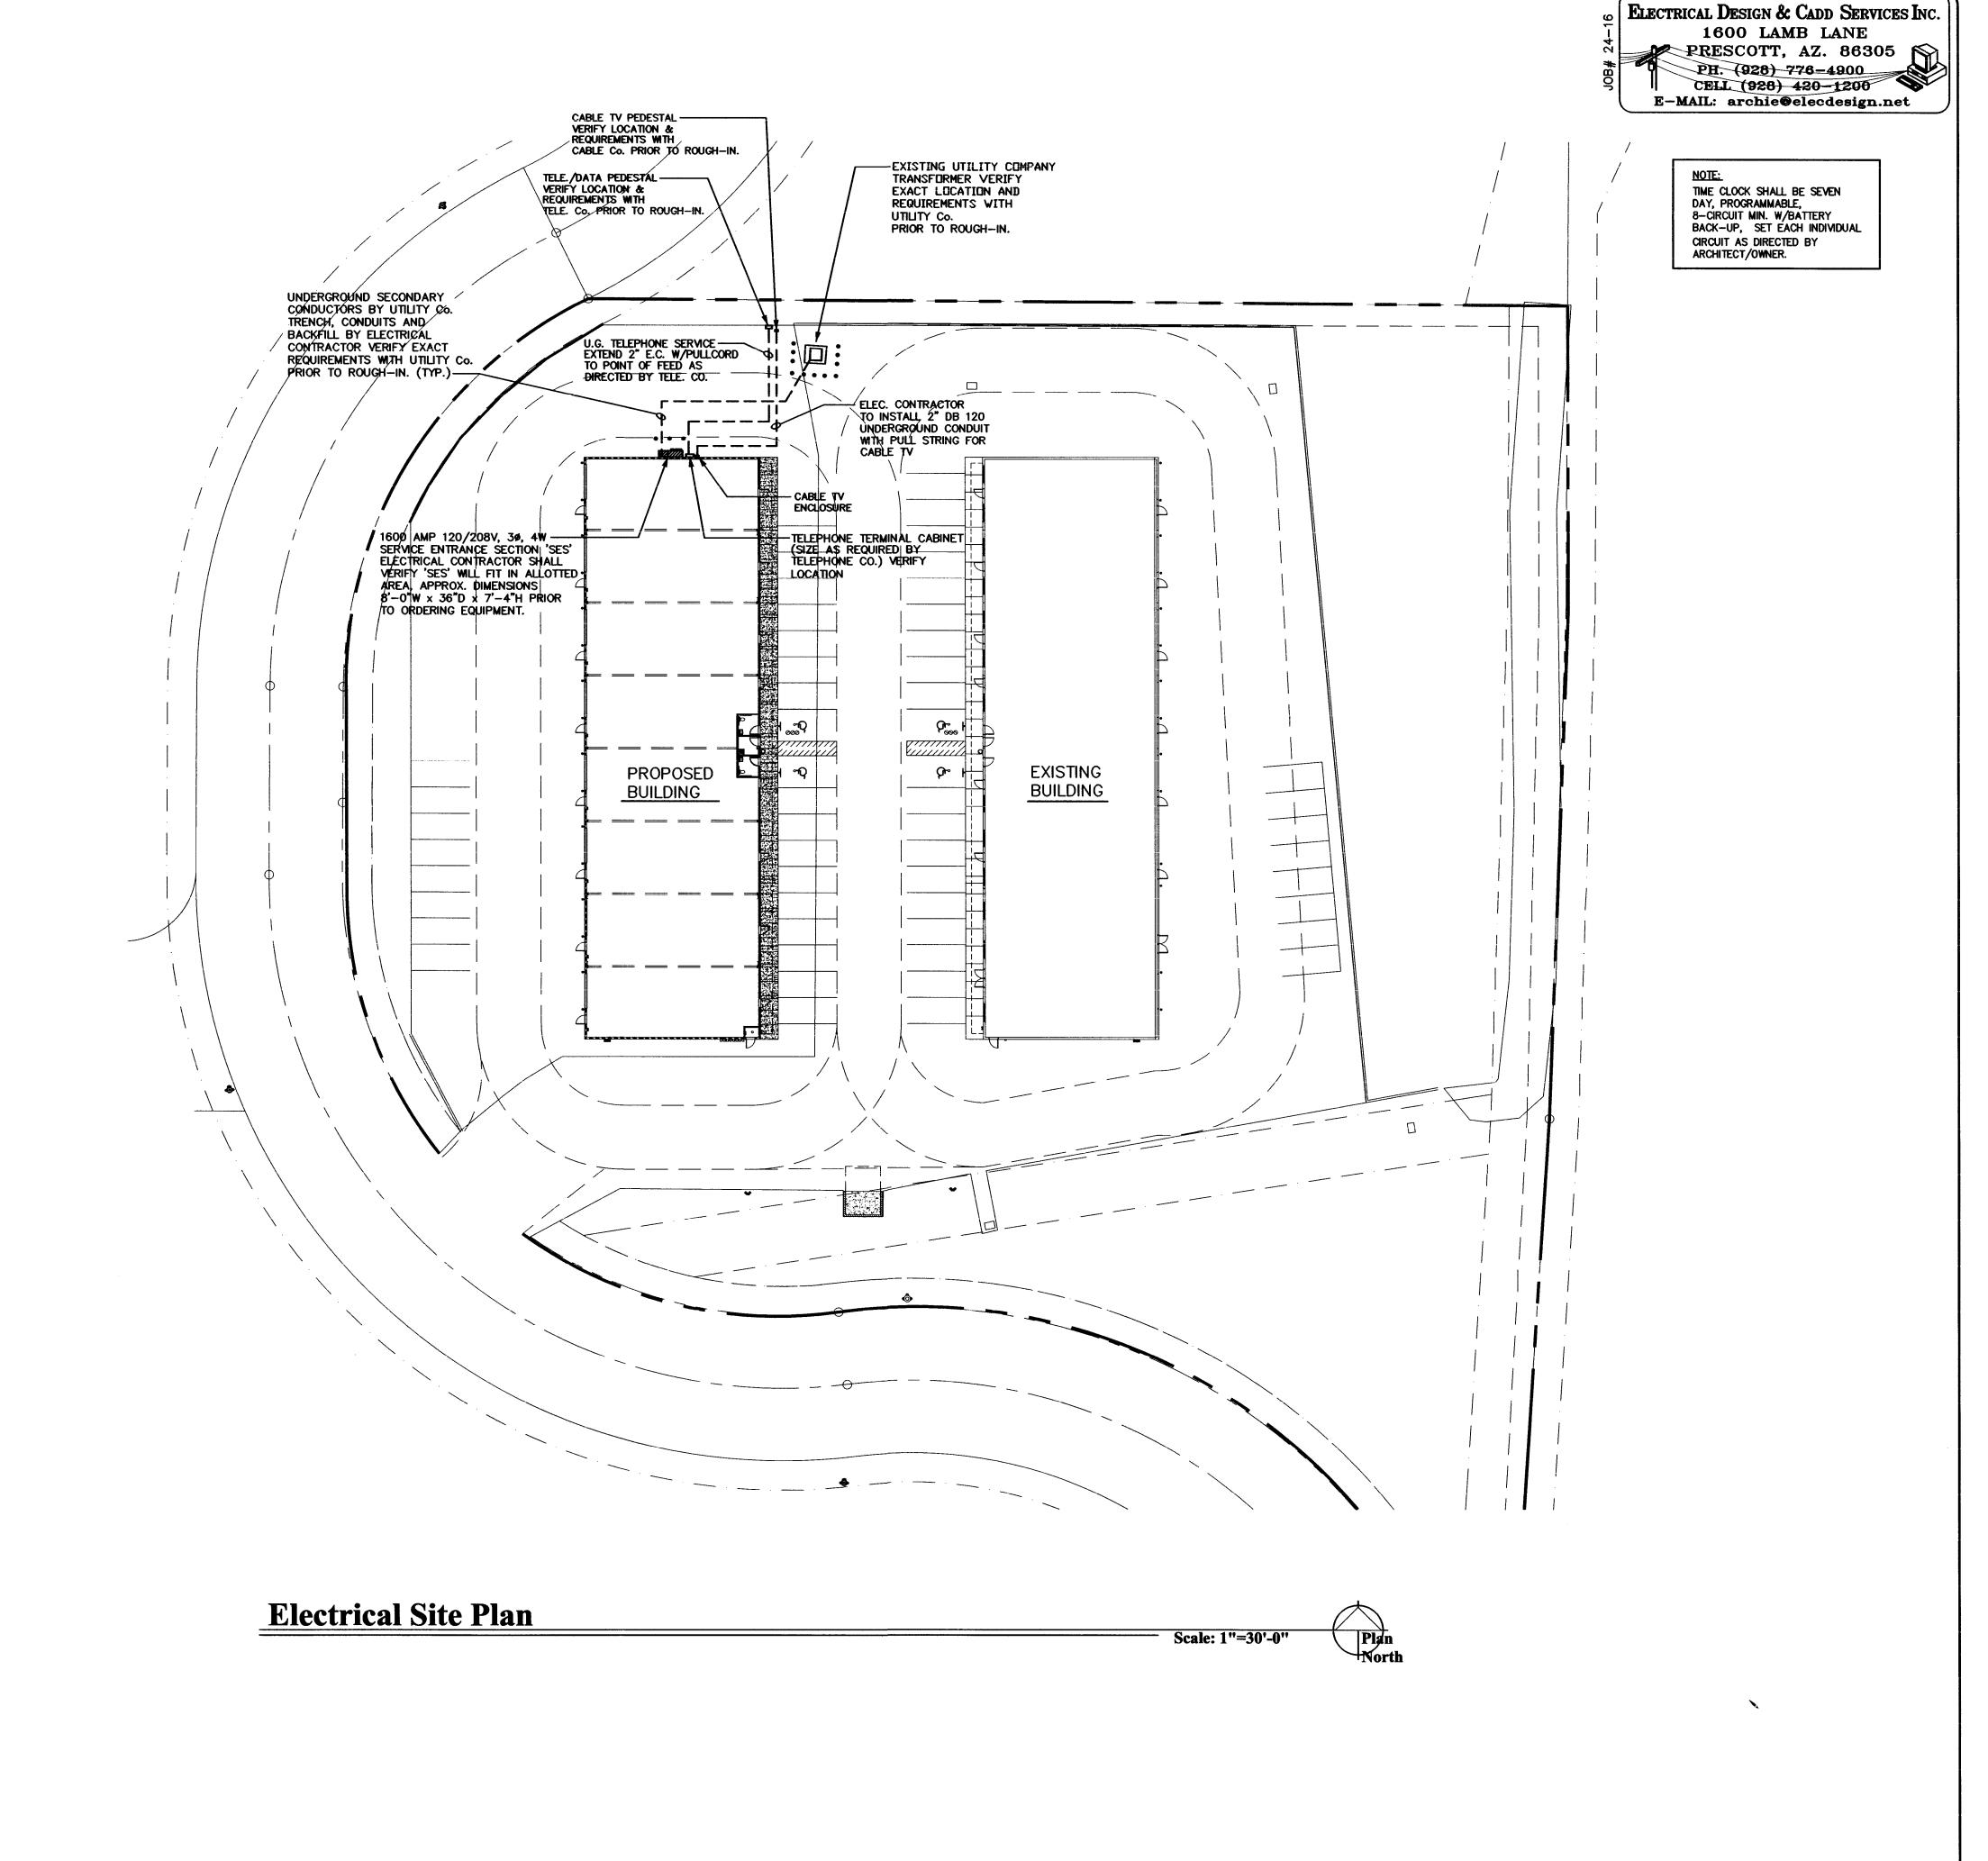

REVISIONS

These drawings are the property of W. Alan Kenson & Associates P.C., and may not be reproduced in any way without the written consent of W. Alan Kenson & Associates, P.C.




Associates,

Kenson
-5812 P.O.
-5815 Pres

Alan
P 928-443-

DATE March 6th, 2024

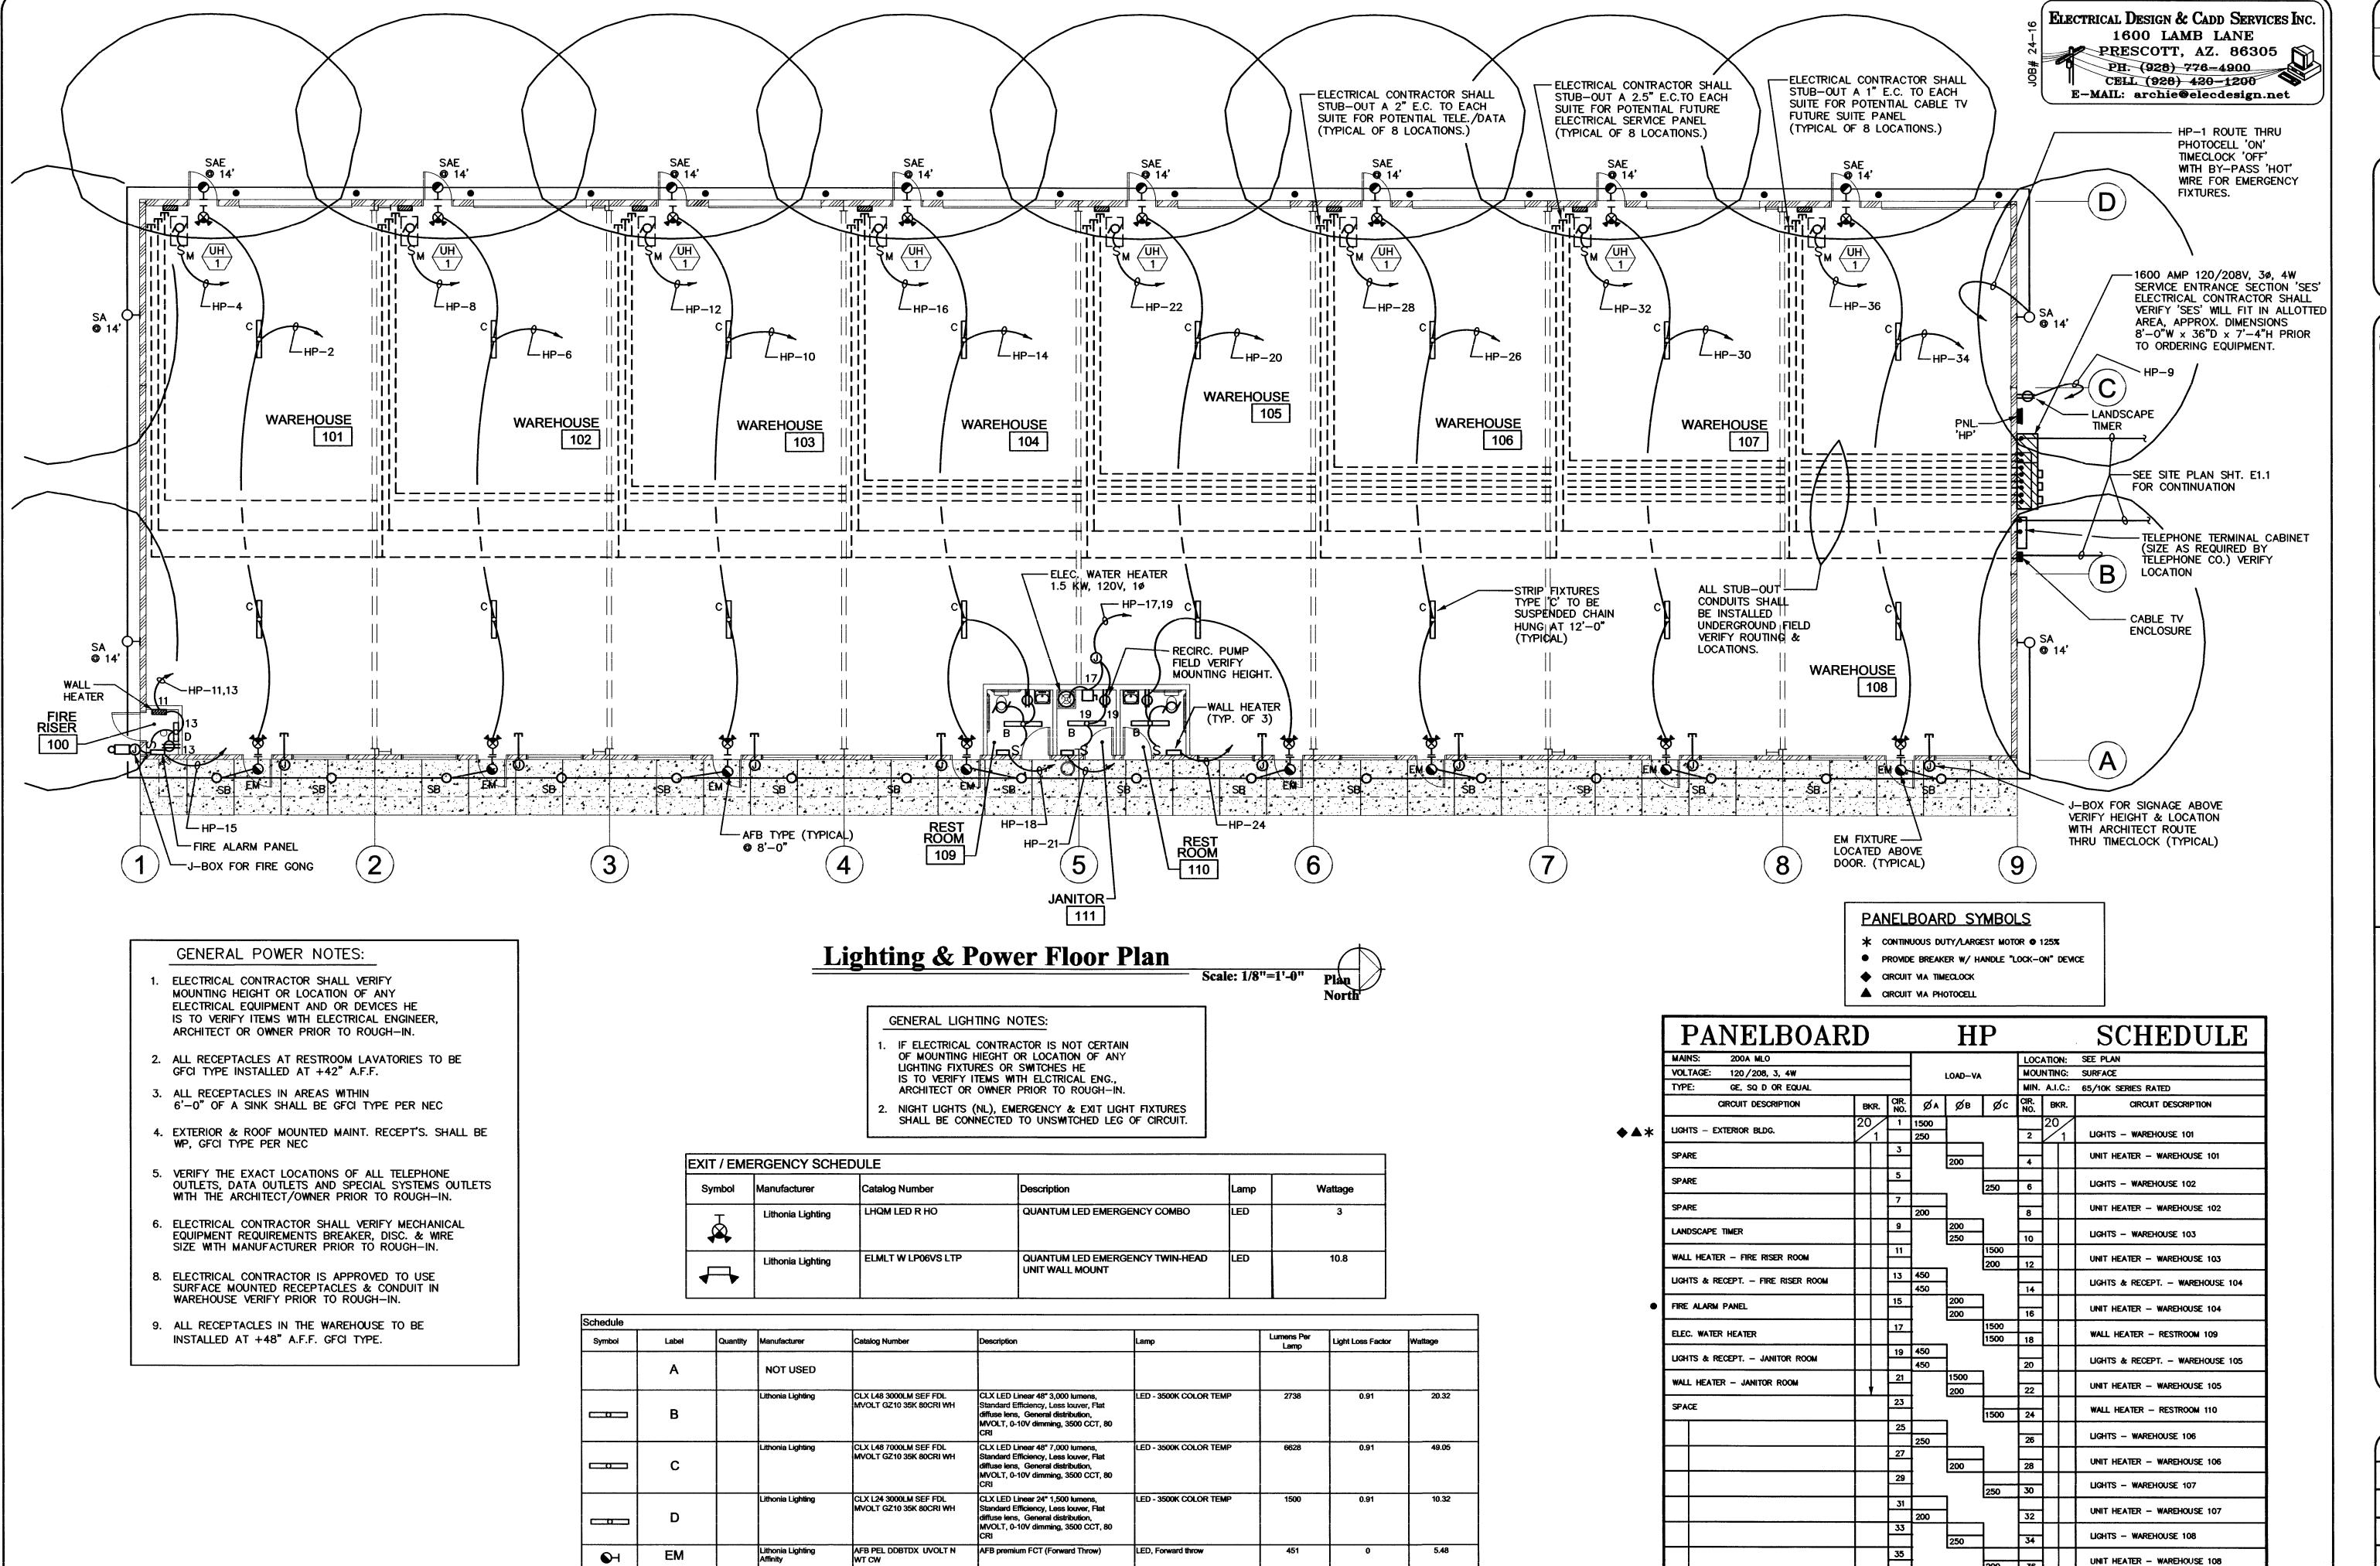

WDGE1 LED P1 30K 80CRI VW

WDGE1 LED P1 30K 80CRI VW

LDN6 30/07 LO6AR LSS MVOLT

MVOLT SRM E4WH (FINISH)

MVOLT SRM (FINISH)

ithonia Lighting

Lithonia Lighting

ithonia Lighting

SA

SB

ОН

 \bigcirc H

0

WDGE1 LED WITH P1 - PERFORMANCE LED - 3000K

VDGE1 LED WITH P1 - PERFORMANCE | LED - 3000K

8IN LDN, 3000K, 750LM, CLEAR, SEMI- LED - 3000K

PACKAGE, 3000K, 80CRI, VISUAL

PACKAGE, 3000K, 80CRI, VISUAL

SPECULAR REFLECTOR, CRI80

COMFORT WIDE OPTIC

COMFORT WIDE OPTIC


10.0002

10.0002

TOTAL LOAD PER PHASE:

REVISIONS

hese drawings are the property of W. Alan Kenson & Associates P.C., and may not be reproduced in any way without the written consent of

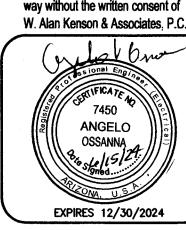

DRAWN BY R.A. CHECKED BY A.O. DATE March 6th, 2024

SPARE

SPARE

SPARE

HI# 6900 / 120 = 57.5 AMPS

JOB NO. **799**